



J-72-0 SH. 5

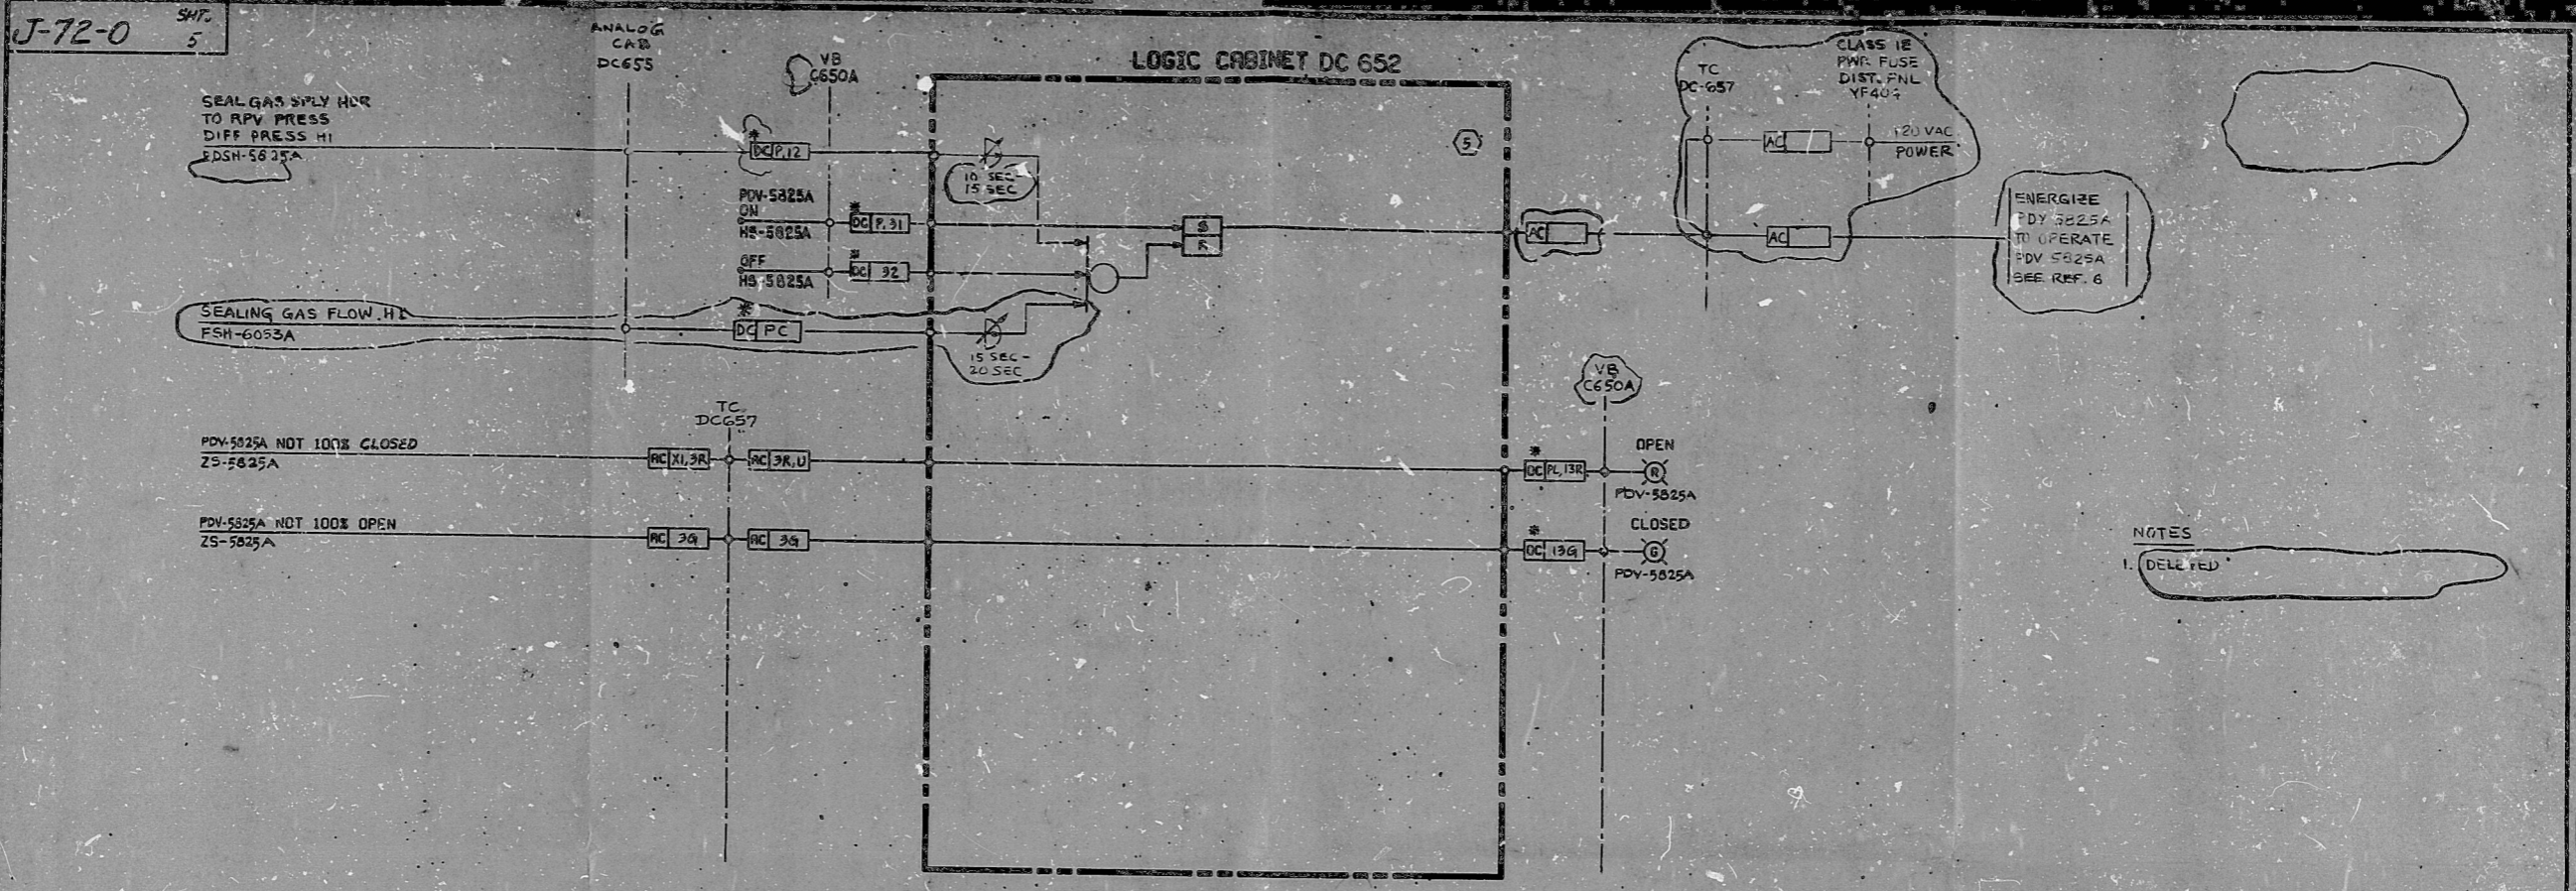

MSIV INBD SEAL GAS SPLY V PDV-5825A  
CLASS 1E - CHANNEL D

CROSS REFERENCE TABLE

VALVE NO.	SERVICE	HAND SWITCH	POSITION SWITCH	CLASS 1E CHANNEL	LOGIC CABINET	TERM. CABINET	CKT NO.	ANALOG CABINET	PRESS SWITCH NO.	FLOW SWITCH NO.
PDV-5825A	INBD SEAL GAS SUPPLY	HS-5825A	ZS-5825A	D	DC652	DC657	5	DC655	PD5H-5825A	FSH-6053A
PDV-5825B	OUTBD SEAL GAS SUPPLY	HS-5825B	ZS-5825B	C	CC652	CC657	6	CC655	PD5H-5825B	FSH-6053B

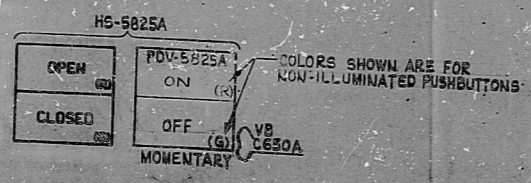

NOTES  
1. DELETED

PRO APERTURE CARD

DESIGN FREEZE ISSUE					
CHANGED BAILEY INTERFACE AS LISTED	1/10/77				
INCORPORATED REVISIONS SHOWN ON DGN 1 & 2 ISSUED FOR CONSTRUCTION	9/11/77				
NO. DATE	REVISIONS	BY	CHKD	APP'D	DATE

BECHTEL  
SAN FRANCISCO

PUBLIC SERVICE ELECTRIC AND GAS COMPANY  
HOPE CREEK GENERATING STATION

LOGIC DIAGRAM  
MSIV SEALING SYSTEM

MSIV INBD & OUTBD SEAL GAS SPLY VALVES

JOB NO.	DRAWING NO.	REV.
10855	J-72-0 SH. 5	3 Q

S/U - KP

This drawing is the property of Bechtel. It is to be used only for the project and site for which it was prepared. It is not to be reproduced, copied, loaned, or used in any way without the written consent of Bechtel.

RIDS

8307250150

