



J-72-0 SHT. 11

This drawing and the design it covers are the property of BECHTEL. They are hereby loaned, and on the borrower's account, and shall not be reproduced, copied, issued, exhibited, or used except in the limited way and private use permitted by any written consent given by the lender to the borrower.

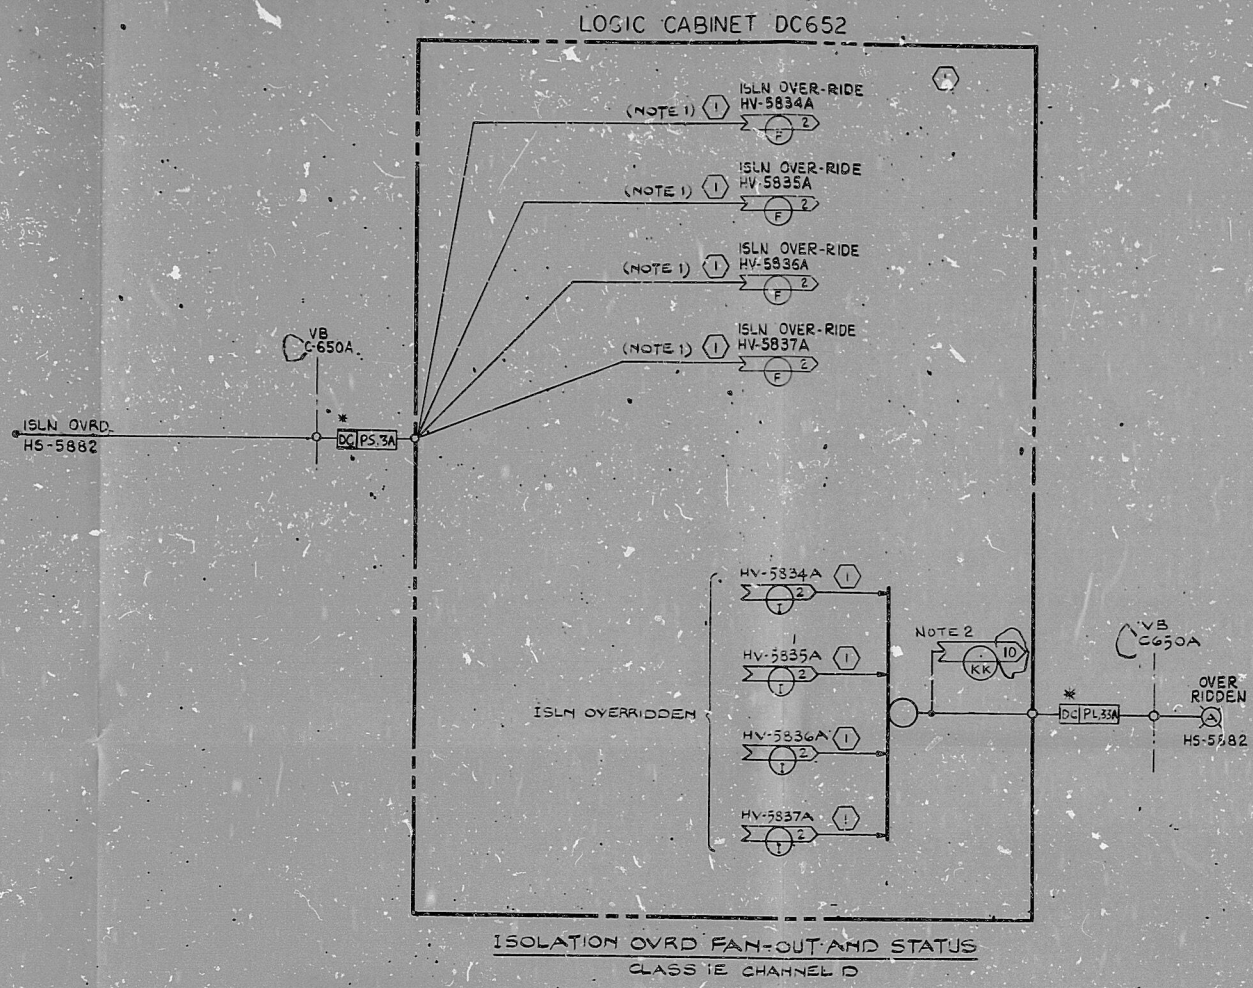

ISLN OVRD FAN-OUT AND STATUS
CLASS 1E CHANNEL D

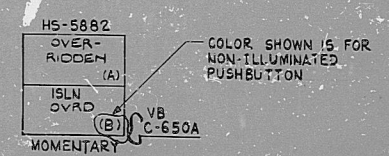

NOTES

1. ISLN OVRD OUTPUTS TO SHEET 2 VALVE CONTROL LOGIC SHALL BE HARDWIRED.
2. THE LOGIC CABINET OUTPUT DRIVER CONTACT SHALL OPEN ON ALARM CONDITION.

PRO APERTURE CARD

△	DESIGN FREEZE ISSUE				
△	REVISED BAILEY INTERFACE AND AS NOTED	4/11/77	AK	AK	AK
△	INCORPORATED REVISIONS SHOWN ON DCN # 1	7/27/77	AK	AK	AK
△	ISSUED FOR CONSTRUCTION	1/13/78	AK	AK	AK
NO.	DATE	REVISION	BY	CHECKED	APPROVED

SCALE: NONE DESIGNER: LGD DRAWN: BD/C

BECHTEL
SAN FRANCISCO

PUBLIC SERVICE ELECTRIC AND GAS COMPANY
HOPE CREEK GENERATING STATION

LOGIC DIAGRAM
MSM SEALING SYSTEM
ISLN OVRD FAN-OUT AND STATUS

JOB No.	DRAWING No.	REV.
10855	J-72-0-SHT 11	3 Q

S/UJ - KP

RIDs

8307250160

