



J-57-0 SHT. 12

This drawing and the design it covers are the property of BECHTEL. They are hereby loaned and on the borrower's express agreement that they will not be reproduced, copied, loaned, exhibited, nor used except in the limited way and under the terms permitted by any written consent given by the lender to the borrower.

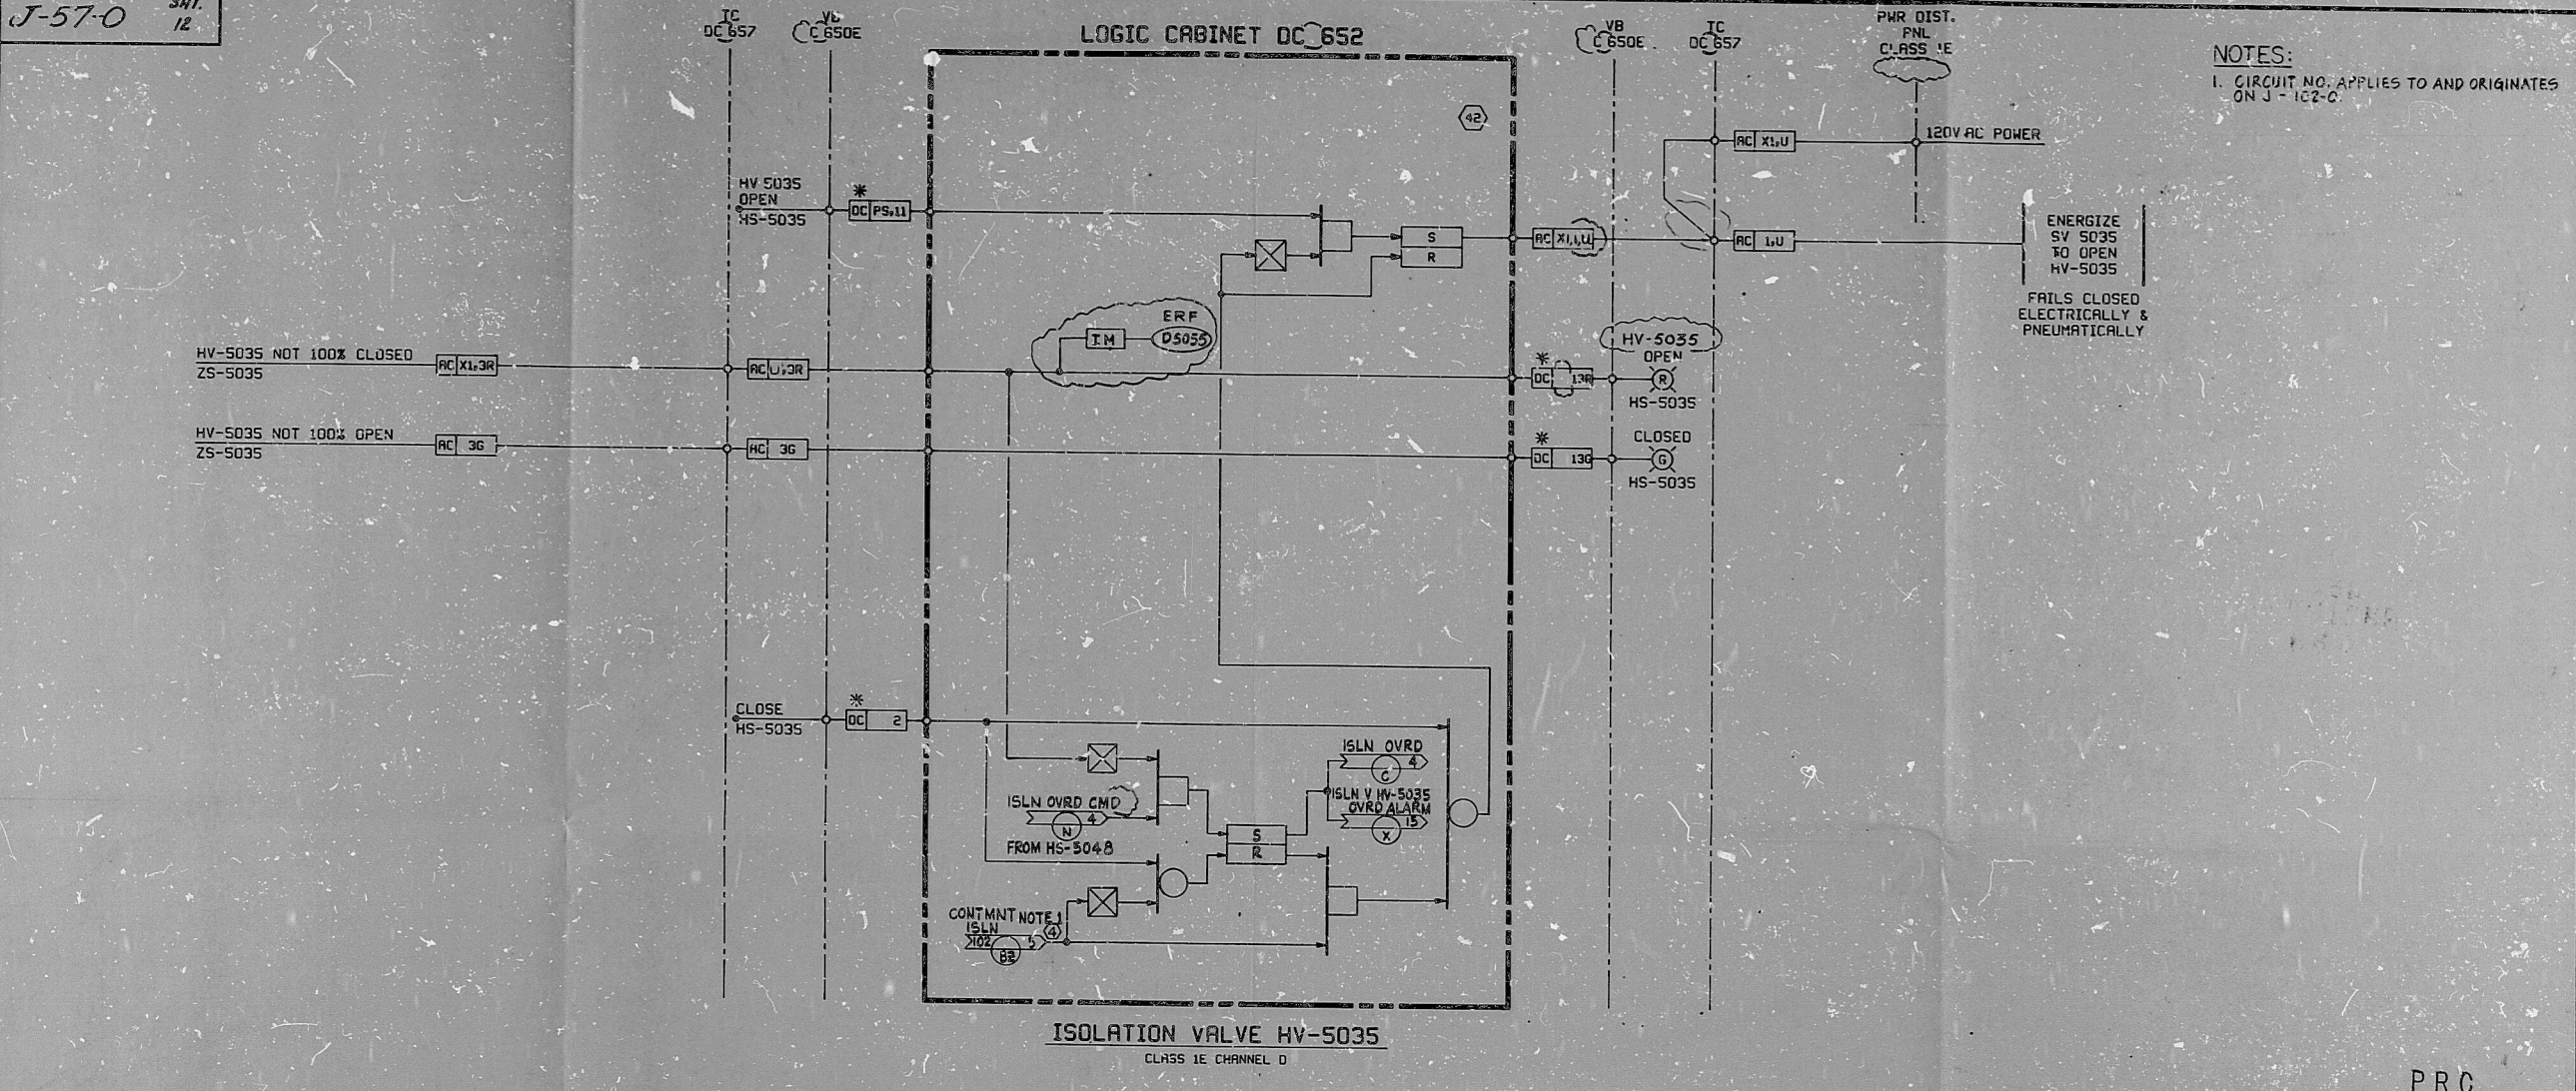

NOTES:
 1. CIRCUIT NO. APPLIES TO AND ORIGINATES ON J-1C2-C.

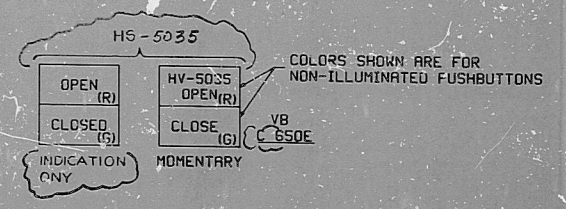

PRC APERTURE CARD

△									
△	4/1/72	DESIGN FREEZE ISSUE							
△	11/1/72	INC DC 1 #3							
△	11/1/72	REVISED AS NOTED							
△	11/1/72	ISSUED FOR CONSTRUCTION							
FILE	DATE	REVISIONS	BY	CHKD	SUPV	ENGR	DRWG	APPV	
SCALE	NONE	DESIGNED	RMK	DRAWN	RCC				
BECHTEL SAN FRANCISCO									
PUBLIC SERVICE ELECTRIC AND GAS COMPANY HOPE CREEK GENERATING STATION									
LOGIC DIAGRAM CONTAINMENT ATMOSPHERE CONTROL REACTOR BLOC N ₂ SUPPLY ISLN VALVE									
	JOB No.	DRAWING No.	REV.						
	10855	J-57-0	SHT 12	3	Q				

S/U - KH

3718 NON-ROOM-750 240

22 x 34 1/2" SIZE

RIDs

8307250186

