



J-57-0 SHT. 13

LOGIC CABINET DC 652

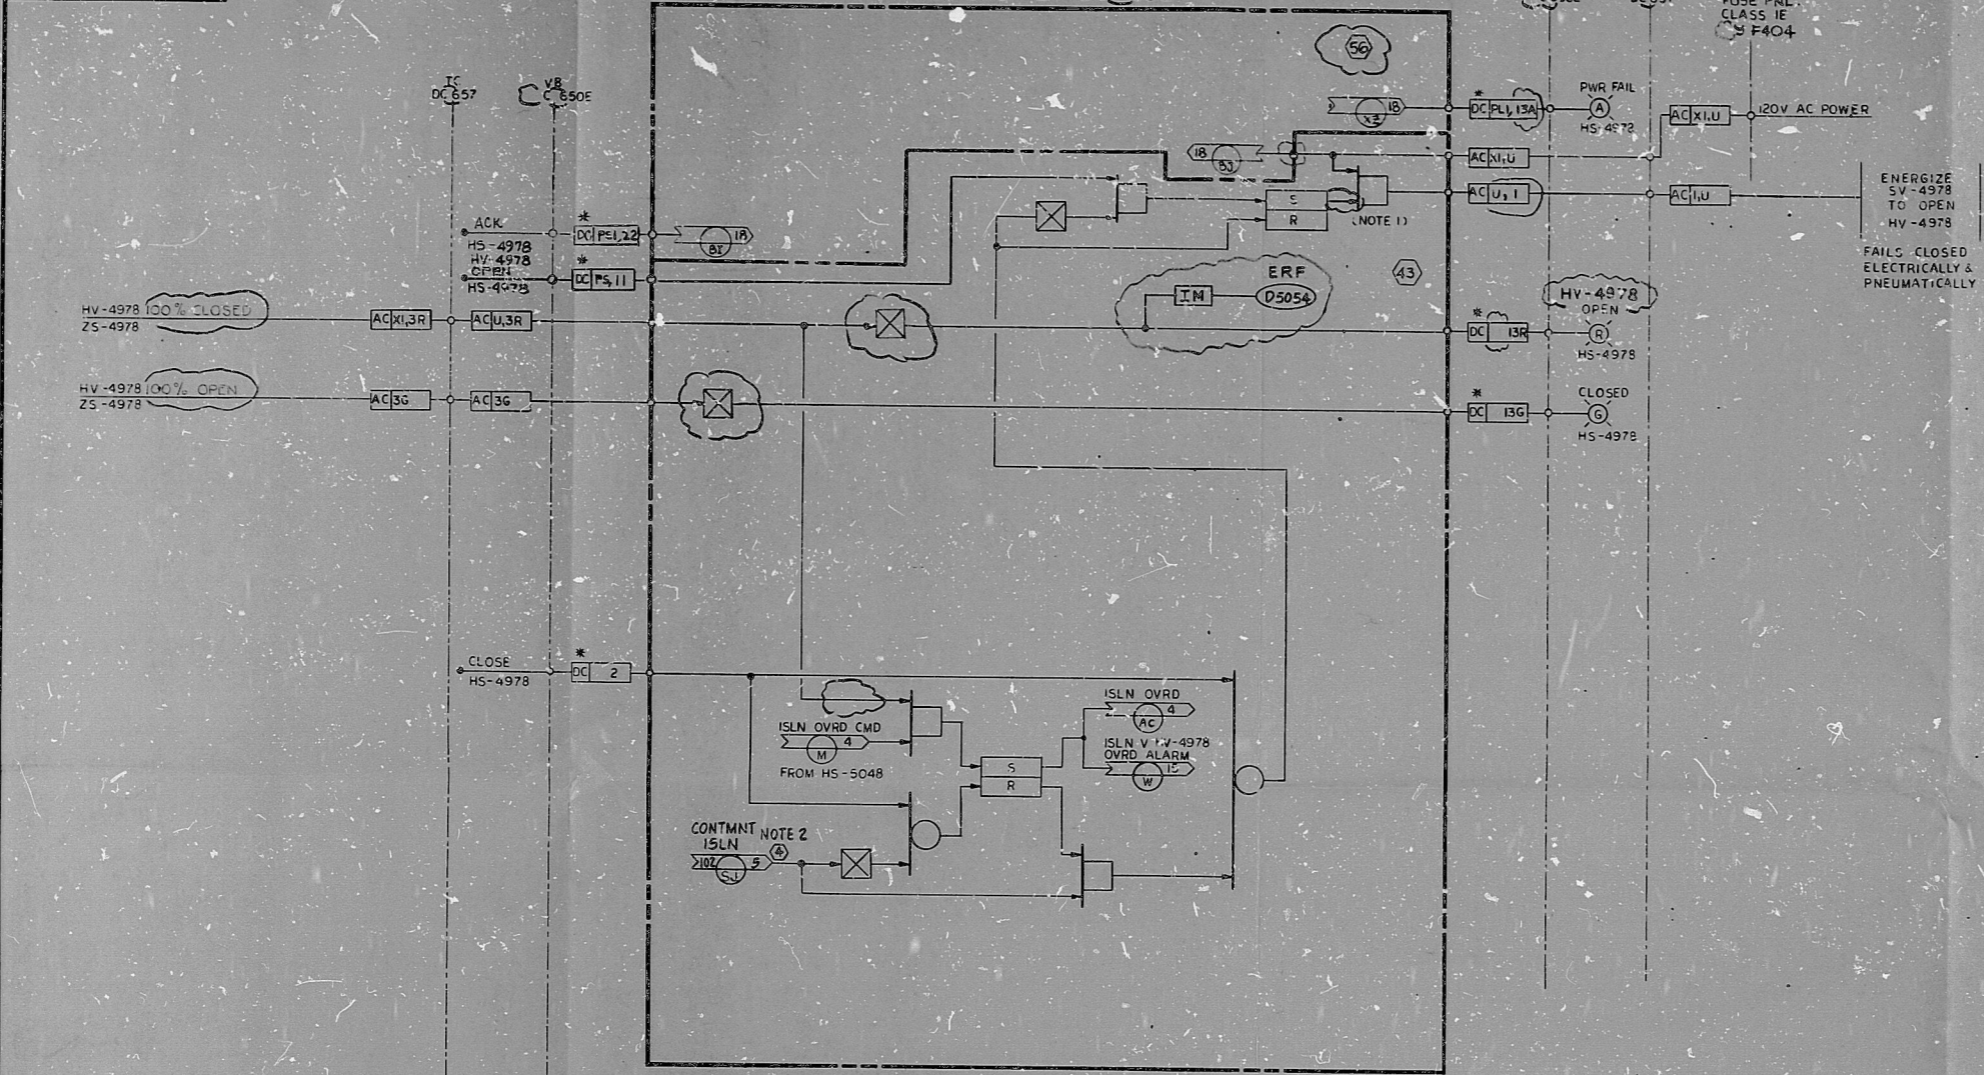

- NOTES:
1. THIS "AND" GATE IS FORMED BY A CONTACT OF THE OUTPUT RELAY WHICH SWITCHES POWER SUPPLIED BY WIRE NO. XE.
 2. CIRCUIT NO. APPLIES TO AND ORIGINATES ON J-102-0.

This drawing and the design it covers are the property of BECHTEL. They are hereby loaned and as the borrower's express agreement that they will not be reproduced, copied, loaned, exhibited, nor used except in the limited way and private use permitted by any written consent given by the lender to the borrower.

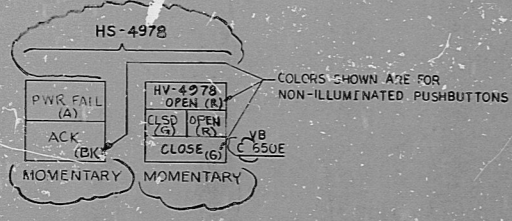

P.R.C. APERTURE CARD

4/1/73	DESIGN FREEZE ISSUE	SM	SM	SM	SM	SM	SM	SM	SM
1/24/73	REVISED BALES INTERFACE AS NOTED	SM	SM	SM	SM	SM	SM	SM	SM
4/1/73	INC DCN # 3	SM	SM	SM	SM	SM	SM	SM	SM
4/1/73	REVISED AS NOTED	SM	SM	SM	SM	SM	SM	SM	SM
4/1/73	ISSUED FOR CONSTRUCTION	SM	SM	SM	SM	SM	SM	SM	SM
No.	DATE	REVISIONS	BY	CHEK	DESIGN	ENGR	FRZE	APPV	
SCALE	NONE	DESIGNED	SMA	DRAWN	BD				
BECHTEL SAN FRANCISCO									
PUBLIC SERVICE ELECTRIC AND GAS COMPANY HOPE CREEK GENERATING STATION									
LOGIC DIAGRAM CONTAINMENT ATMOSPHERE CONTROL REACTOR BLDG. N2 SUPPLY ISLN VALVE									
JOB No.		DRAWING No.		REV.		SHT 13		4 Q	
10855		J-57-0							

SU-65

RIDS

8307250188

