


J-57-0 SHT 15

This drawing was prepared by the design engineer under the supervision of the design engineer and on the contractor's express agreement that they will not be reproduced, copied, loaned, exhibited, or used except in the limited way and places permitted by any written contract given by the holder to the borrower.

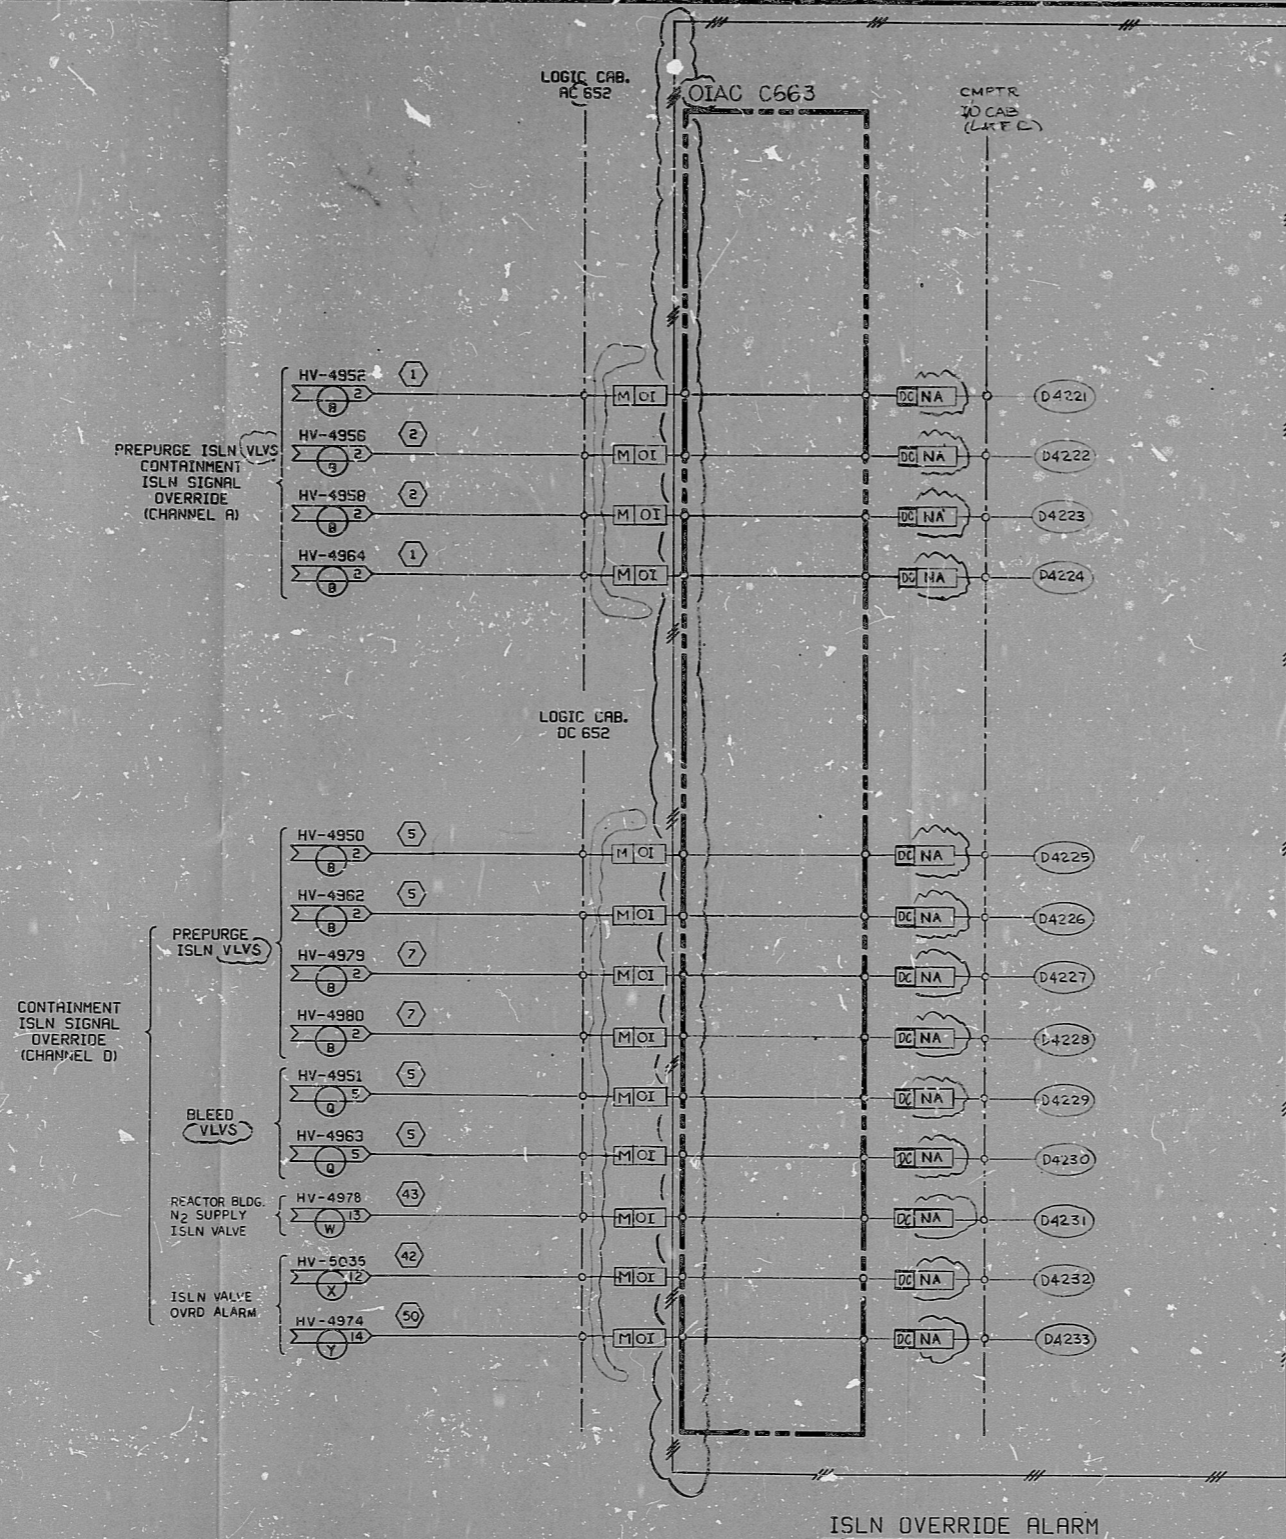

NOTES:
DELETED

PRG
APERTURE
CARD

DESIGN	DESIGN FREEZE ISSUE	DATE	BY	CHKD	DESIGN	APPV
REVISED	REVISED BAILEY INTERFACE AND AS NOTED	12/27/71	SM	SM	SM	SM
REVISED	ING DCN #3	1/2/72	SM	SM	SM	SM
REVISED	REVISED AS NOTED	1/2/72	SM	SM	SM	SM
ISSUED	ISSUED FOR CONSTRUCTION	1/2/72	SM	SM	SM	SM

SCALE: NONE

DESIGNED: FMK

DRAWN: RCG

BECHTEL
SAN FRANCISCO

PUBLIC SERVICE ELECTRIC AND GAS COMPANY
HOPE CREEK GENERATING STATION

LOGIC DIAGRAM
CONTAINMENT ATMOSPHERE CONTROL
PREPURGE CLEANUP ISLN OVERRIDE ALARM

JOB No.	DRAWING No.	REV.
10955	J-57-0 SHT 15	4 Q

S/U - GS

378 KOB-INOR-750 2M

22 x 34 "D" SIZE

RIDS

8307250190

