


**A LOOP 63 LON XMTS**  
(ALL THE POINTS MARKED WITH 'A')

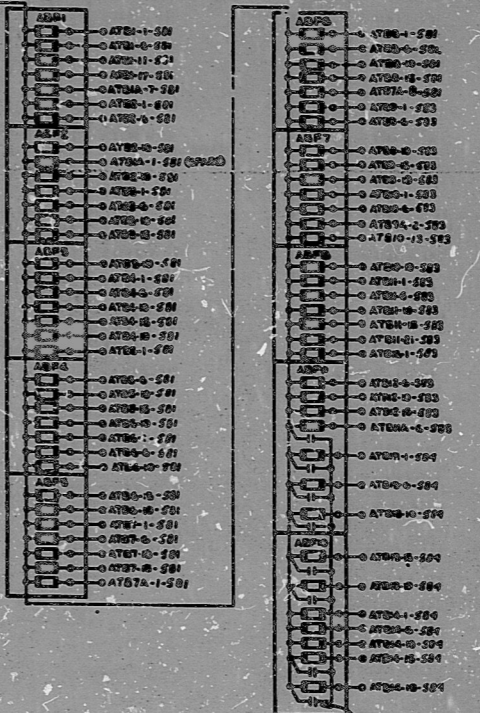

TYPICAL ALL PAGES  
ASPT. TANGI 4870  
NO AND BULLETPH THIS OLD  
M. RAYMOND PAGES

- NOTES**
1. FOR INTERNAL WIRING DIAGRAMS SEE DWG'S EC-210-572 THRU -576.
  2. FOR TERMINAL BOARD WIRING SEE DWG'S EC-210-581, 582 & 583.
  3. FOR LAYOUT SEE DWG. E-201-220.
  4. FOR GEN. NOTES SEE DWG. E-201-572.

4	REV. PER SON 03/11		
3	REV. AS YND.		
2	TYPE CHANGE ADD'D / REV'D - 16 PLACES		
1	REVISION, ADD'D CAT. NOS.		

**FLORIDA POWER CORPORATION**  
22 PENNINGTON, FLORIDA  
**CRYSTAL RIVER PLANT**

UNIT NO. 3      833,000 KW

**ELECTRICAL TPC**  
**TRANSMITTER POWER SUPPLY CABINET "A"**  
**ELEMENTARY DIAGRAM**

DESIGNED BY	GILBERT ASSOCIATES, INC.	APPROVED	GILBERT ASSOCIATES, INC.
CHECKED BY		FOR CONSTRUCTION BY	FLORIDA POWER CORPORATION
DATE	11-17-52	DATE	11-17-52
SCALE	C-210-586	NO.	12
	EC-210-586		

11	REVISED PER DCN 80-032		
10	AS INDY PER MAR 30-3-3		
9	REV. PER MAR 27-4-76-12-31		
8	REV. PER ECA 2673		
7	REV. PER ECA 0327		
6	REVISED PER DCN 1816 & 2232 AND AS IND.		
5	REVISED AS INDICATED		

CONSTRUCTION	162
LIMITED CONSTRUCTION AS NOTED	
PRELIMINARY LOT FOR CONSTRUCTION	
MEASUREMENTS ONLY	
RELEASED FOR	



89.02090246

PDR RIDS

