


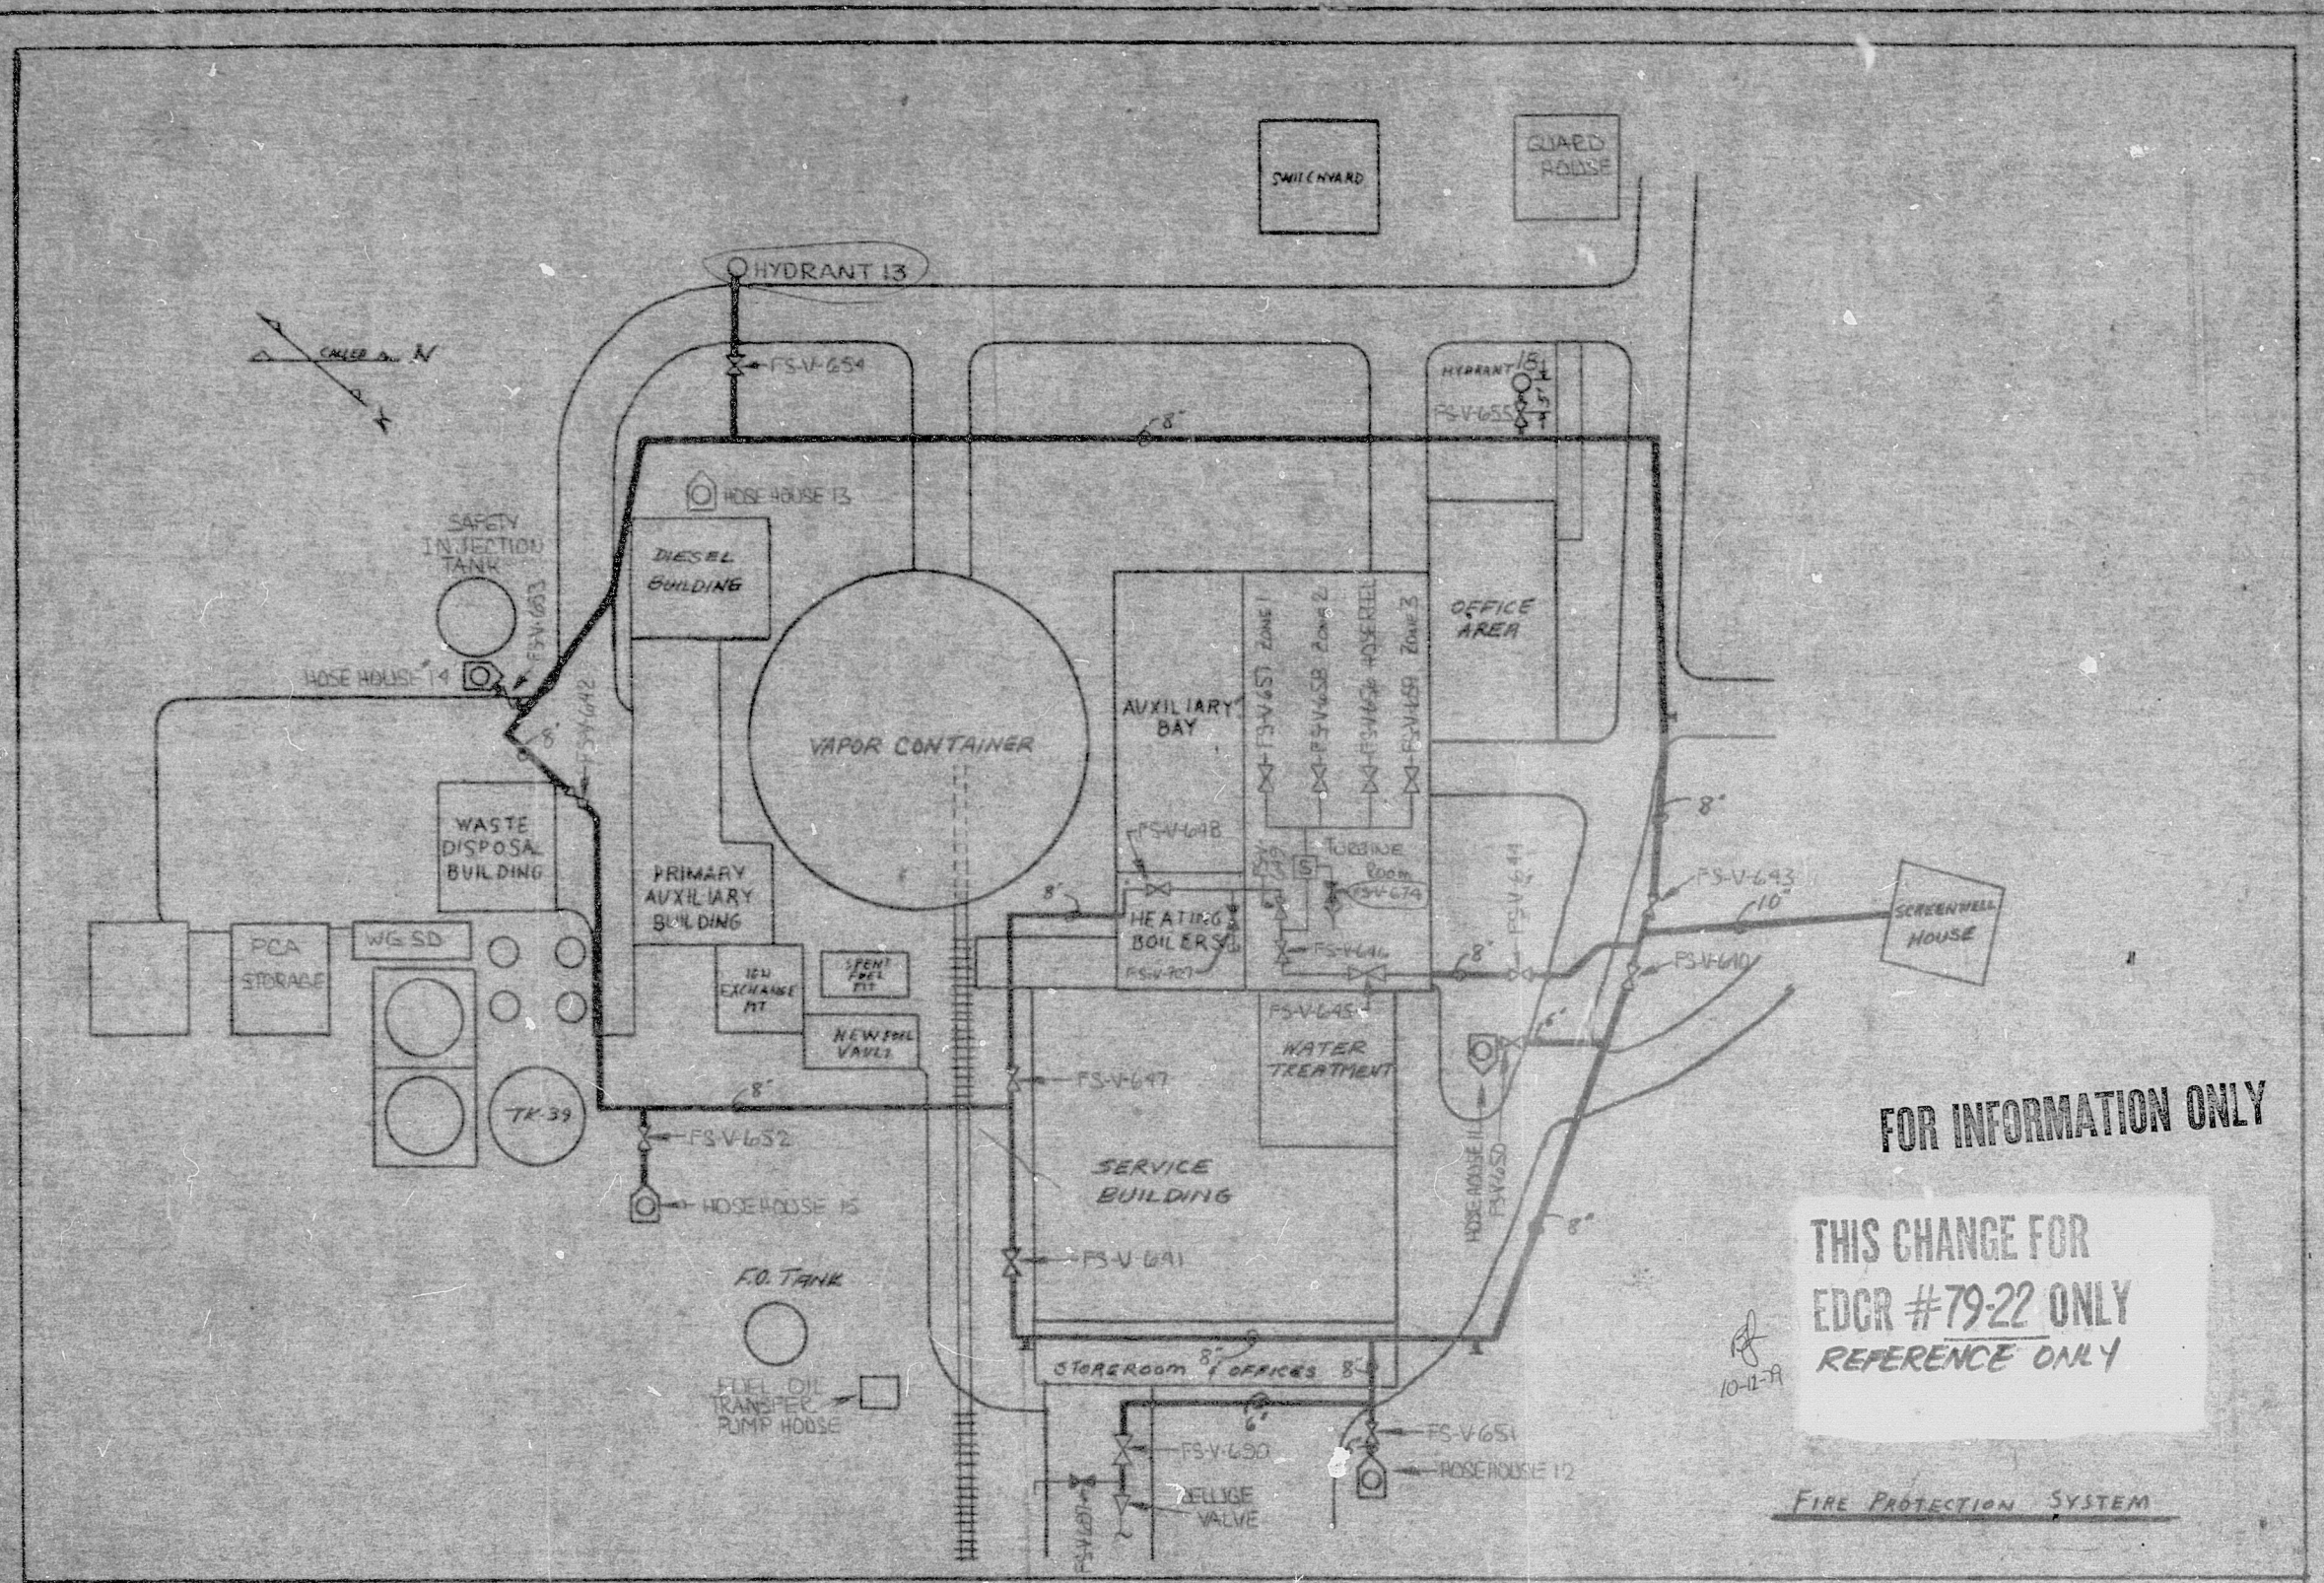

FOR INFORMATION ONLY

THIS CHANGE FOR
EDCR #79-22 ONLY
REFERENCE ONLY

FIRE PROTECTION SYSTEM

YANKEE ATOMIC ELECTRIC COMPANY ROWE, MASS.					
TITLE: FIRE PROTECTION SYSTEM					
3	CORRECTED STRAINER	1/17/67	6/7/74	DR. BY	LR
2	ADDED HOSE HOUSE 14	1/17/67	6/7/74	REF. NO.	9699-FB-20
1	GENERAL UPDATING	DJK	9/74	DR. NO.	YM-D-24
ISSUE	DESCRIPTION	BY	DATE	DATE	6/68

7911200328

7911200328

