


0-69-H


REMOTE CONTROL PANEL 485

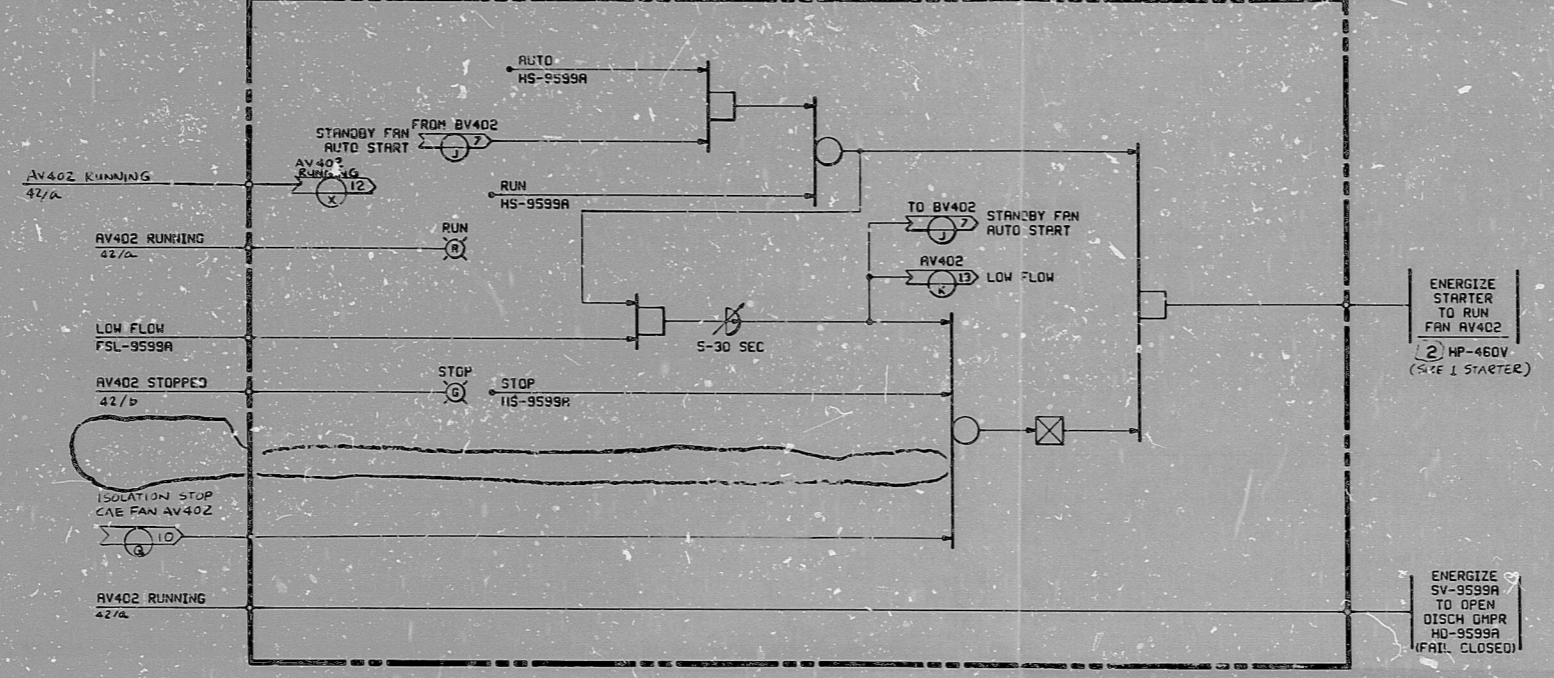

CONTROL AREA EXHAUST FAN AV402
CAE

CROSS REFERENCE TABLE

FAN NO.	HS-SV- HD-FSL-C	STANDBY FAN AUTO START	STOP CAE FAN
AV402	-9599A	BV402	ARRDQ Q SHT 10
BV402	-9599B	AV402	ARRDR R SHT 10

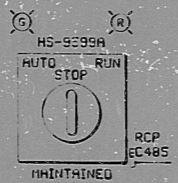

REVISION	DATE	BY	CHKD	APPD
1	10/1/71
2	11/1/71
3	1/1/72
4	1/1/72
5	1/1/72

SCALE: DESIGNED LK DRAWN BY: CHD

BECHTEL
SAN FRANCISCO

PUBLIC SERVICE ELECTRIC AND GAS COMPANY
HOPE CREEK GENERATING STATION

LOGIC DIAGRAM
AUXILIARY BLDG CONTROL AREA
CONTROL AREA EXHAUST FANS (CAE)

JOB NO.	DRAWING NO.	REV.
10855	H-89-0	SHT 7 3

PRO APERTURE CAPD

S/U - GK

I certify that the microfilmed image contained on this microform was made in the normal and regular course of business. This is a true, full, correct and complete reproduction and replacement for and/or in lieu of original document generated by the Bechtel group of companies.

Operator: DANNY Date: 1-23-73 Camera Type: MRG-1

RIDS

8307250220

