


8 LHS 0-68-H

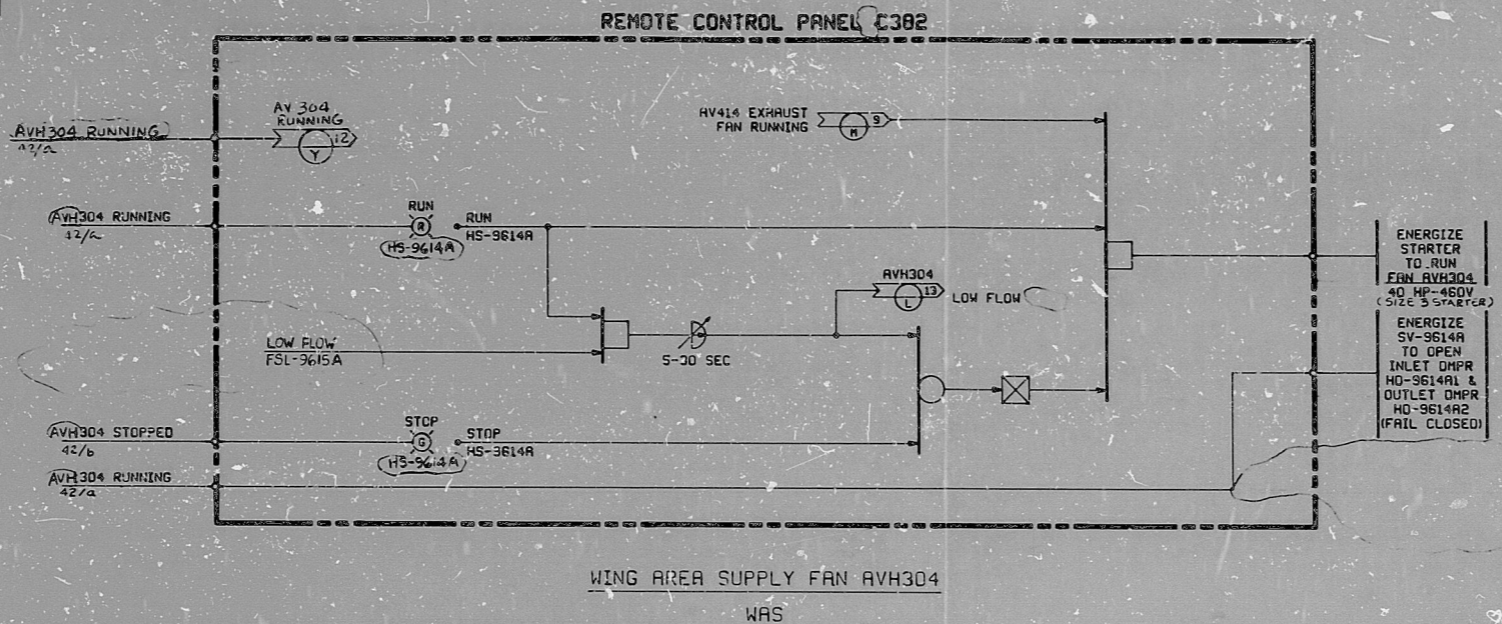

WING AREA SUPPLY FAN AVH304  
WAS

CROSS REFERENCE TABLE

FAN NO.	HS-SV-	FSL-	START PERMISSIVE	HO-
AVH304	-9614A	-9615A	AV414 RUNNING	-9614R1 -9614R2
BVH304	-9614B	-9615B	BV414 RUNNING	-9614B1 -9614B2


This drawing and the design of BECHTEL are the property of BECHTEL. They are hereby loaned to the borrower, who agrees to keep them confidential and to return them to BECHTEL upon completion of the project. No part of this drawing may be reproduced, stored in a retrieval system, or transmitted in any form or by any means, electronic, mechanical, photocopying, recording, or by any information storage and retrieval system, without the prior written permission of BECHTEL.



PRO APERTURE CARD

S/U - GK

NO.	DATE	REVISION	BY	CHKD	DESIGN	ENGR	DRWG	APPR						
1	4/1/68	REVISED AS NOTED DESIGN FREEZE ISSUE												
2	4/1/68	REVISED AS NOTED												
3	4/1/68	REVISED AS NOTED												
4	7-9-71	ISSUED FOR CONSTRUCTION												
<p>SCALE: _____ OFFERED: LK DRAWN: _____</p> <p><b>BECHTEL</b> SAN FRANCISCO</p> <p>PUBLIC SERVICE ELECTRIC AND GAS COMPANY HOPE CREEK GENERATING STATION</p> <p>LOGIC DIAGRAM AUXILIARY BLDG CONTROL AREA WING AREA SUPPLY UNITS (WAS)</p> <table border="1"> <tr> <td>JOB No.</td> <td>DRAWING No.</td> <td>REV.</td> </tr> <tr> <td>10855</td> <td>H-89-0</td> <td>3</td> </tr> </table>									JOB No.	DRAWING No.	REV.	10855	H-89-0	3
JOB No.	DRAWING No.	REV.												
10855	H-89-0	3												

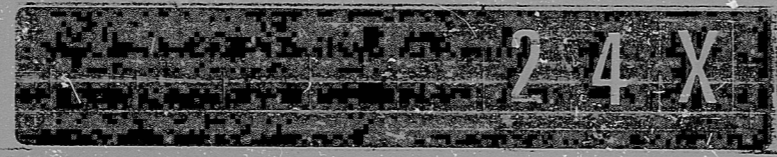

I certify that the microfilm image contained on this microform was made in the normal and regular course of business. This is a true, full, correct and complete reproduction and replacement for use in lieu of original documents generated by the Bechtel group of companies.

Signature: DANNY Date: 2-23 Camera Type: MRC 1

RIDS

8307250221

