


16 JHS 0-68-H

REMOTE CONTROL PANEL EC-183

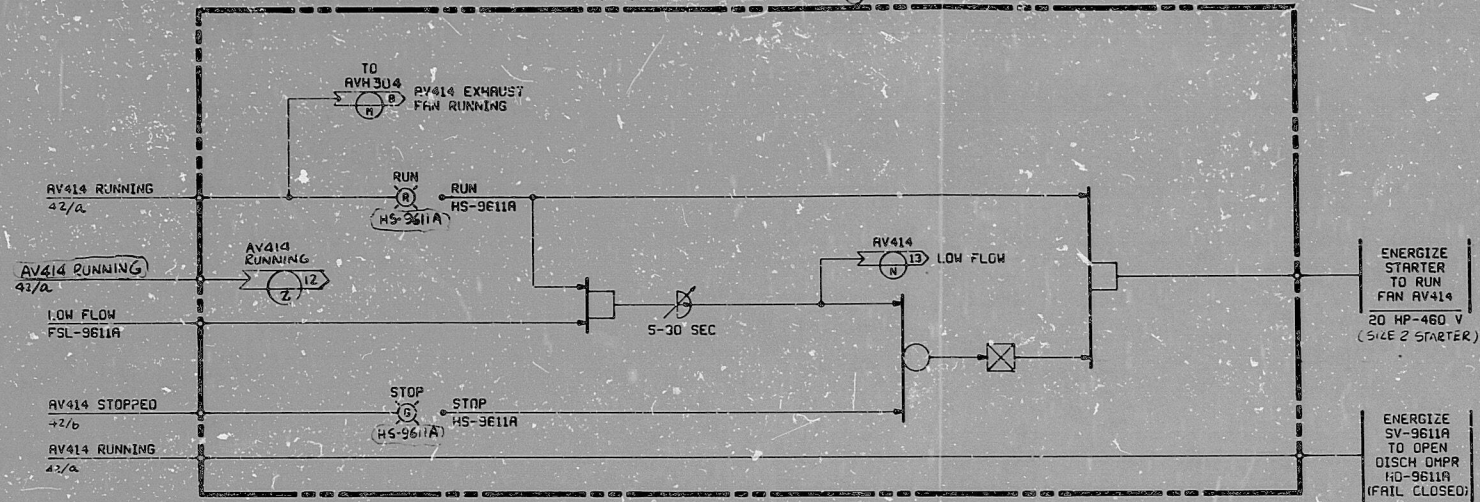

WING AREA EXHAUST FAN AV414
WAE

CROSS REFERENCE TABLE

FAN NO.	HS-	SV-	HD-
AV414	-9611A		
BV414	-9611B		

This drawing and the design it covers are the property of BECHTEL. They are hereby loaned and the borrower's attention is directed to the fact that they are not to be reproduced, copied, or otherwise used for any purpose other than that intended by the issuer.

HS-9611A
STCF RJU
RCF
EC-183
REINTEGRATED

PRO APERTURE CARD

S/U - GK

NO.	DATE	BY	REVISION	REASON
1	11/12	...	DESIGN FREEZE ISSUE	...
2	11/12	...	REVISAS AS NOTED	...
3	11/12	...	REVISAS AS NOTED	...
4	11/12	...	REVISAS AS NOTED	...
5	11/12	...	ISSUED FOR CONSTRUCTION	...

SCALE: DESIGNED LK DRAWN

BECHTEL
SAN FRANCISCO

PUBLIC SERVICE ELECTRIC AND GAS COMPANY
HOPE CREEK GENERATING STATION

LOGIC DIAGRAM
AUXILIARY BLOC CONTROL AREA
WING AREA EXHAUST FANS (WAE)

JOB No.	DRAWING No.	REV.
10855	H-89-0	SHT 9 3

I certify that the microfilm image contained on this microform was made in the normal and regular course of business. This is a true, full, correct and complete reproduction and replacement for and/or in lieu of original documents generated by the Bechtel group of companies.

DANNY
Camera Operator

Camera Type: MRG 1

24X

RIDS

8307250224

