


01 IHS 0-68-H

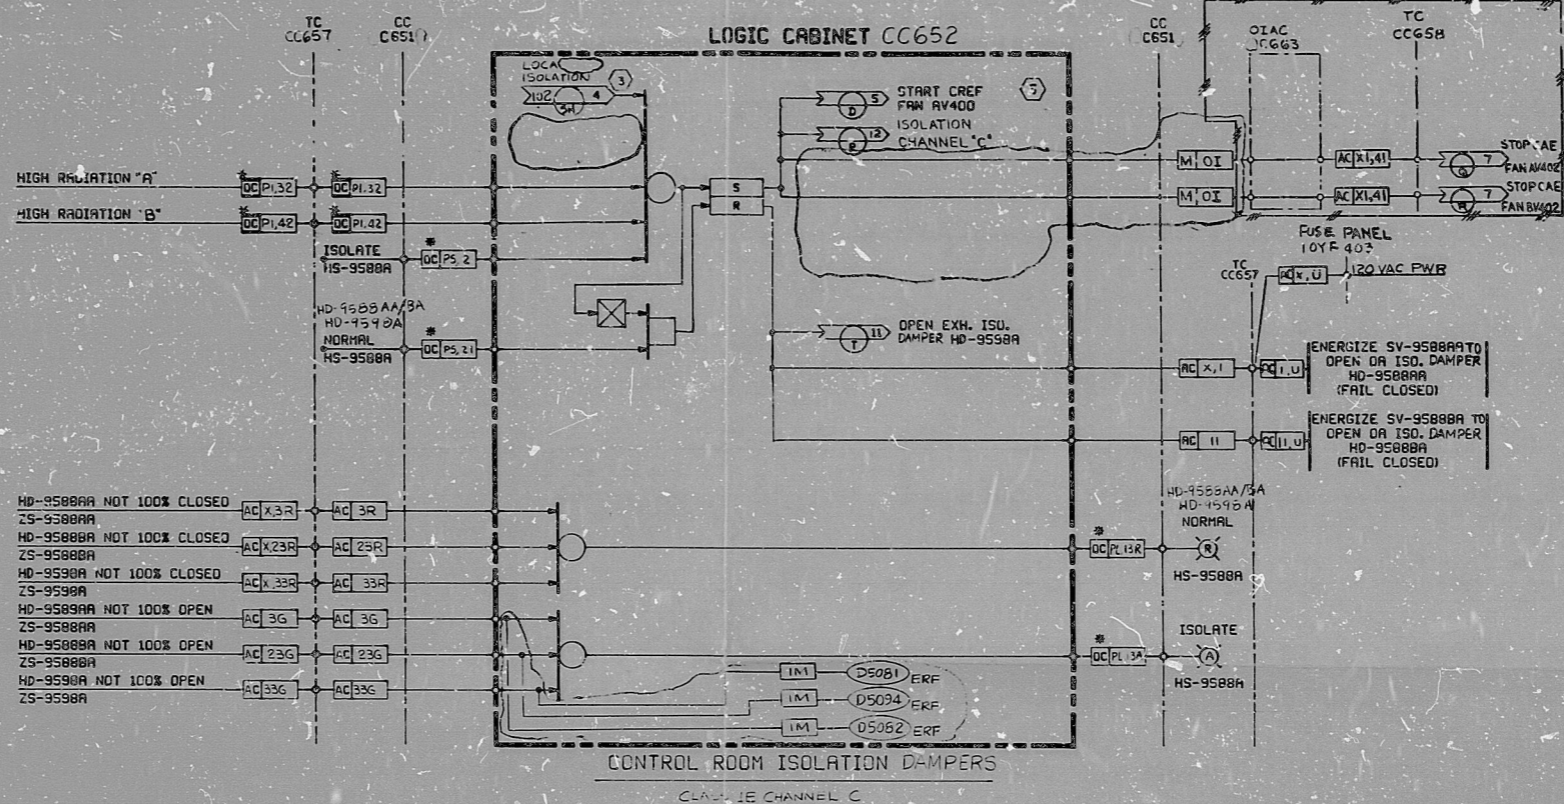

This drawing and its design are the property of BECHTEL. They are hereby loaned and on the borrower's express agreement that they will not be reproduced, copied, loaned, exhibited, nor used except in the manner, way and place as permitted by the written consent given by the borrower.

ISOLATE	CC 651E
NONMENTRY	

CROSS REFERENCE TABLE

OTAC	HS	SV, HD, ZS	HD, ZS SV	CLASS 1E CHANNEL	CKT NO	START CREF FAN	CONTROL ROOM ISOLATION CHANNEL CLASS 1E	LOGIC CAB	TERM CAB	LOCAL ISOLATION CH. 102	TERM CAB	POWER PANEL	CIRCUIT BREAKER	FUSE PANEL
C663	-9588A	-9588AA -9588BA	-9598A	C	5	AV400	C	CC652	CC657	SHT. 4, CKT3 ARROW SH	CC658	10Y 403	BRKR 2	10YF 403 FUSE 9
C663	-9588B	-9588AB -9588BB	-9598B	D	6	BV400	D	DC652	DC657	SHT. 5, CKT4 ARROW SR	CC658	10Y 404	BRKR 3	10YF 404 FILE 14

COMPUTER POINT CROSS REFERENCE TABLE

HD, ZS	COMP PT
9588AA	D5082
9588BA	D5094
9588A	D5081
9588B	D5095
9588AB	D5089
9588B	D5096

PRO APERTURE CARD

7/17/72	REVISED AS NOTED DESIGN FREEZE ISSUE			
7/16/72	REVISED AS NOTED			
7/16/72	REVISED AS NOTED			
7/14/72	INCORP DEN #1 AND REVISED #2 INSCRIPTION			
7/13/72	REVISED AS NOTED			
7/11/72	REVISED AS NOTED			
7/7/72	ISSUED FOR CONSTRUCTION			

SCALE: DESIGNED LK DRAWN

BECHTEL
SAN FRANCISCO

PUBLIC SERVICE ELECTRIC AND GAS COMPANY
HOPE CREEK GENERATING STATION

LOGIC DIAGRAM
AUXILIARY BLDG.-CONTROL AREA
ISOLATION DAMPERS

JCS No.	DRAWING No.	REV.
10855	H-89-0 SHT 10	6 Q

S/U - GK

24X

certify that the microfilm image contained on this microform was made in the normal and regular course of business. This is a true, full, correct and complete reproduction and replacement for and/or in lieu of original documents prepared by the Bechtel group of companies.

DANNY
Country Observer

MRC 1

RIDS

8307250228

