


6-9-8-16-9
06995-M-188

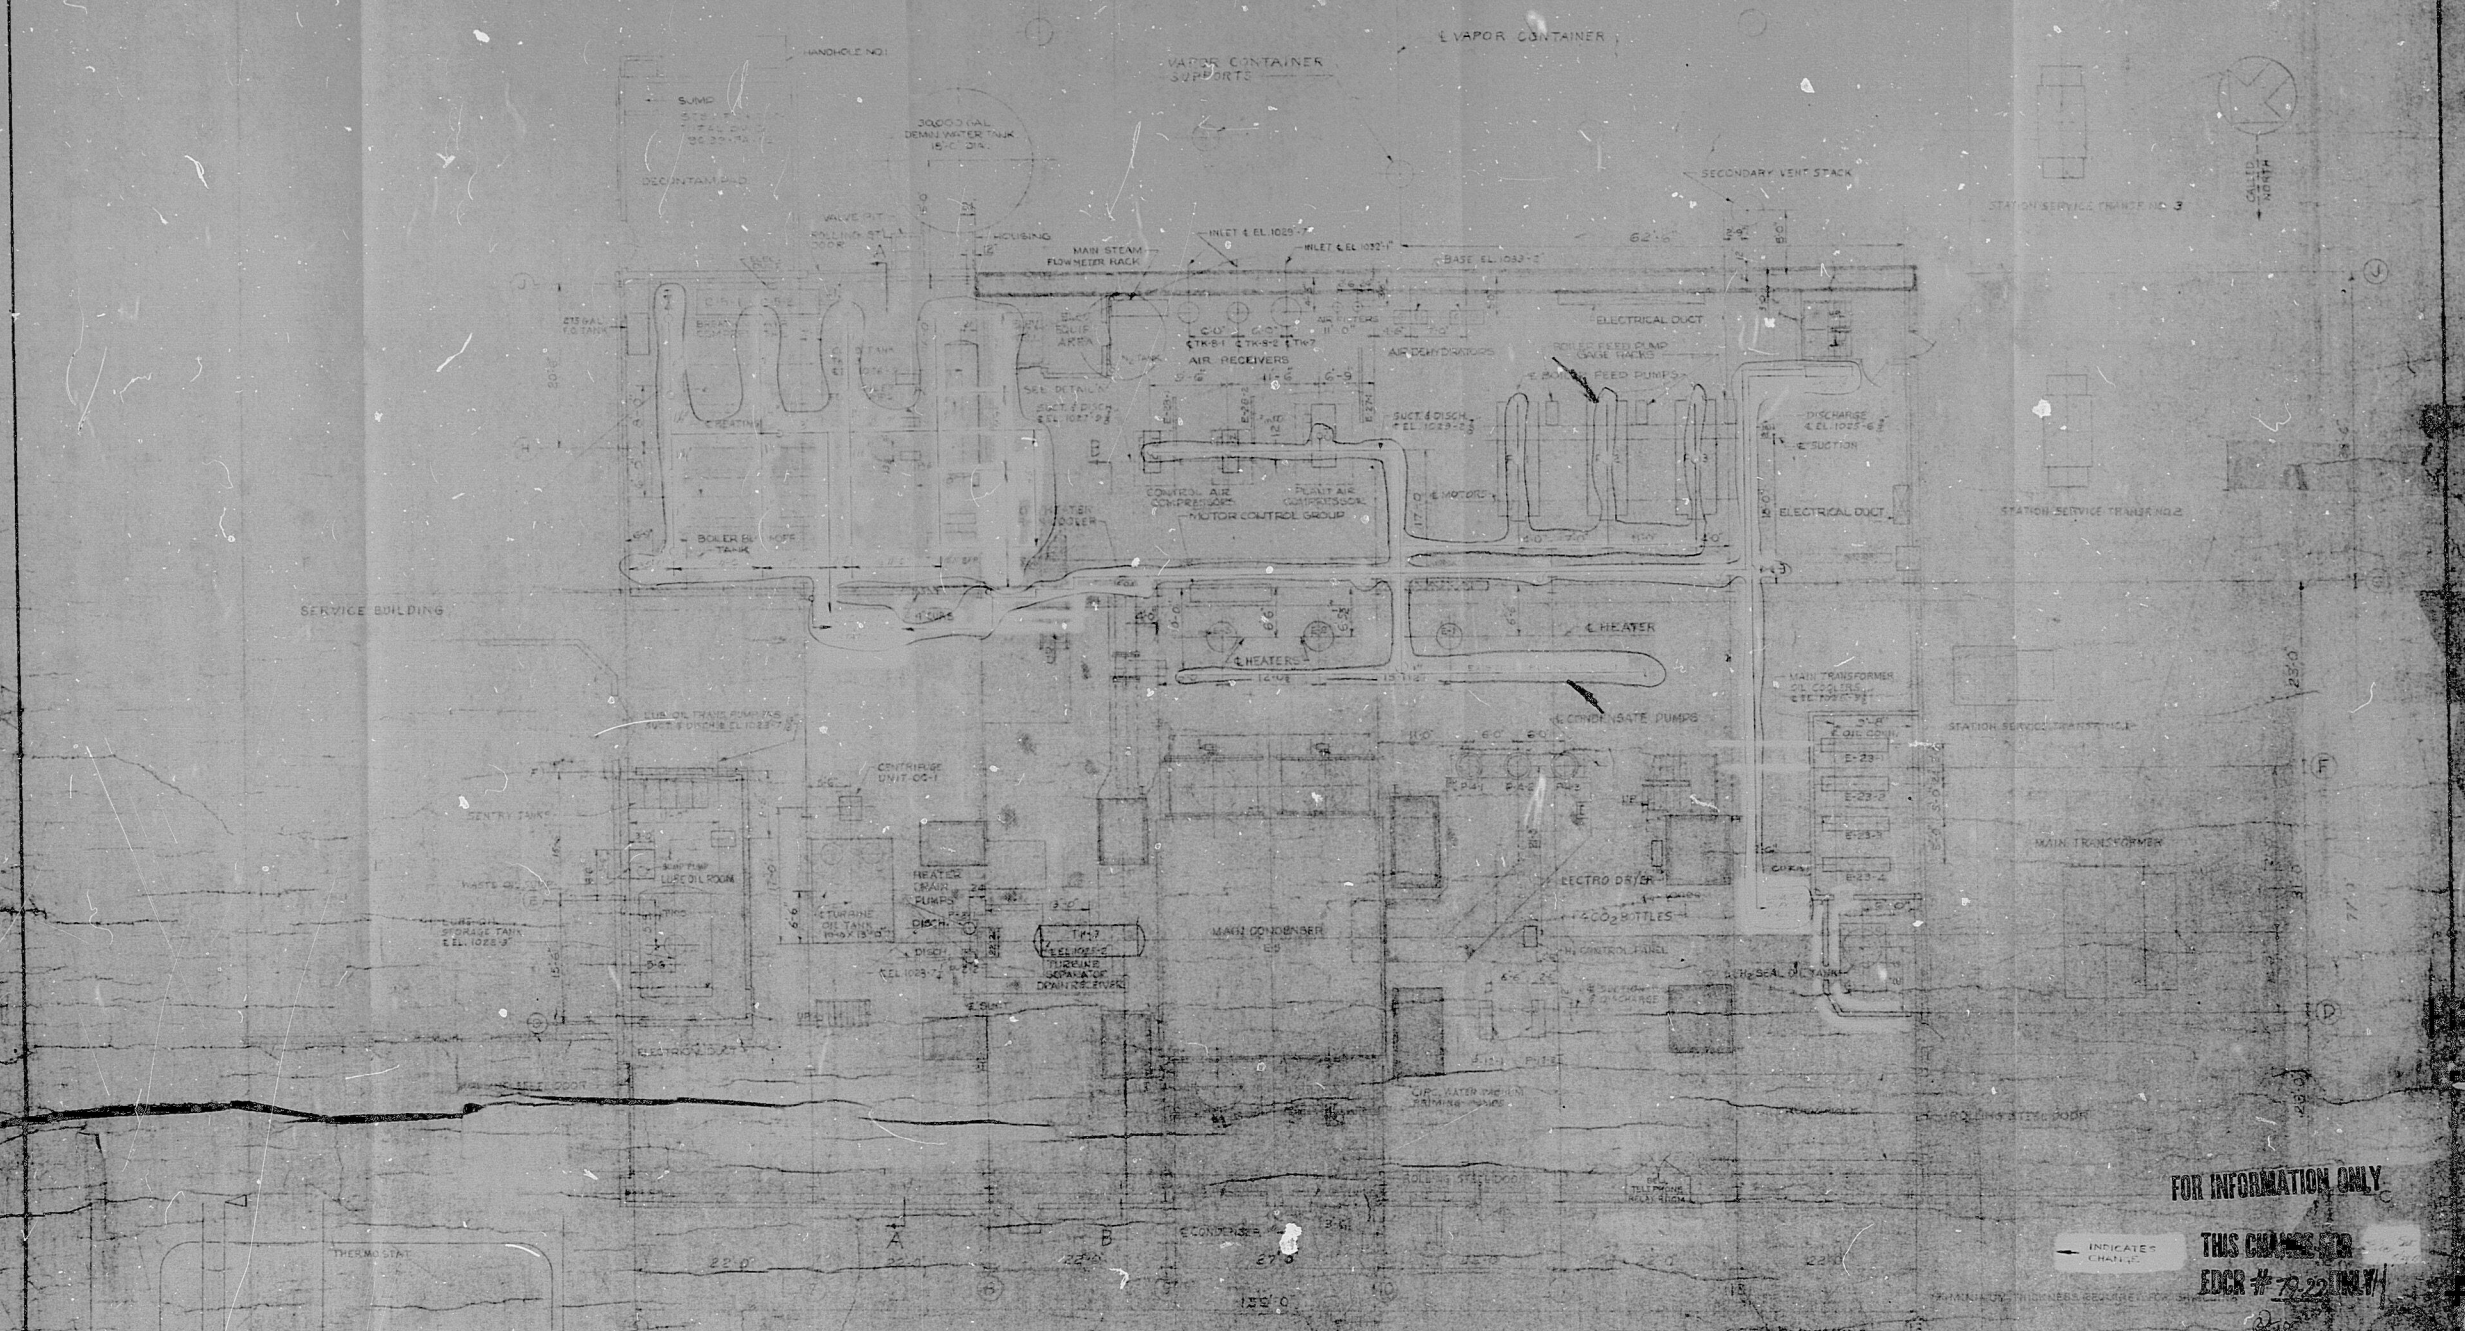

GROUND FLOOR EL 1022.6

REVISIONS

NO.	DATE	DESCRIPTION	BY	CHKD
1	SEP 24 1944	COVERED RAILROAD TRACKS	...	...
2	SEP 24 1944	COVERED RAILROAD TRACKS	...	...
3	SEP 24 1944	COVERED RAILROAD TRACKS	...	...
4	SEP 24 1944	COVERED RAILROAD TRACKS	...	...
5	SEP 24 1944	COVERED RAILROAD TRACKS	...	...
6	SEP 24 1944	COVERED RAILROAD TRACKS	...	...
7	SEP 24 1944	COVERED RAILROAD TRACKS	...	...
8	SEP 24 1944	COVERED RAILROAD TRACKS	...	...
9	SEP 24 1944	COVERED RAILROAD TRACKS	...	...
10	SEP 24 1944	COVERED RAILROAD TRACKS	...	...
11	SEP 24 1944	COVERED RAILROAD TRACKS	...	...
12	SEP 24 1944	COVERED RAILROAD TRACKS	...	...

FOR INFORMATION ONLY

THIS CHANGE IS
EDCR # 72210274

APPROVED
MACHINE LOCATION
POWER STATION
YANKEE ATOMIC ELECTRIC COMPANY
ROCKY HILLS, CONNECTICUT
STATION & REVISIONS SHEET

7911200427

