



CI IHS 0-68-H






REMOTE CONTROL PANEL EC485

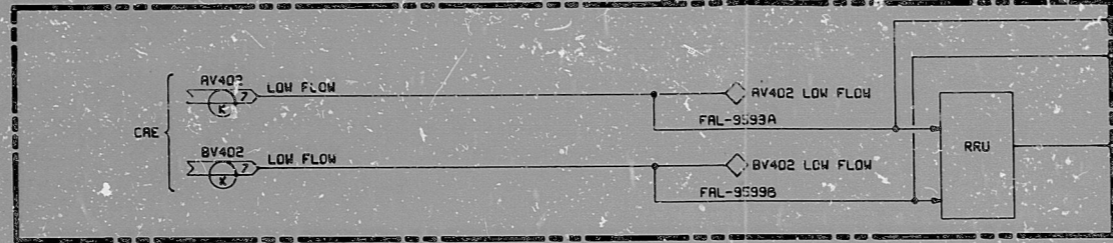

REMOTE CONTROL PANEL C382

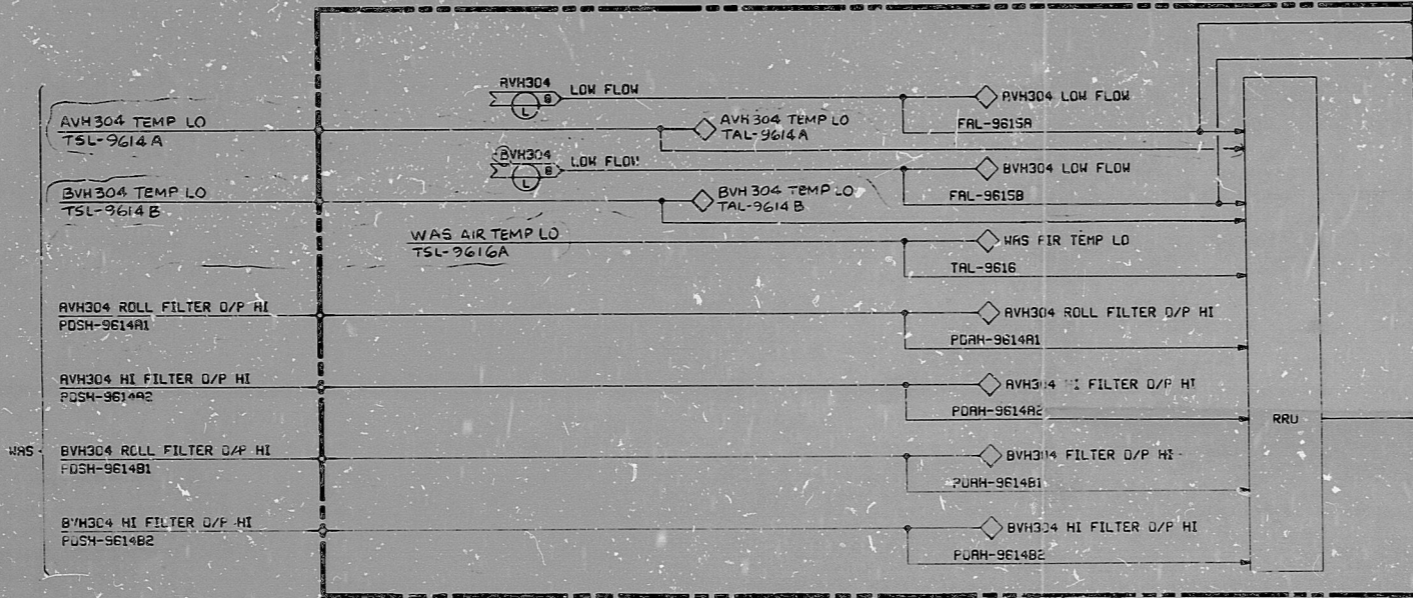

REMOTE CONTROL PANEL EC483

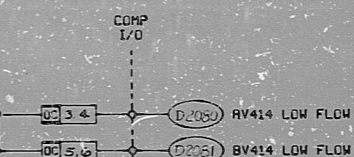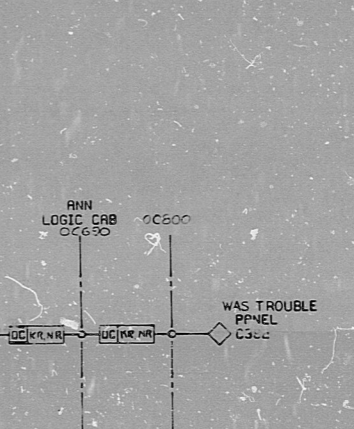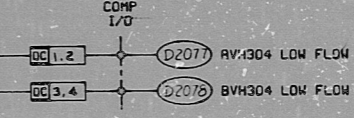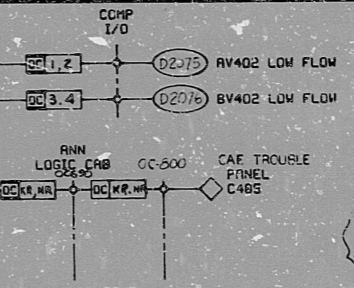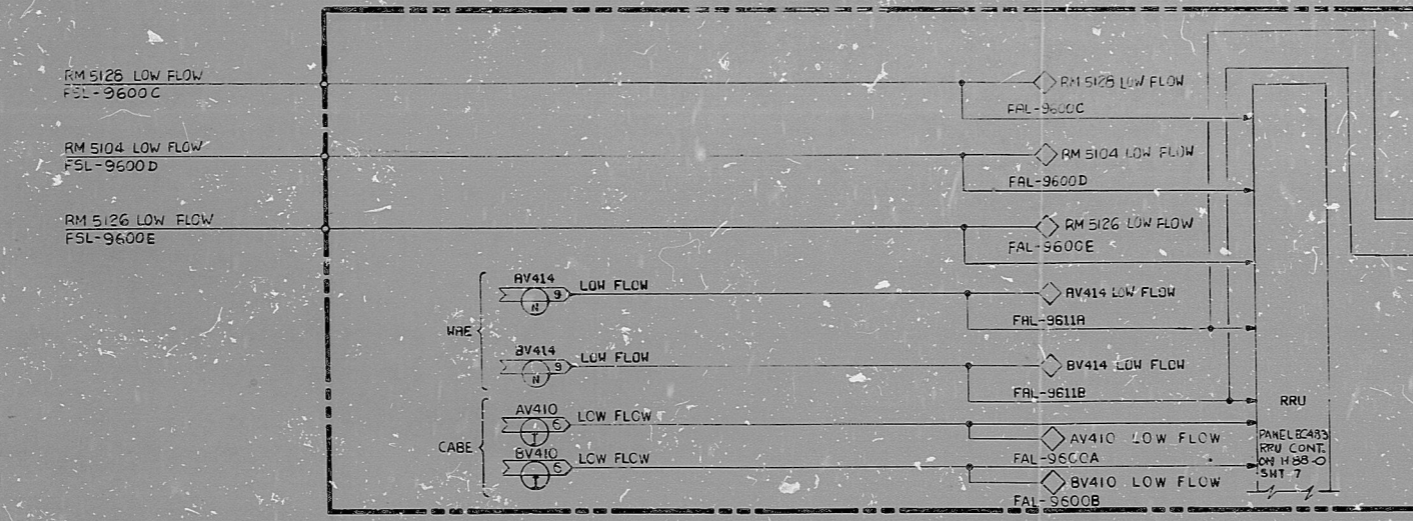

PRO APERTURE CARD

S/U - GK

NO.	DATE	REVISIONS	BY	CHECK	DESIGN	ENGR	APPV
1	1/17/78	REVISED AS NOTED, DESIGN FREEZE ISSUE	MR	MR	MR	MR	MR
2	2/2/78	REVISED AS NOTED	MR	MR	MR	MR	MR
3	4/17/78	INCORPORATED DCN #1	MR	MR	MR	MR	MR
4	11/7/78	REVISED AS NOTED	MR	MR	MR	MR	MR
5	11/27/78	REVISED AS NOTED	MR	MR	MR	MR	MR
6	12-9-78	ISSUED FOR CONSTRUCTION	MR	MR	MR	MR	MR

BECHTEL
SAN FRANCISCO

PUBLIC SERVICE ELECTRIC AND GAS COMPANY
HOPE CREEK GENERATING STATION

LOGIC DIAGRAM
AUXILIARY SLOG-CONTROL AREA
ALARMS (REMOTE PANELS)

JOB No.	DRAWING No.	REV.
10855	H-89-0	SHT 13 5

This drawing and the design it covers are the property of BECHTEL. They are hereby loaned to you on the basis of an express agreement that they will not be reproduced, copied, loaned, or otherwise disseminated without the written consent of BECHTEL.

24 X

I certify that the microfilm image contained on this microform was made in the normal and regular course of business. This is a true, full, correct and complete reproduction and replacement for and/or in lieu of original documents generated by the Bechtel group of companies.

DANNY
Camera Operator

MRG 1

RID[®]

8307250236

