


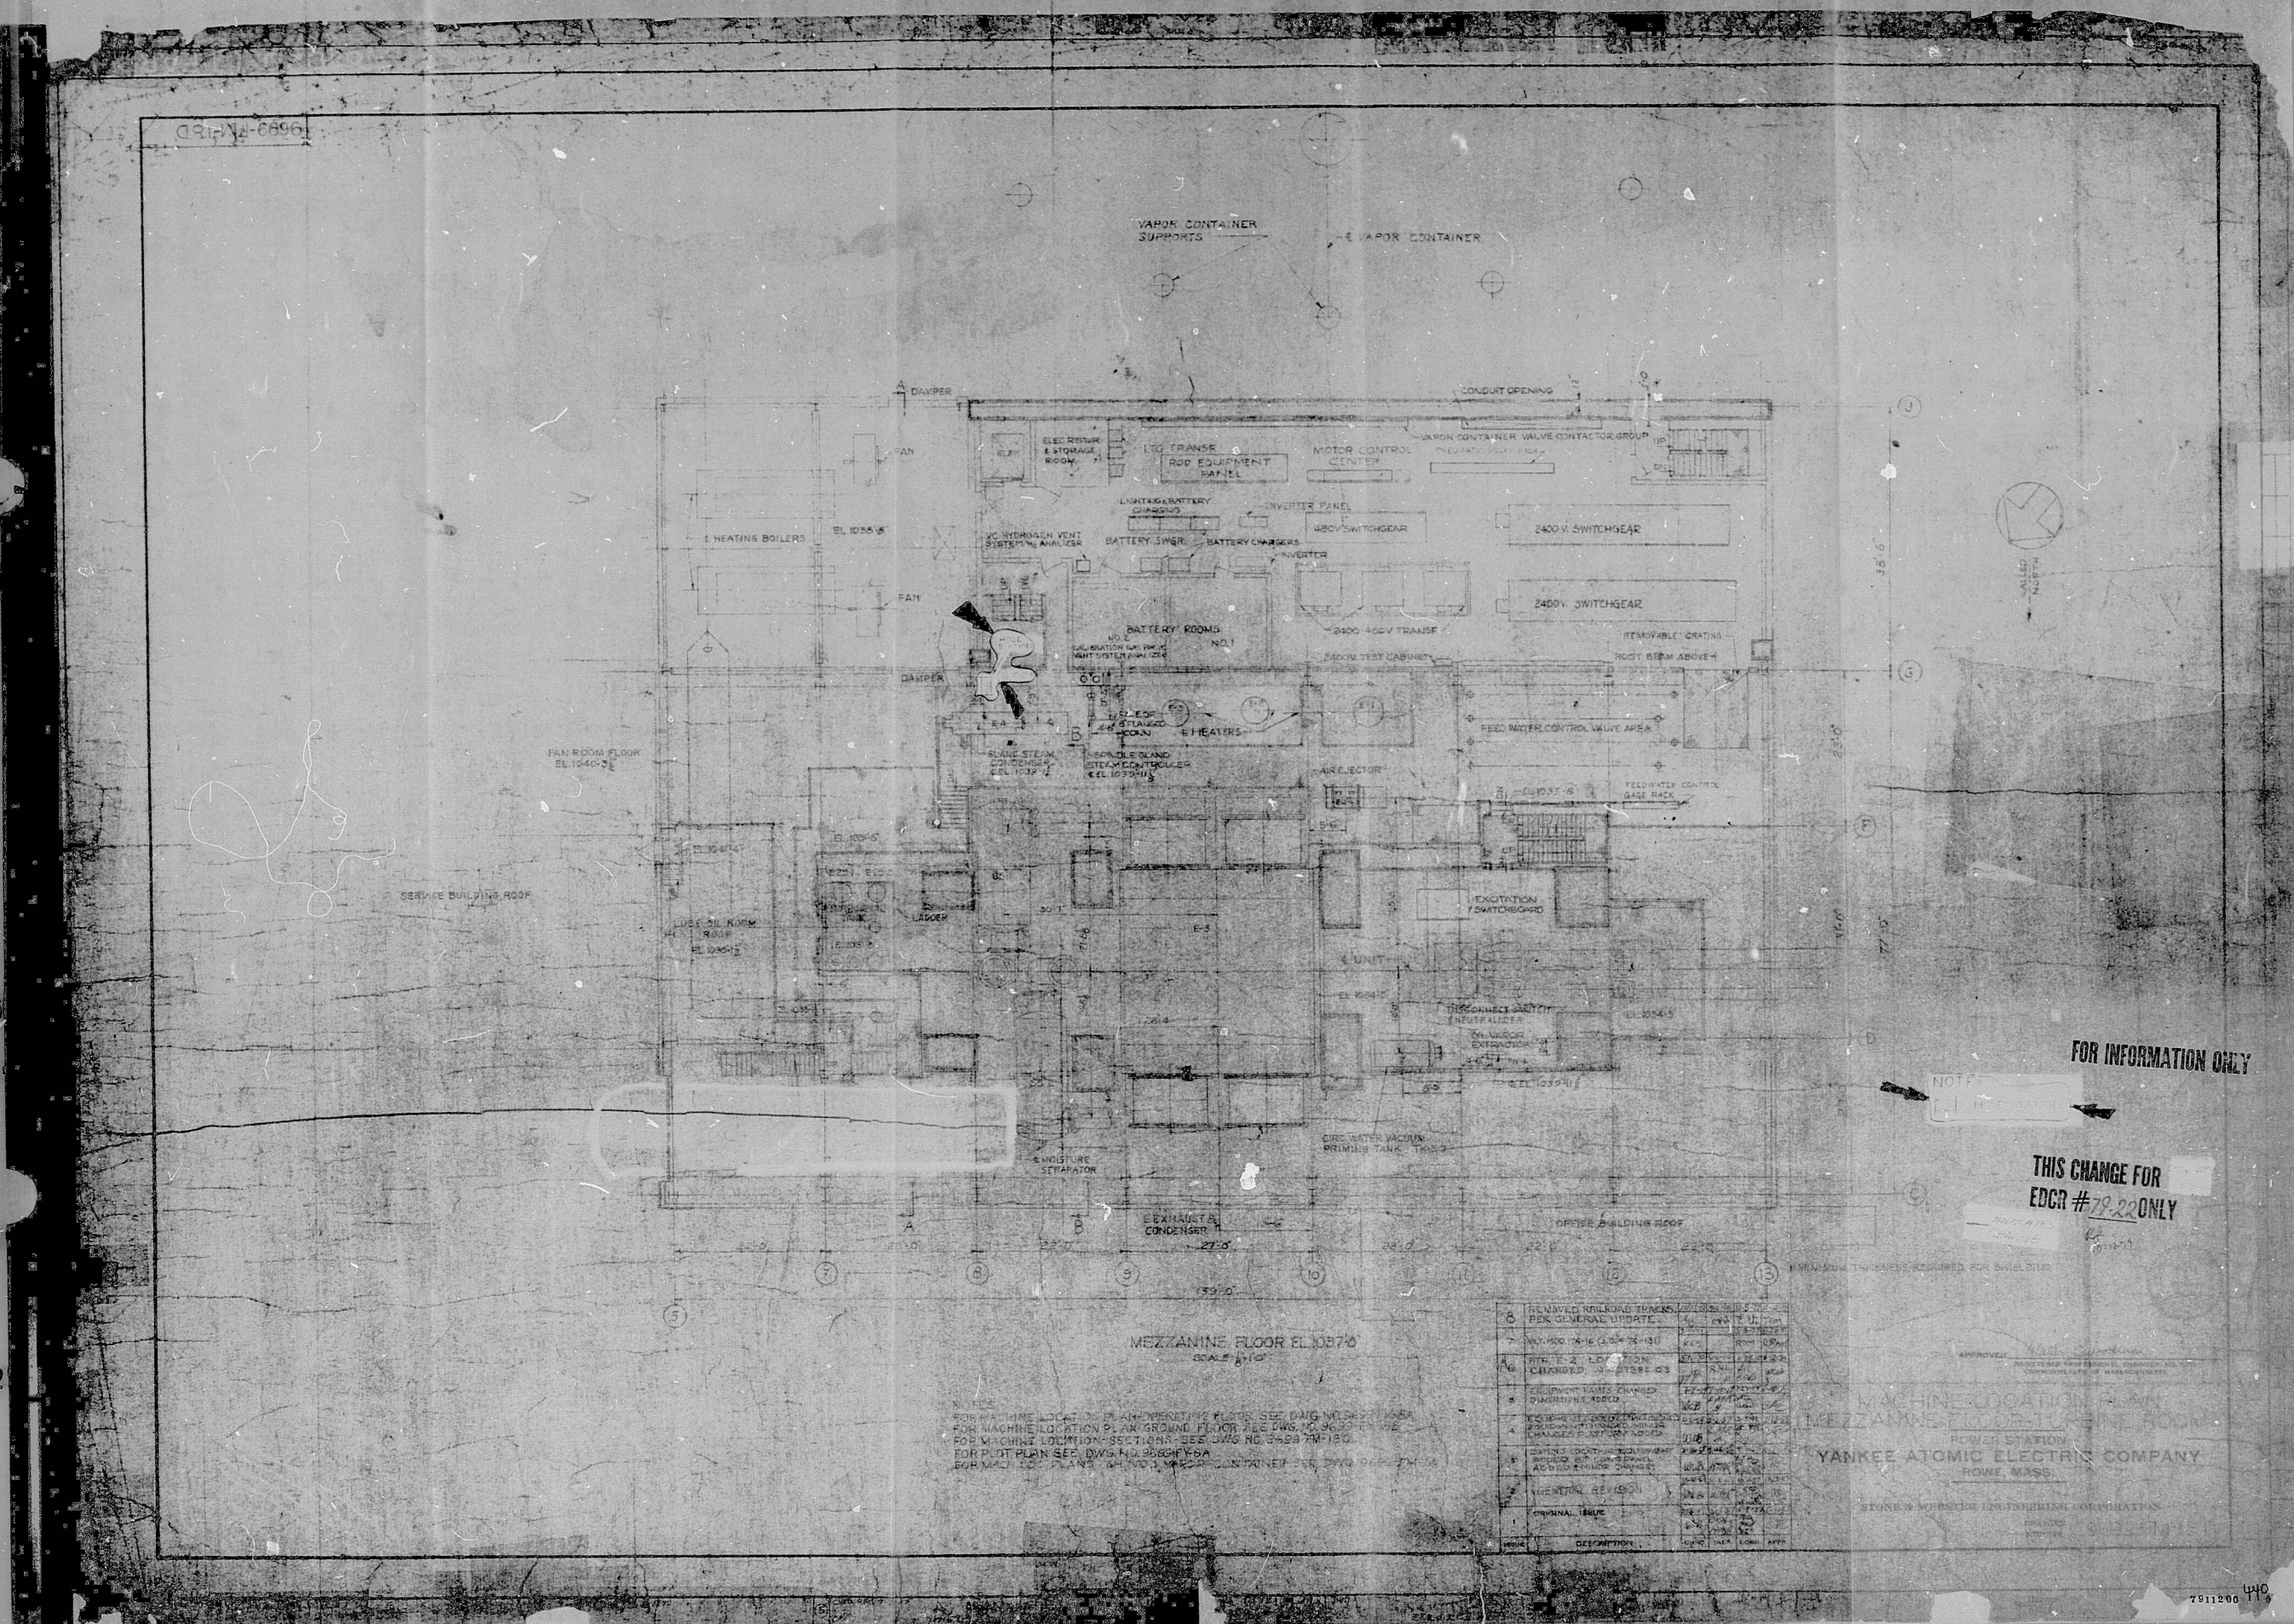

FOR INFORMATION ONLY

THIS CHANGE FOR
EDCR # 78-22 ONLY

[illegible]

MACHINE LOCATION - 1ST FLOOR
MEZZANINE FLOOR - TURBINE ROOM
POWER STATION
YANKEE ATOMIC ELECTRIC COMPANY
ROWE, MASS.

7911200 440

7911200440

