



INFORMATION  
THIS DOCUMENT IS  
SUBJECT TO REVISION  
WITHOUT NOTIFICATION  
TO THE USER OF THIS  
COPY

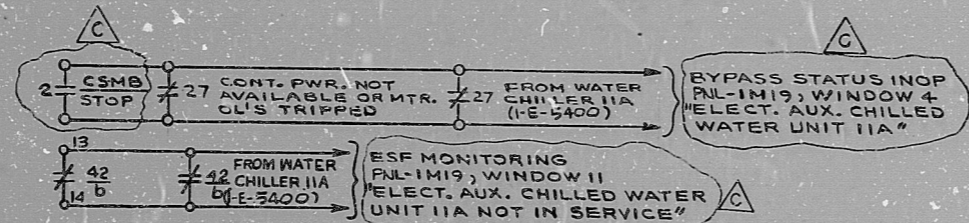

07 42 } E.A.B. HVAC  
08 a } CHILLER IIA  
(I-E-5400)

BLOCK	CONTACT	POSITION (IS 152)			USE
		STOP	AUTO	START	
A	NC (1)		X	X	CONT.
	NO (2)	X			CONT.
B	NC (3)	X	X		SP
	NO (4)			X	CONT.

SPRING RETURN FROM START  
X DENOTES CONTACTS CLOSED  
GE CAT NO CR2940U5203

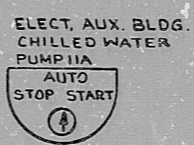

- REFERENCE DRAWINGS
- 0-E-0105 ELECTRICAL WIRING STANDARDS AND SYMBOLS
  - 1-Z-3460 ELEC. AUX. BLDG. & CONT. RM. HVAC CHILLED WATER PUMPS LOGIC DIAGRAM
  - 1-E-7424 CONTROL WIRING DIAGRAM ELEC. AUX. BLDG. HVAC CHILLED WATER PUMP IIA
  - 7244D71 SOLID STATE PROTECTION SYSTEM INTERCONNECTION DIAGRAM

- LEGEND
- K823 - RELAY FOR SAFETY INJECTION CONTACT CLOSING ON SI SIGNAL
  - IRR-002 - ACTUATION TRAIN A CABINET.
  - 45-RM-A - RADIATION MONITOR TRAIN A AUX. RELAY CONTACT OPENS BELOW SETPOINT
  - 27 - LOSS OF CONTROL PWR. RELAY.

MECH. EQUIP NO 3V11VPA001  
480V-MCC-EIAl-COMPT. L1


NUCLEAR SAFETY RELATED		
CLASS IE		
PKG:042A	SUFF:102	ACT:581
DRAWING TITLE ELECTRICAL	CONTRACT NO	SCALE
ELEMENTARY DIAGRAM	CR-0241	NONE
ELEC. AUX. BLDG. HVAC CHILLED WATER PUMP IIA	DRAWING NO	4-V-II
	I-E-5424-C	

REVISED AS NOTED ISSUED FOR USE	BY: [Signature]	DATE: [Date]	DESCRIPTION: [Blank]	BY: [Blank]	DATE: [Blank]	DESCRIPTION: [Blank]
ISSUED FOR REVIEW & COMMENT	BY: [Signature]	DATE: [Date]	DESCRIPTION: [Blank]	BY: [Blank]	DATE: [Blank]	DESCRIPTION: [Blank]

**Brown & Root Inc.**  
ENGINEERS-CONSTRUCTORS  
HOUSTON, TEXAS

**SOUTH TEXAS PROJECT**

**BROWN & ROOT INC.**  
MICROFILM SERVICES

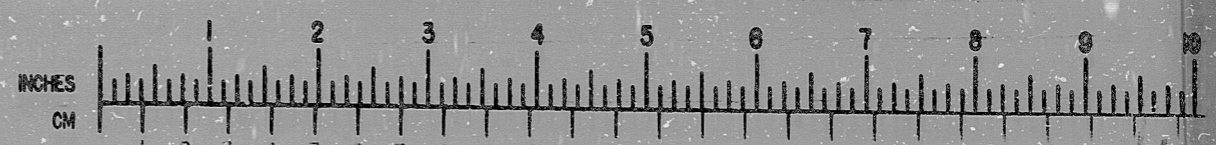

INFORMATION  PRELIMINARY  REVIEW  USE  CONSTRUCTION



RIDS

812100301

