
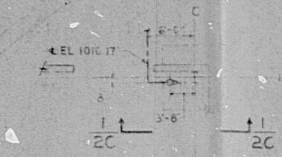


9699-FB-2C

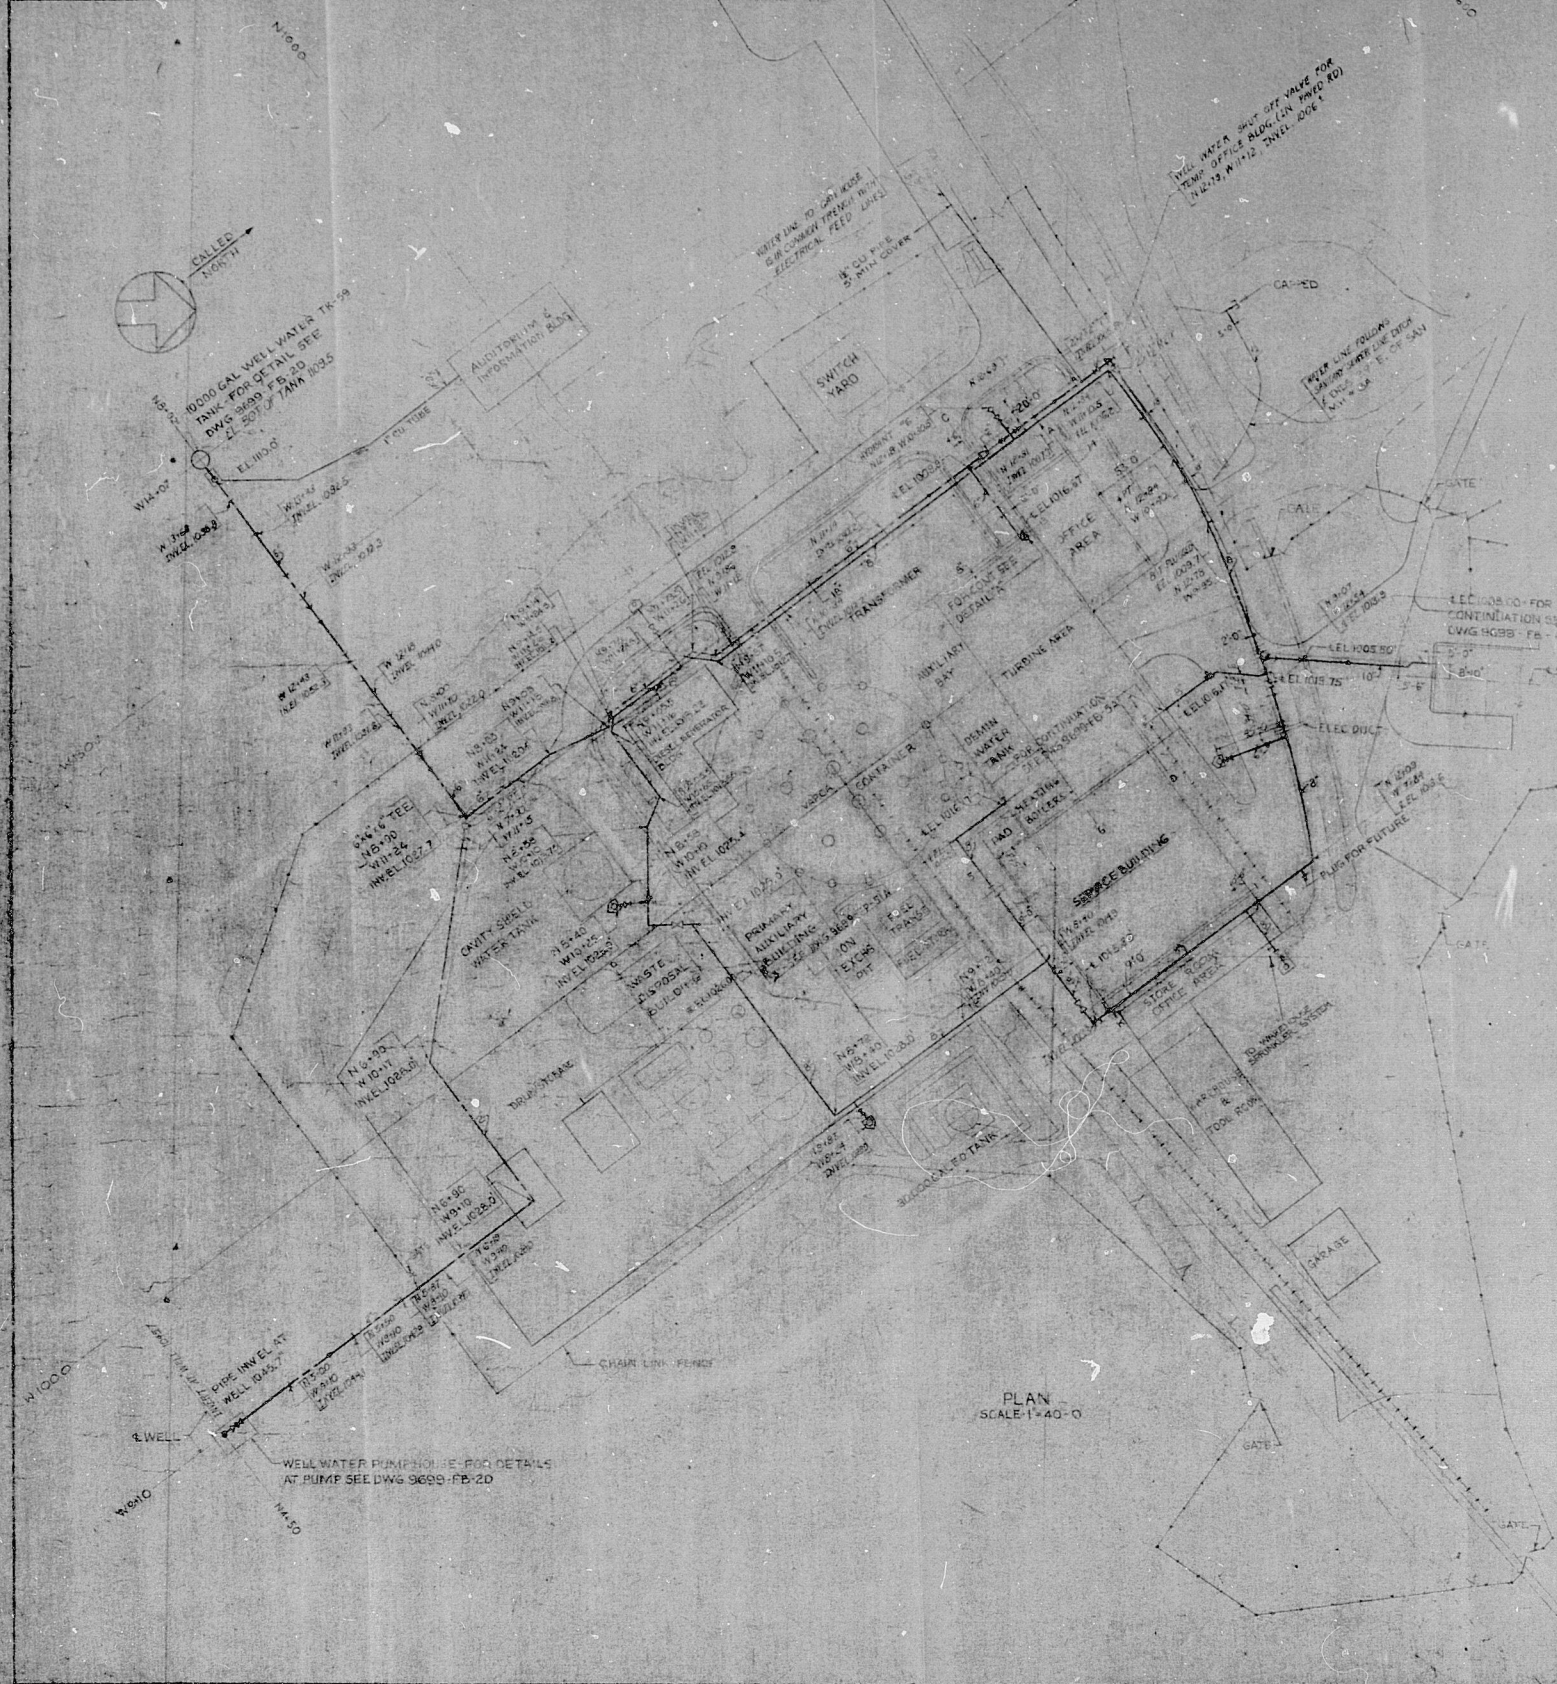

TERMINATE WITH GATE VALVE FOR CONTINUATION SEE DWG 9699-FB-2A

SECTION 1/20 SCALE 1/4=1

NOTES:
1. PROVIDE MINIMUM COVER OF 5' FOR ALL UNDERGROUND WATER LINES
2. FOR WATER: FIRE PROTECTION UNDERGROUND SEE DWG 9699-FB-2D

LEGEND:
POST HYDRAULIC VALVE
WELL WATER LINE
FIRE PROTECTION LINE
HOSE HOUSE
REDUCER
GATE VALVE
DIRECTION OF FLOW
HYDRANT

FOR INFORMATION ONLY

THIS CHANGE FOR
EDG 7922 ONLY
REFERENCE ONLY

APPROVED: [Signature]
REGISTERED PROFESSIONAL ENGINEER
COMMONWEALTH OF MASSACHUSETTS

WATER & FIRE PROTECTION
UNDERGROUND
POWER STATION
YANKEE ATOMIC ELECTRIC COMPANY
ROWE, MASS.

STONE & WEBSTER ENGINEERING CORPORATION

DRAWING NUMBER 9699

7	REMOVED WELL WATER	NOV 1964	RTT	1/1	1/1
6	UPDATED TO AS BUILT TOWN	NOV 1964	RTT	1/1	1/1
5	ADDED FIRE PROTECTION	NOV 1964	RTT	1/1	1/1
4	ISSUED FOR CONSTRUCTION	NOV 1964	RTT	1/1	1/1
3	AS BUILT CHANGES	NOV 1964	RTT	1/1	1/1
2	GENERAL REVISIONS COMPLETED	NOV 1964	RTT	1/1	1/1
1	ORIGINAL ISSUE	NOV 1964	RTT	1/1	1/1
DATE	DESCRIPTION	CHD	NOV	CON	APP

7811200 447

7911 20044 3

