


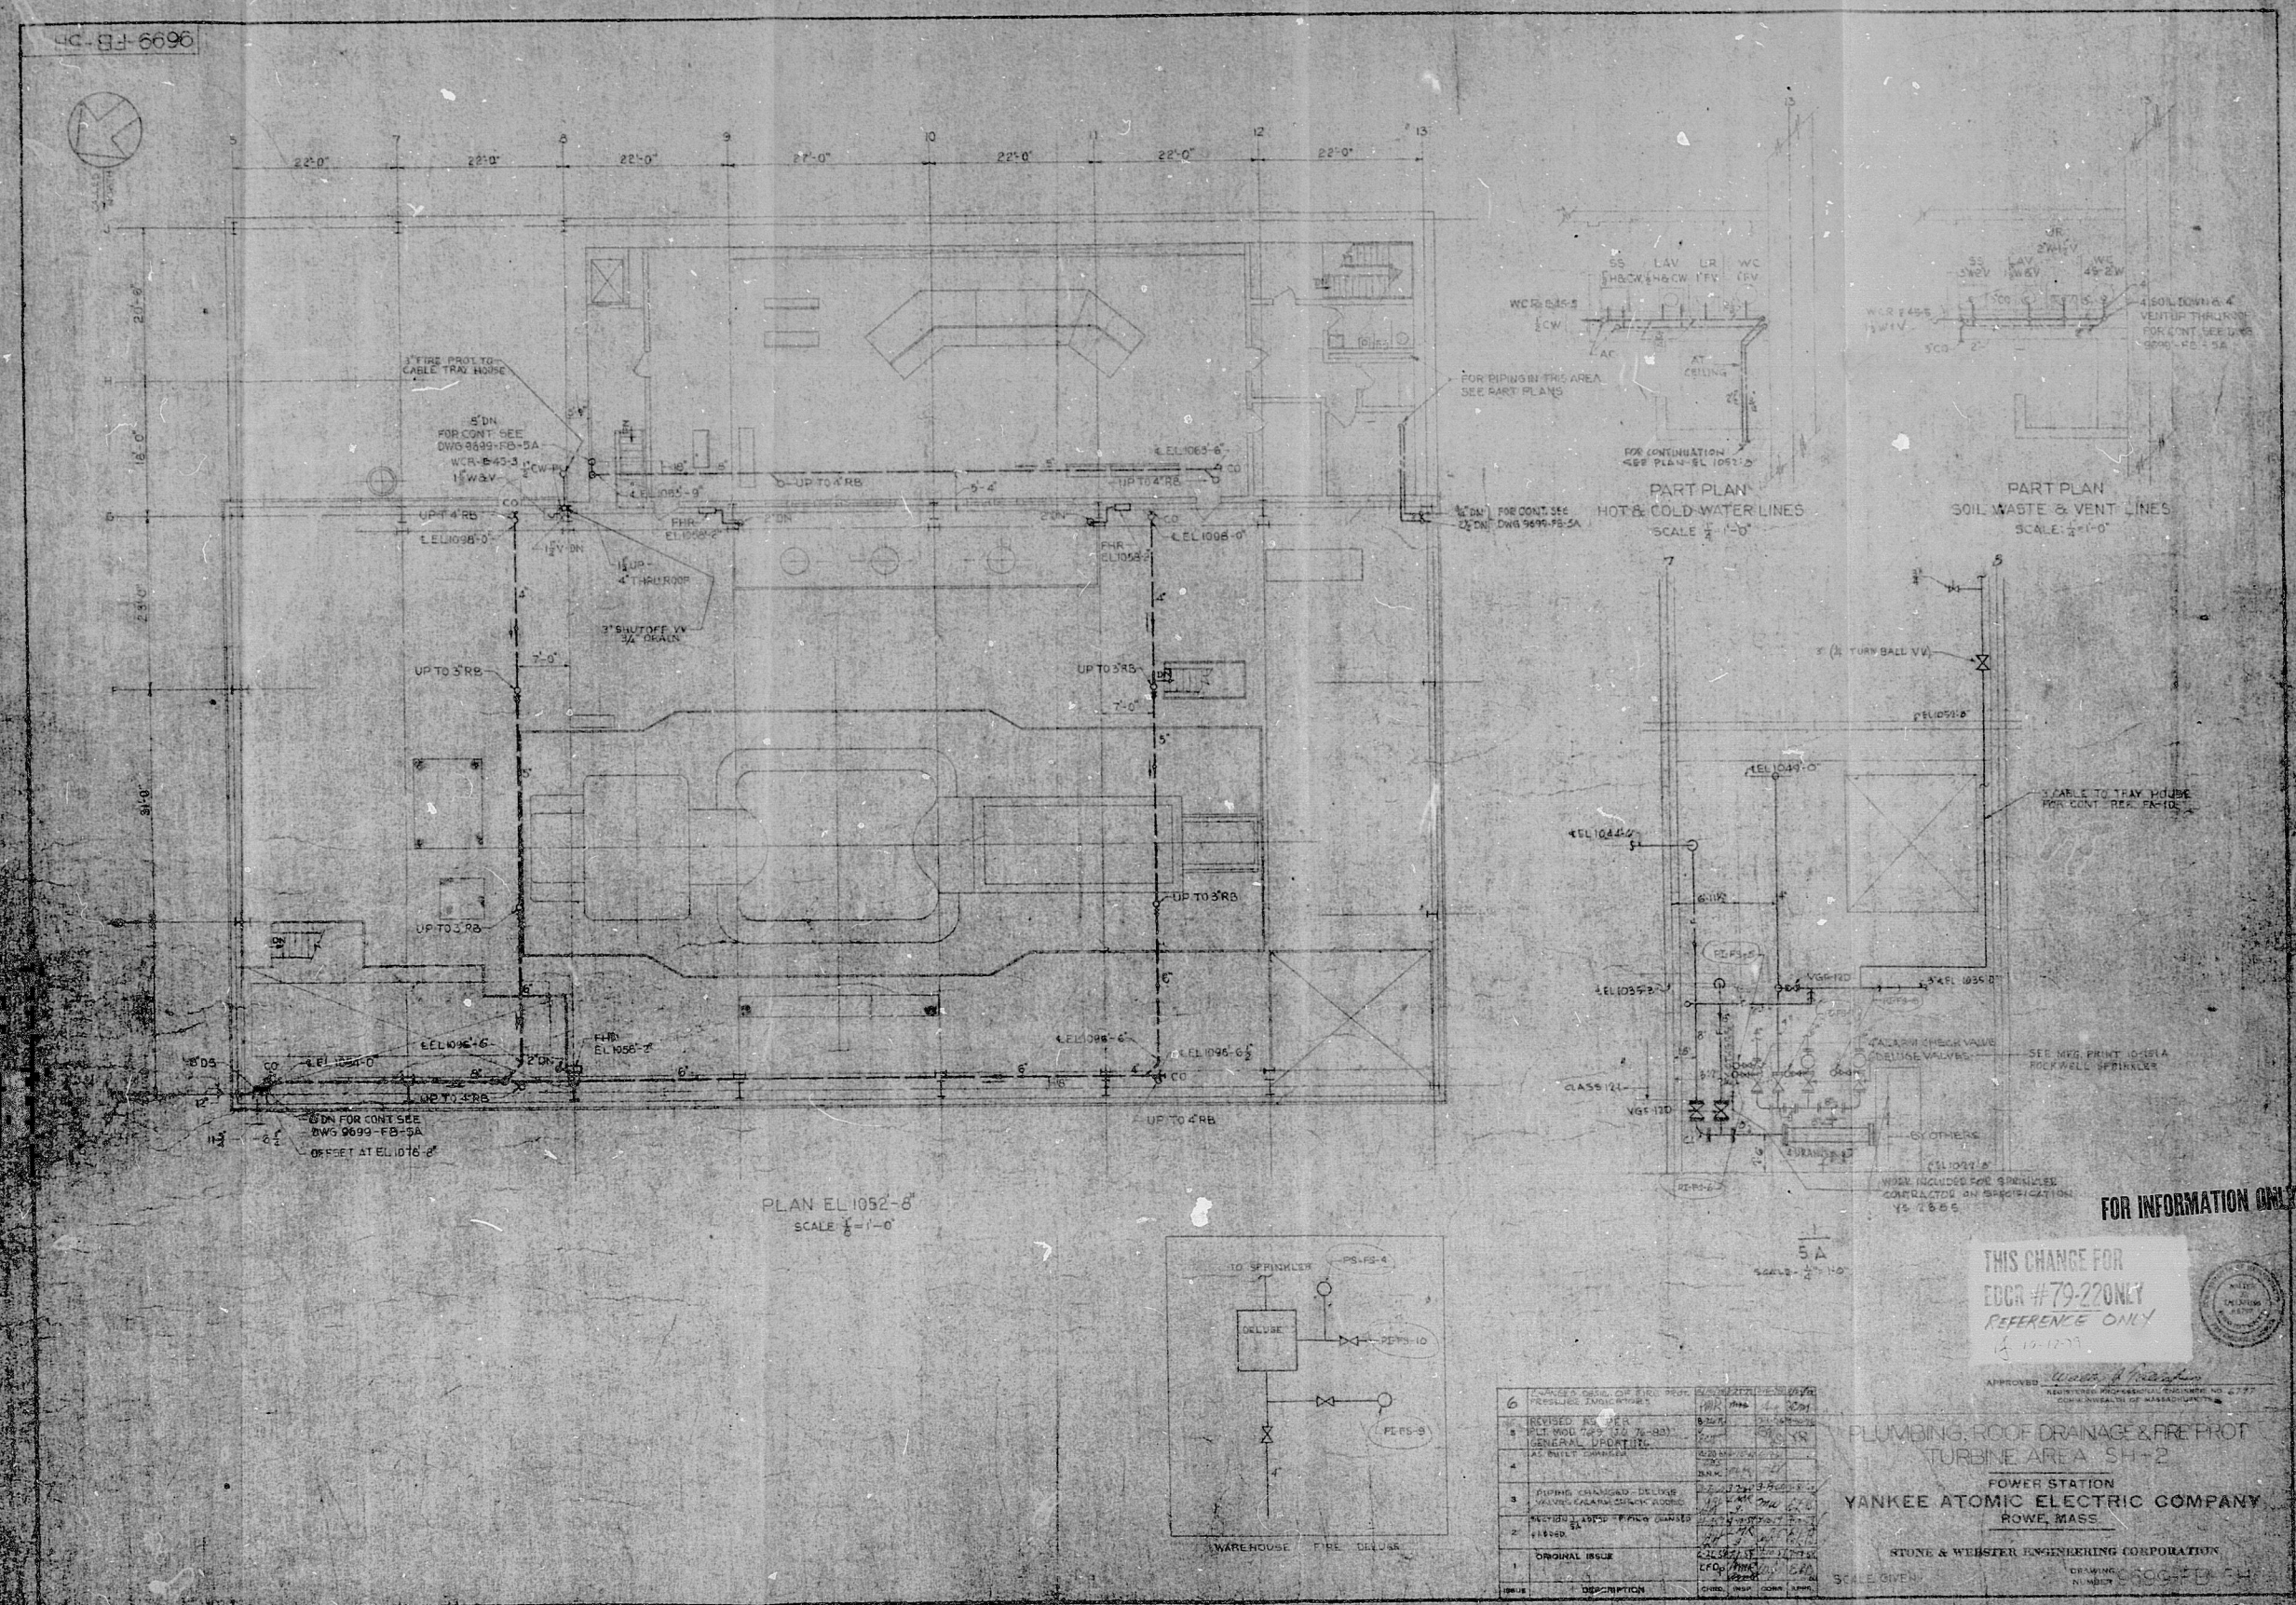

FOR INFORMATION ONLY

THIS CHANGE FOR  
EDCR #79-220 ONLY  
REFERENCE ONLY  
11-12-77

PLUMBING, ROOF DRAINAGE & FIRE PROT  
TURBINE AREA SH-2  
POWER STATION  
YANKEE ATOMIC ELECTRIC COMPANY  
ROWE, MASS.

STONE & WEBSTER ENGINEERING CORPORATION  
SCALE GIVEN  
DRAWING NUMBER 606-FB-CH

| NO. | DESCRIPTION    | DATE     | BY | CHKD. |
|-----|----------------|----------|----|-------|
| 1   | ORIGINAL ISSUE | 11-12-77 | SW | SW    |
| 2   | REVISION       | 11-12-77 | SW | SW    |
| 3   | REVISION       | 11-12-77 | SW | SW    |
| 4   | REVISION       | 11-12-77 | SW | SW    |
| 5   | REVISION       | 11-12-77 | SW | SW    |
| 6   | REVISION       | 11-12-77 | SW | SW    |

791200448

