


SETTLEMENT RECORD TABLE

Main settlement record table with columns for marker no., date, settlement measurements (e.g., 0-7, 7-10, 10-13), and marker identification (e.g., FIELD NO. 103B, FIELD NO. 104A).

LEGEND: N.I. = NOT INSTALLED, N.A. = NOT AVAILABLE, * = INITIAL SURVEYING CORRECTED, + = ORIGINAL MARKER DESTROYED

NOTES: 1. ELEVATION OF STRUCTURE COMPLETED TO DATE SHALL BE NOTED FOR EACH SETTLEMENT READING. 2. ALL SETTLEMENT MEASUREMENTS SHOWN ARE NEGATIVE, UNLESS PREFIXED BY A (+) SIGN.

TI APERTURE CARD

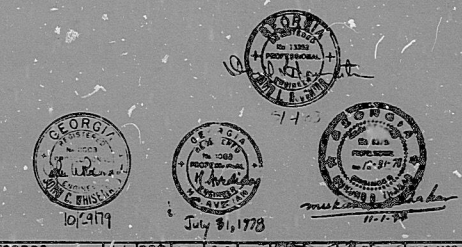

8410250026 DECHTEL 100 APERTURE GEORGIA POWER COMPANY ALVIN W. VOGTLE NUCLEAR PLANT

Revisions table with columns for revision no., date, description, and initials.

Vertical text on the left margin: 'This drawing and all data herein are the property of GEORGIA POWER COMPANY. They are not to be reproduced, copied, loaned, exhibited, or used in any way without the express written permission of the holder of the license.'

PDR RIDS

8410250026

