

CONTINUED ON DWG. AX255V023 (SHT. 9)
FOR MARKERS 232 THRU 275 ONLY


SETTLEMENT RECORD TABLE

NOTE: DATA FOR THESE MARKERS UNDER FIELD REPAIR

Main settlement record table with columns for marker number, date, and settlement measurements. Includes a section for 'DEWATERING MARKERS' at the bottom left.

LEGEND: N.I. = NOT INSTALLED, N.A. = NOT AVAILABLE, * = REVISION, etc.

TI APERTURE CARD

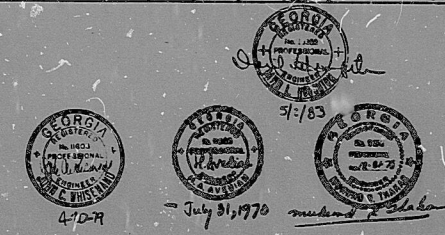

8410250032
DECTEL LOS ANGELES
GEORGIA POWER COMPANY
ALVIN W. VOGTLE NUCLEAR PLANT

Revisions table with columns for revision number, date, description, and initials.

I CERTIFY THAT THE MOST CURRENT OF THIS DRAWING HAS BEEN MADE IN ACCORDANCE WITH THE STANDARD PRACTICES OF THE PROFESSION OF SURVEYING.

PDR RIDS

8410250032

