



H-95-0 SHT 7

RCP 00C590

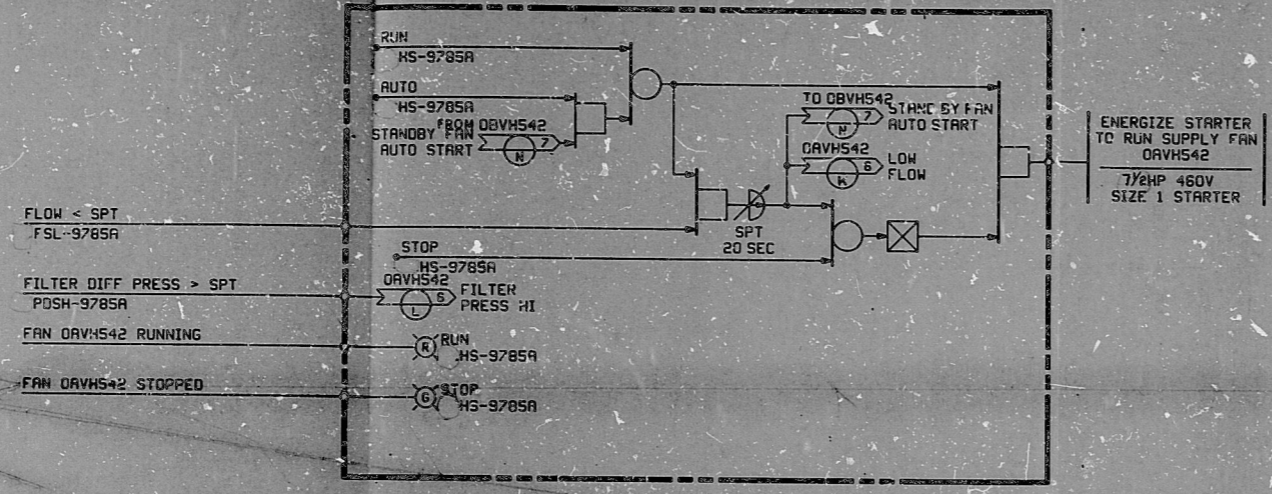

NOTES:
1. ALL EQUIPMENT SHOWN ON THIS SHEET IS NON-Q LISTED.

OAVH542 HEATER PANEL AT FLOOR

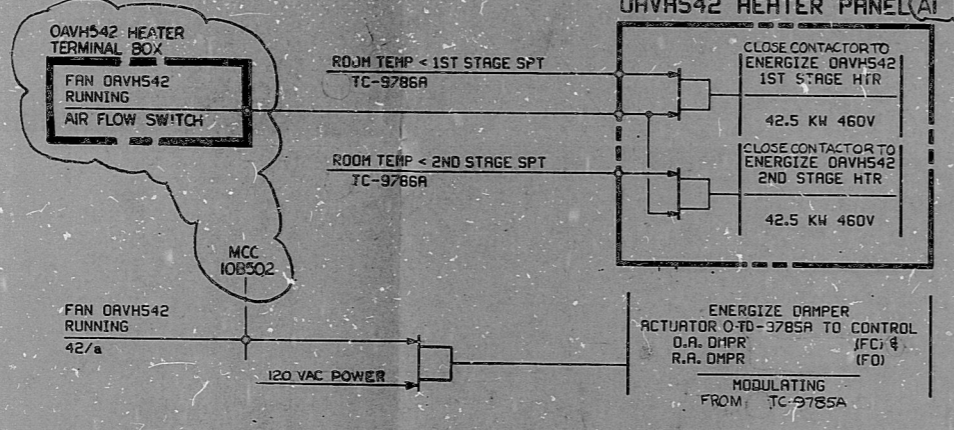

CIRC. WATER PUMP HOUSE SWITCHGEAR ROOM SUPPLY UNIT OAVH542

SUPPLY UNIT	CROSS REFERENCE TABLE			
	HS-, FSL-, POSH-, TD-, TC-	TC-	480 V. MCC (FAN)	480 V. SUBSTATION (HEATER)
ORVH542	9785A	9786A	108502	00B500
OBVH542	9785B	9786B	108503	00B590



PRO APERTURE CARD

1/14/83	REVISED AS NOTED	JGH	RCG	ES	RCG
2/12/83	REVISED AS NOTED, ISSUED FOR DESIGN FREEZE & UNIT 2 DELETION	JGH	RCG	ES	RCG
2/2/83	REVISED AS NOTED	JGH	RCG	ES	RCG
2/18/83	ISSUED FOR CONSTRUCTION	JGH	RCG	ES	RCG

BECHTEL
SAN FRANCISCO

PUBLIC SERVICE ELECTRIC AND GAS COMPANY
HOPE CREEK GENERATING STATION

LOGIC DIAGRAM
MISC STRUCTURES & YARD BLDGS
CIRC. WTR. PUMPHOUSE SWITCHGEAR ROOM UNITS

JOB No.	DRAWING No.	REV.
10855	H-95-0 SHT 7	3

S/U - GF

THIS DRAWING AND THE DESIGN IT COVERS ARE THE PROPERTY OF BECHTEL. THEY ARE LOANED TO YOU BY THE BORROWER'S EXPRESS AGREEMENT AND THEY WILL NOT BE REPRODUCED, COPIED, LOANED, ASSIGNED, OR USED OUTSIDE OF THE LIMITED WAY AND PURPOSES PERMITTED BY ANY WRITTEN CONSENT GIVEN BY THE LENDER TO THE BORROWER.

RIDS

830725027

