



H-92-0 SHT 6

REMOTE CONTROL PANEL OC381

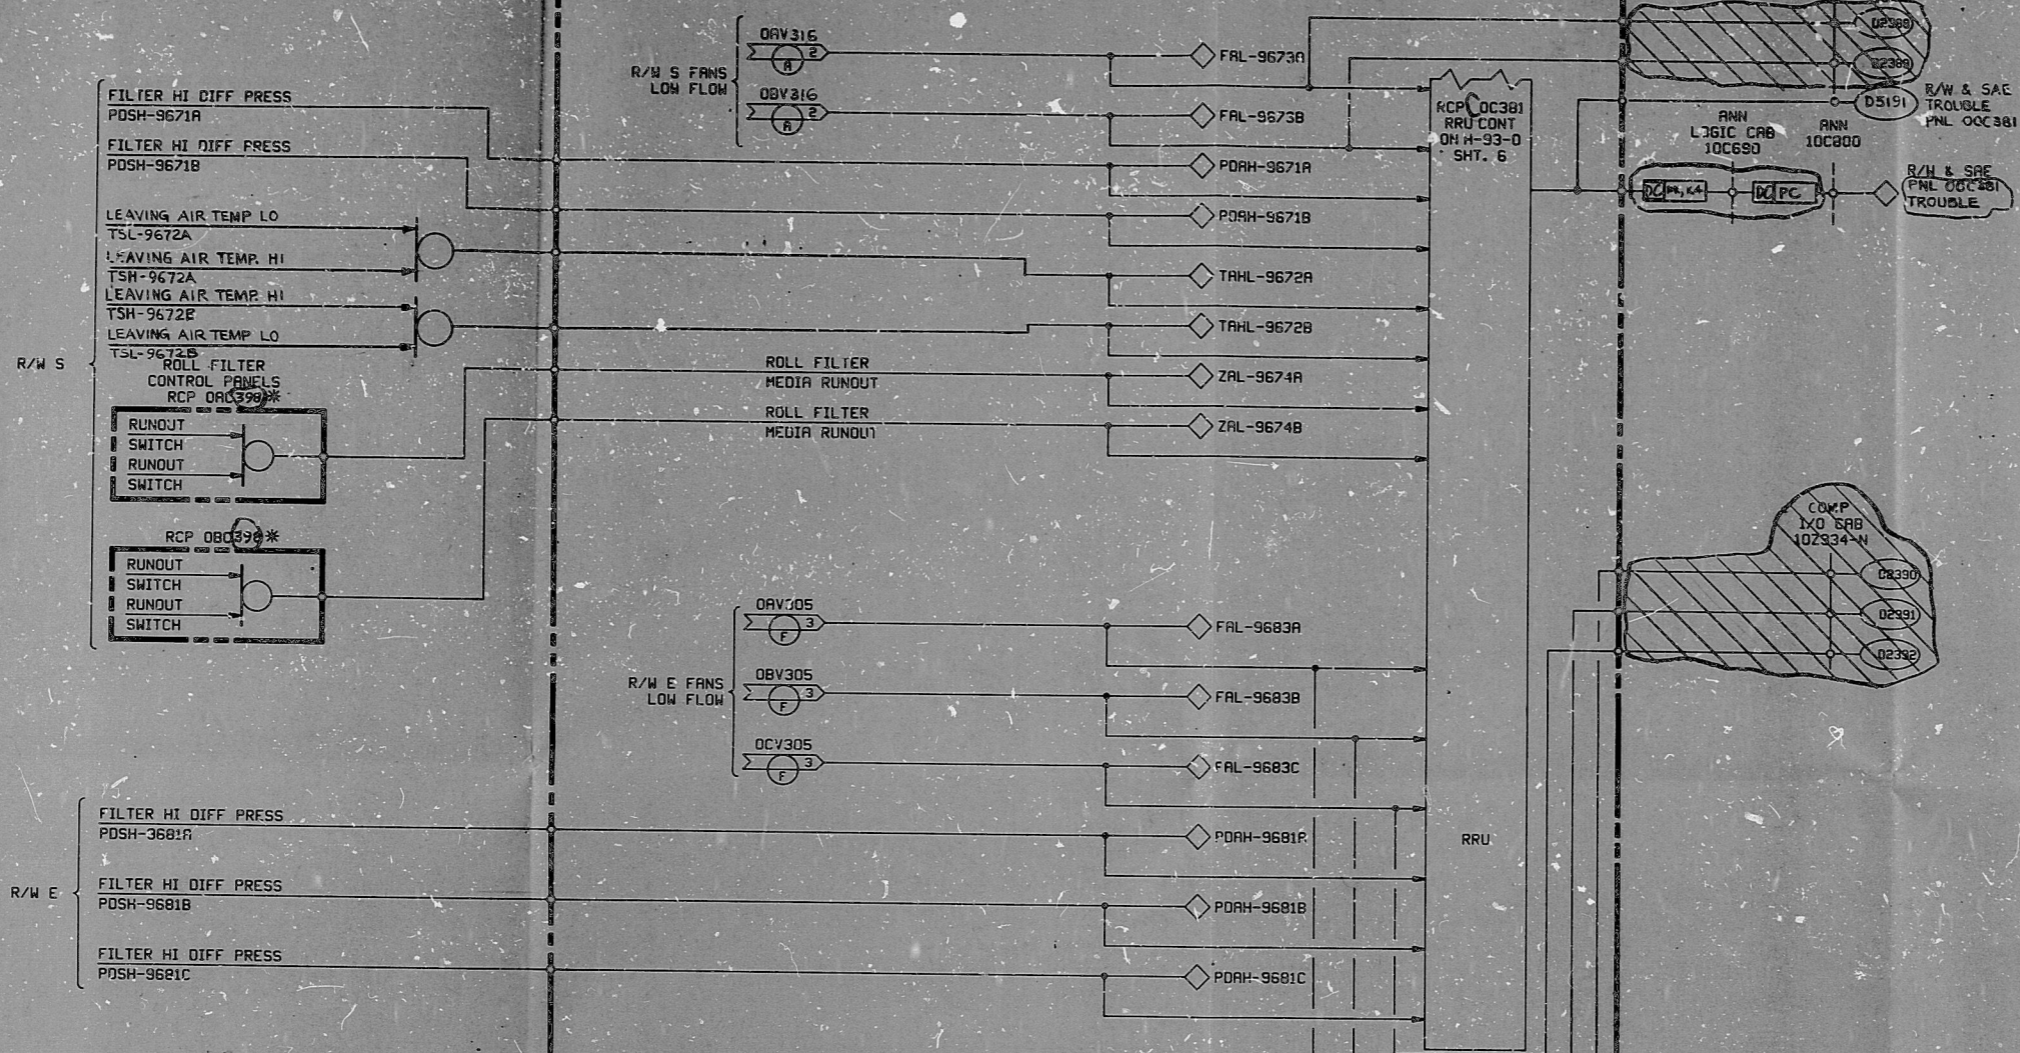

REMOTE CONTROL PANEL OC385

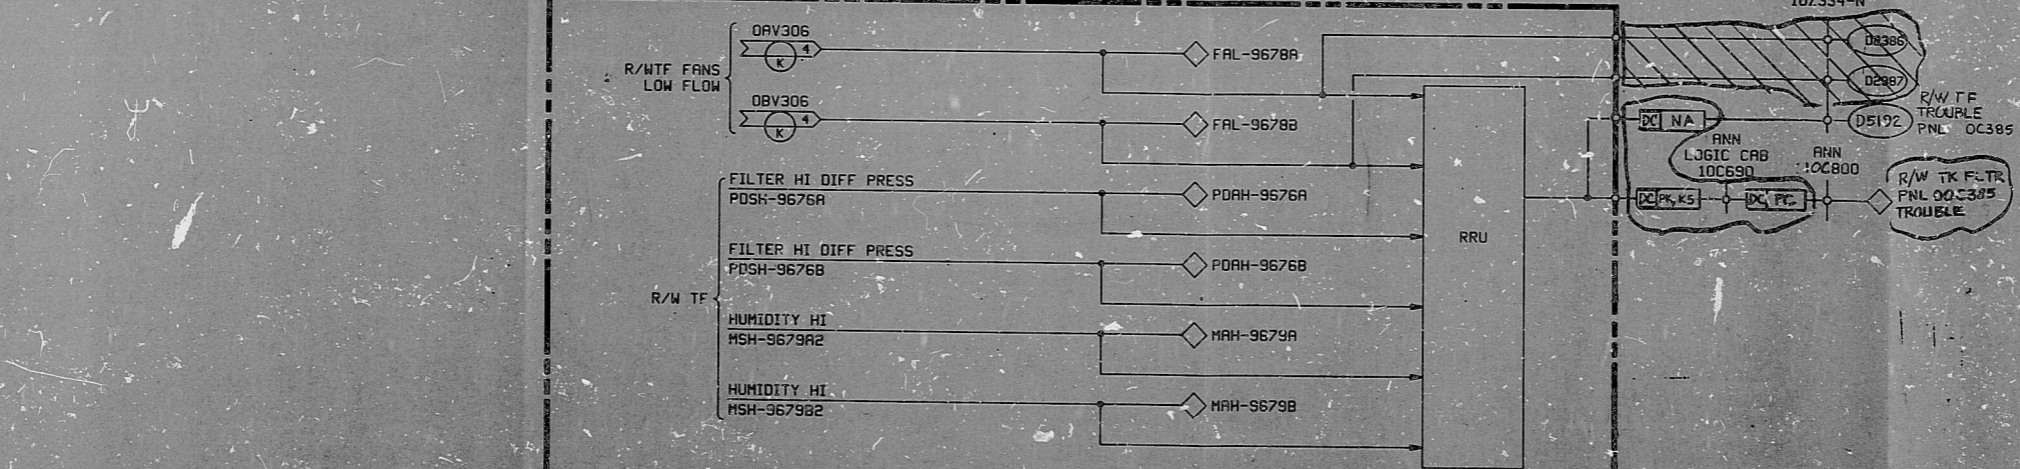

This drawing and the design it covers are the property of BECHTEL. They are hereby loaned and on the borrower's express agreement that they will not be reproduced, copied, loaned, exhibited, nor used, except in the limited way and phrase use permitted by any written statement given by the lender to the borrower.

P/R
APERTURE
CARD

NO.	DATE	REVISIONS	BY	CHKD	DESIGN	DRW	APPV
1	5/15/81	DESIGN COMPLETE POINTS PER COST PRODUCTION ITEM 23 AND REVISED AS NOTED					
2	5/15/81	DESIGN SHEETS ISSUE DELETED UNIT 2; REVISED AS NOTED					
3	5/27/81	REVISED AS NOTED					
4	5/27/81	REARRANG AND REVISED AS NOTED					
5	5/27/81	REVISED AS NOTED					
6	5/27/81	ISSUED FOR CONSTRUCTION					

SCALE: NONE DESIGNED: LK/598 DRAWN: RCG

BECHTEL
SAN FRANCISCO

PUBLIC SERVICE ELECTRIC AND GAS COMPANY
HOPE CREEK GENERATING STATION

LOGIC DIAGRAM
ALARMARY 9L3 RADWASTE AREA
ALARMS

JOB No.	DRAWING No.	REV.
10885	H-92-0 SHT 6	6

S/U-6H

RIDS

8307250547

