
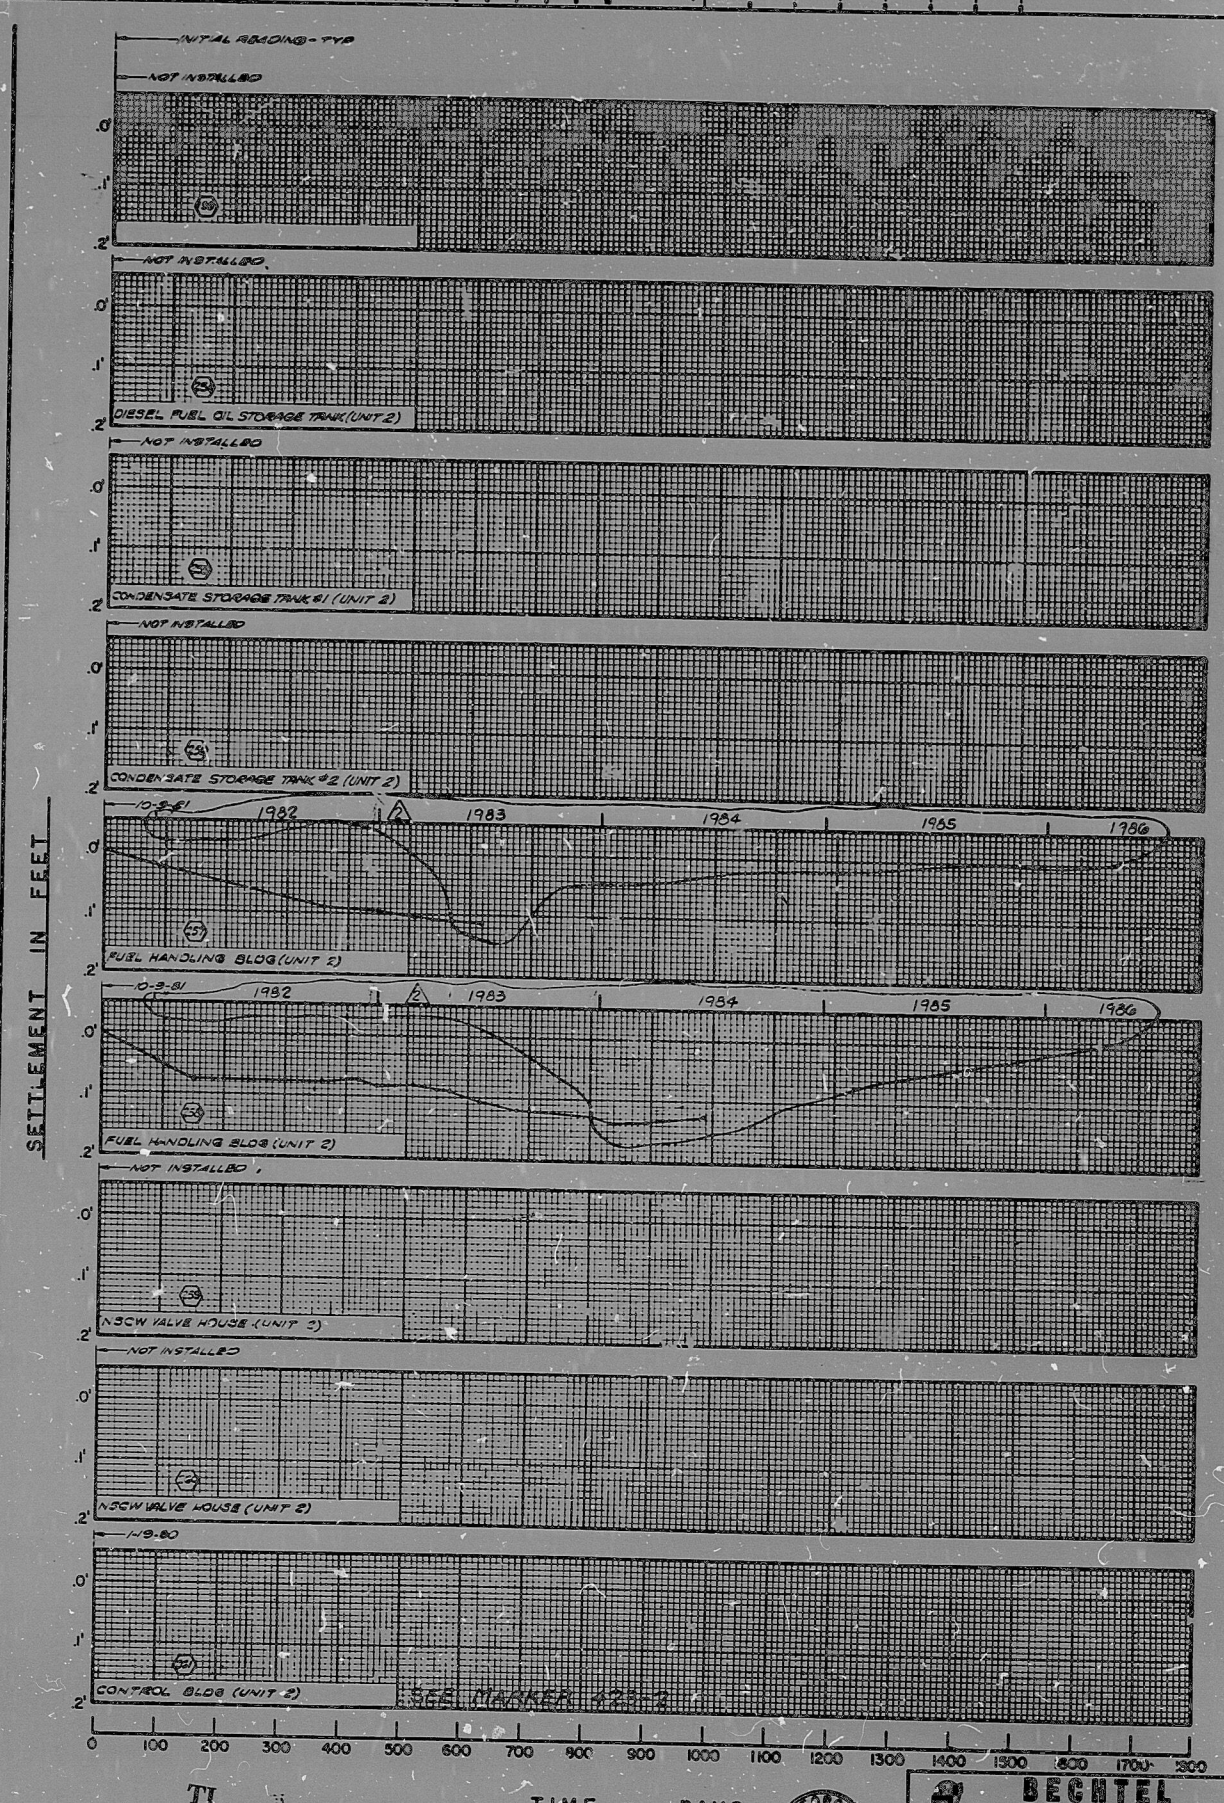


NO.	REVISIONS	DATE	DR.	CHK.	SUPV.	EGS	CHK.	P.E.	DATE	NO.
1										
2										
3										
4										
5										
6										
7										

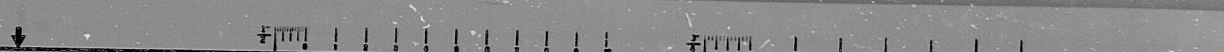

NO.	REVISIONS	DATE	DR.	CHK.	SUPV.	EGS	CHK.	P.E.	DATE	NO.
1										
2										
3										
4										
5										
6										
7										

BECHTEL
LOS ANGELES

GEORGIA POWER COMPANY
ALVIN W. VOGTLE NUCLEAR PLANT

SETTLEMENT OBSERVATION MARKERS
GRAPHIC SHEET 10

SCALE: NONE

DRAWING NO. A7255V013

REV. 2

JOB NO. 9828

DATE

10/22/83

8410250127

PDR RIDS

8410250127

