


DATE	RELEASED FOR	REVISION

NOTES:
 1. ALL CHANGES OF BUS CHANNEL, RECORDERS, CONTROLS, CONT. ED. SUBSTA. & STA. SERVICE ASSY. (FRONT)
 2. ALL CHANGES OF BUS CHANNEL, RECORDERS, CONTROLS, CONT. ED. SUBSTA. & STA. SERVICE ASSY. (REAR)
 3. ALL CHANGES OF BUS CHANNEL, RECORDERS, CONTROLS, CONT. ED. SUBSTA. & STA. SERVICE ASSY. (FRONT)
 4. ALL CHANGES OF BUS CHANNEL, RECORDERS, CONTROLS, CONT. ED. SUBSTA. & STA. SERVICE ASSY. (REAR)
 5. ALL CHANGES OF BUS CHANNEL, RECORDERS, CONTROLS, CONT. ED. SUBSTA. & STA. SERVICE ASSY. (FRONT)
 6. ALL CHANGES OF BUS CHANNEL, RECORDERS, CONTROLS, CONT. ED. SUBSTA. & STA. SERVICE ASSY. (REAR)

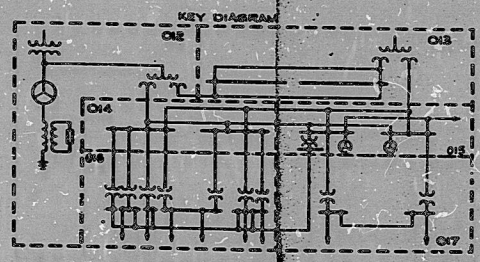

10	AS BUILT PER MAR 01-8-34-01		
9	AS BUILT PER MAR 01-8-34-01		
8	AS BUILT PER MAR 01-8-34-01		
7	ADDED 10% HI ACCURACY GENERATION METERING		
6	REVISED AS INDICATED IN PLACE		
5	REVISED AS INDICATED IN PLACE		
4	AS BUILT PER MAR 01-8-34-01		
3	AS BUILT PER MAR 01-8-34-01		
2	AS BUILT PER MAR 01-8-34-01		
1	AS BUILT PER MAR 01-8-34-01		

FLORIDA POWER CORPORATION
 ST. PETERSBURG, FLORIDA
CRYSTAL RIVER PLANT
 UNIT NO. 3 833,000 KW
 ELECTRICAL
 ONE LINE DIAGRAM
 GENERATION & RELAYING
 GENERATOR

DESIGNED BY: CHECKED BY: APPROVED BY: DATE: 2-13-50

4203 C-206-012 EC-206-012

PDR RIDS

Q902100073

