


J-69-0 SHT. 9

This drawing and the design it covers are the property of BECHTEL. They are merely loaned and on the borrower's express agreement that they will not be reproduced, copied, loaned, exhibited nor used except in the limited way and private use permitted by any written consent given by the lender to the borrower.

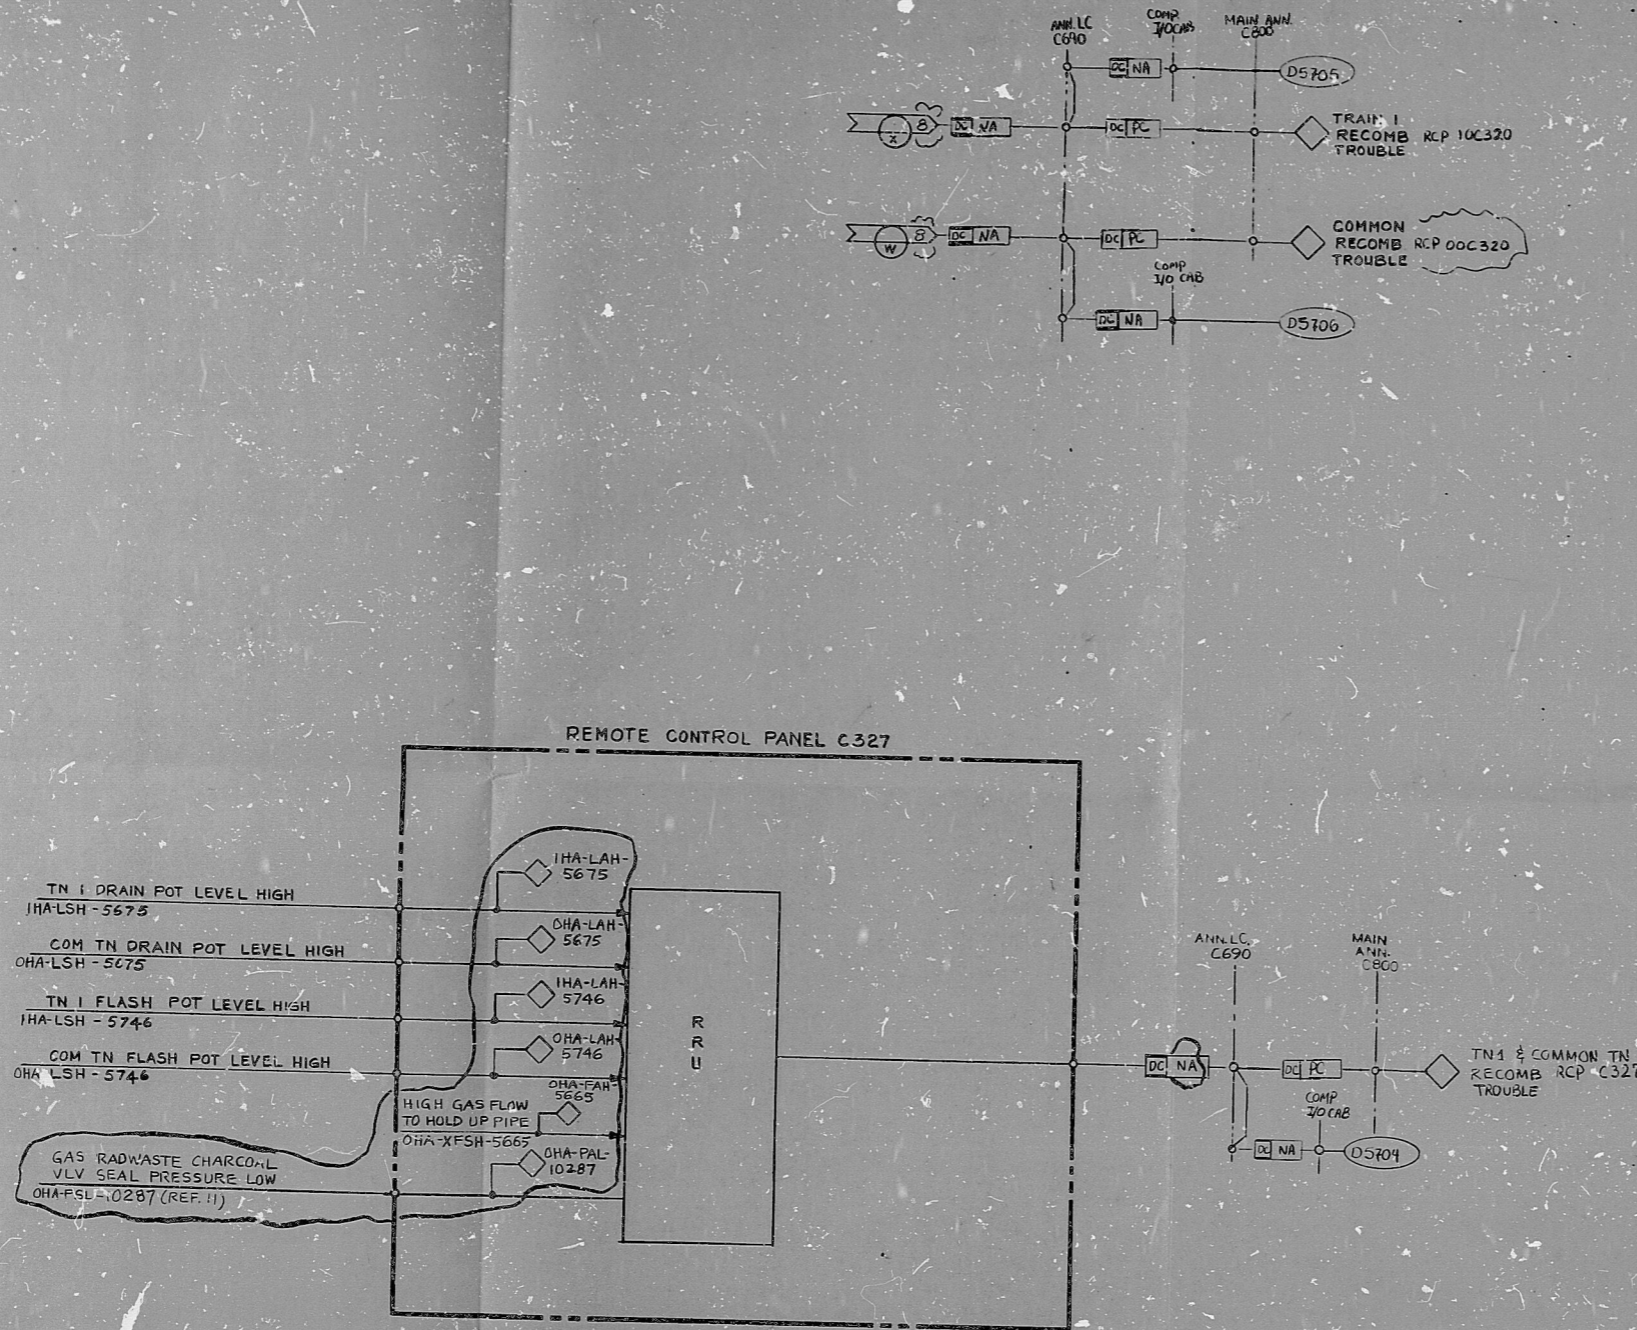

- NOTES:
1. DELETED
 2. DELETED
 3. DELETED

PRO APERTURE CARD

| No. | Date | Revisions | By | Chkd | Design | Engr | Proj | Appr |
|-----|----------|-------------------------------|-----|------|--------|------|------|------|
| 1 | 11/26/78 | REVISED AS NOTED TO ADD LOGIC | DES | TD | W | | | |
| 2 | 1/12/79 | REMOVED FROM DESIGN PACKAGE | | | | | | |
| 3 | 1/12/79 | DESIGN FREEZE ISSUE #1 | | | | | | |
| 4 | 1/12/79 | DELETED UNIT 2 | | | | | | |
| 5 | 1/12/79 | REVISED BAILEY INTERFACE | | | | | | |
| 6 | 1/12/79 | AS NOTED | | | | | | |
| 7 | 1/12/79 | REVISED AS NOTED | | | | | | |
| 8 | 1/12/79 | REVISED AS NOTED | | | | | | |
| 9 | 1/12/79 | ISSUED FOR CONSTRUCTION | | | | | | |

SCALE: NONE DESIGNED: MJV DRAWN: RCG

BECHTEL
SAN FRANCISCO

PUBLIC SERVICE ELECTRIC AND GAS COMPANY
HOPE CREEK GENERATING STATION

LOGIC DIAGRAM
GASEOUS RADWASTE RECOMBINATION
SYSTEM ALARM

| JOB No. | DRAWING No. | REV. |
|---------|---------------|------|
| 10855 | J-69-0 SHT. 9 | 5 |

SJU-HA

RIDS

8307250563

