


MATCH LINE SEE DWG E-215-061

N

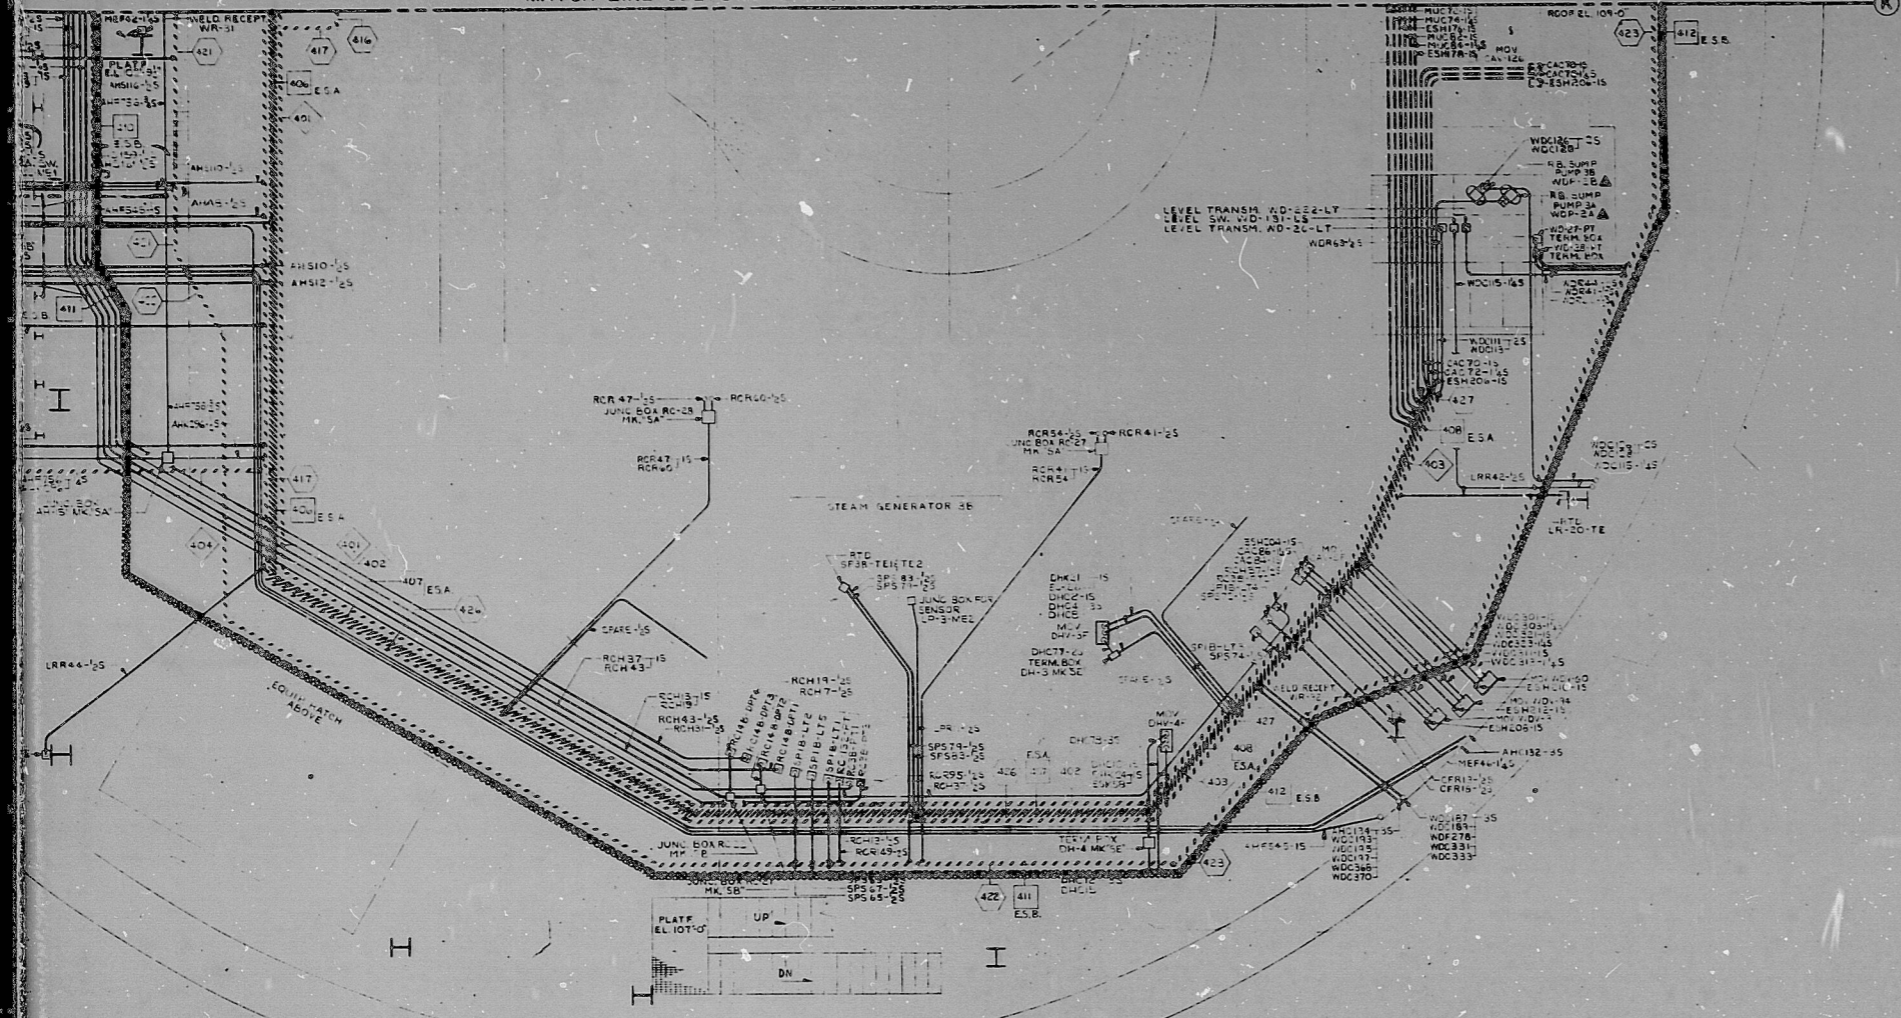

CHANGE IN PROGRESS
DUE TO
M.A.R./R.E.I. 79-5-75

CHANGE IN PROGRESS
DUE TO
M.A.R./R.E.I. 79-1-23

CHANGE IN PROGRESS
DUE TO
M.A.R./R.E.I. 79-10-12

NOTES:
1. SEE DETAIL 1, DRAWING E-215-041.

REFERENCES:
E-215-061 CONDUIT LAYOUT REACTOR BLDG. EL. 95'-0" NORTH
E-215-064 CONDUIT LAYOUT REACTOR BLDG. EL. 119'-0" SOUTH
E-215-143 SHEET 1-14 E.S. 2 COLOR CONDUIT SCHEDULE

NO.	REVISION	BY	DATE
10	REVISED AS INDICATED AS PER E-215-057A
9	REVISED AS INDICATED 3 PLACES
8	REVISED AS INDICATED 3 PLACES
7	REVISED AS INDICATED 2 PLACES
6	REVISED AS INDICATED 1 PLACE
5	REVISED AS INDICATED 1 PLACE
4	REVISED AS INDICATED 2 PLACES
3	REVISED AS INDICATED 2 PLACES
2	REVISED AS INDICATED 2 PLACES
1	REVISED AS INDICATED 5 PLACES

FLORIDA POWER CORPORATION
ST. PETERSBURG, FLORIDA
CRYSTAL RIVER PLANT
UNIT NO. 3 835,000 KW
ELECTRICAL
CONDUIT LAYOUT
REACTOR BUILDING-ELEV. 95'-0" SOUTH

CONSTRUCTION	2/1/79
LIMITED CONSTRUCTION AS NOTED	
PRELIMINARY NOT FOR CONSTRUCTION	
ISSUING PURPOSES ONLY	
DATE	RELEASED FOR

CHLDBY ASSOCIATES, INC.
ENGINEERS AND CONSULTANTS

APPROVED
FOR CONSTRUCTION BY
FLORIDA POWER CORPORATION

6203 10 E-215-061

791230471

CF

7912130471

