


H-93-0 SH 5

REMOTE CONTROL PANEL 00C181

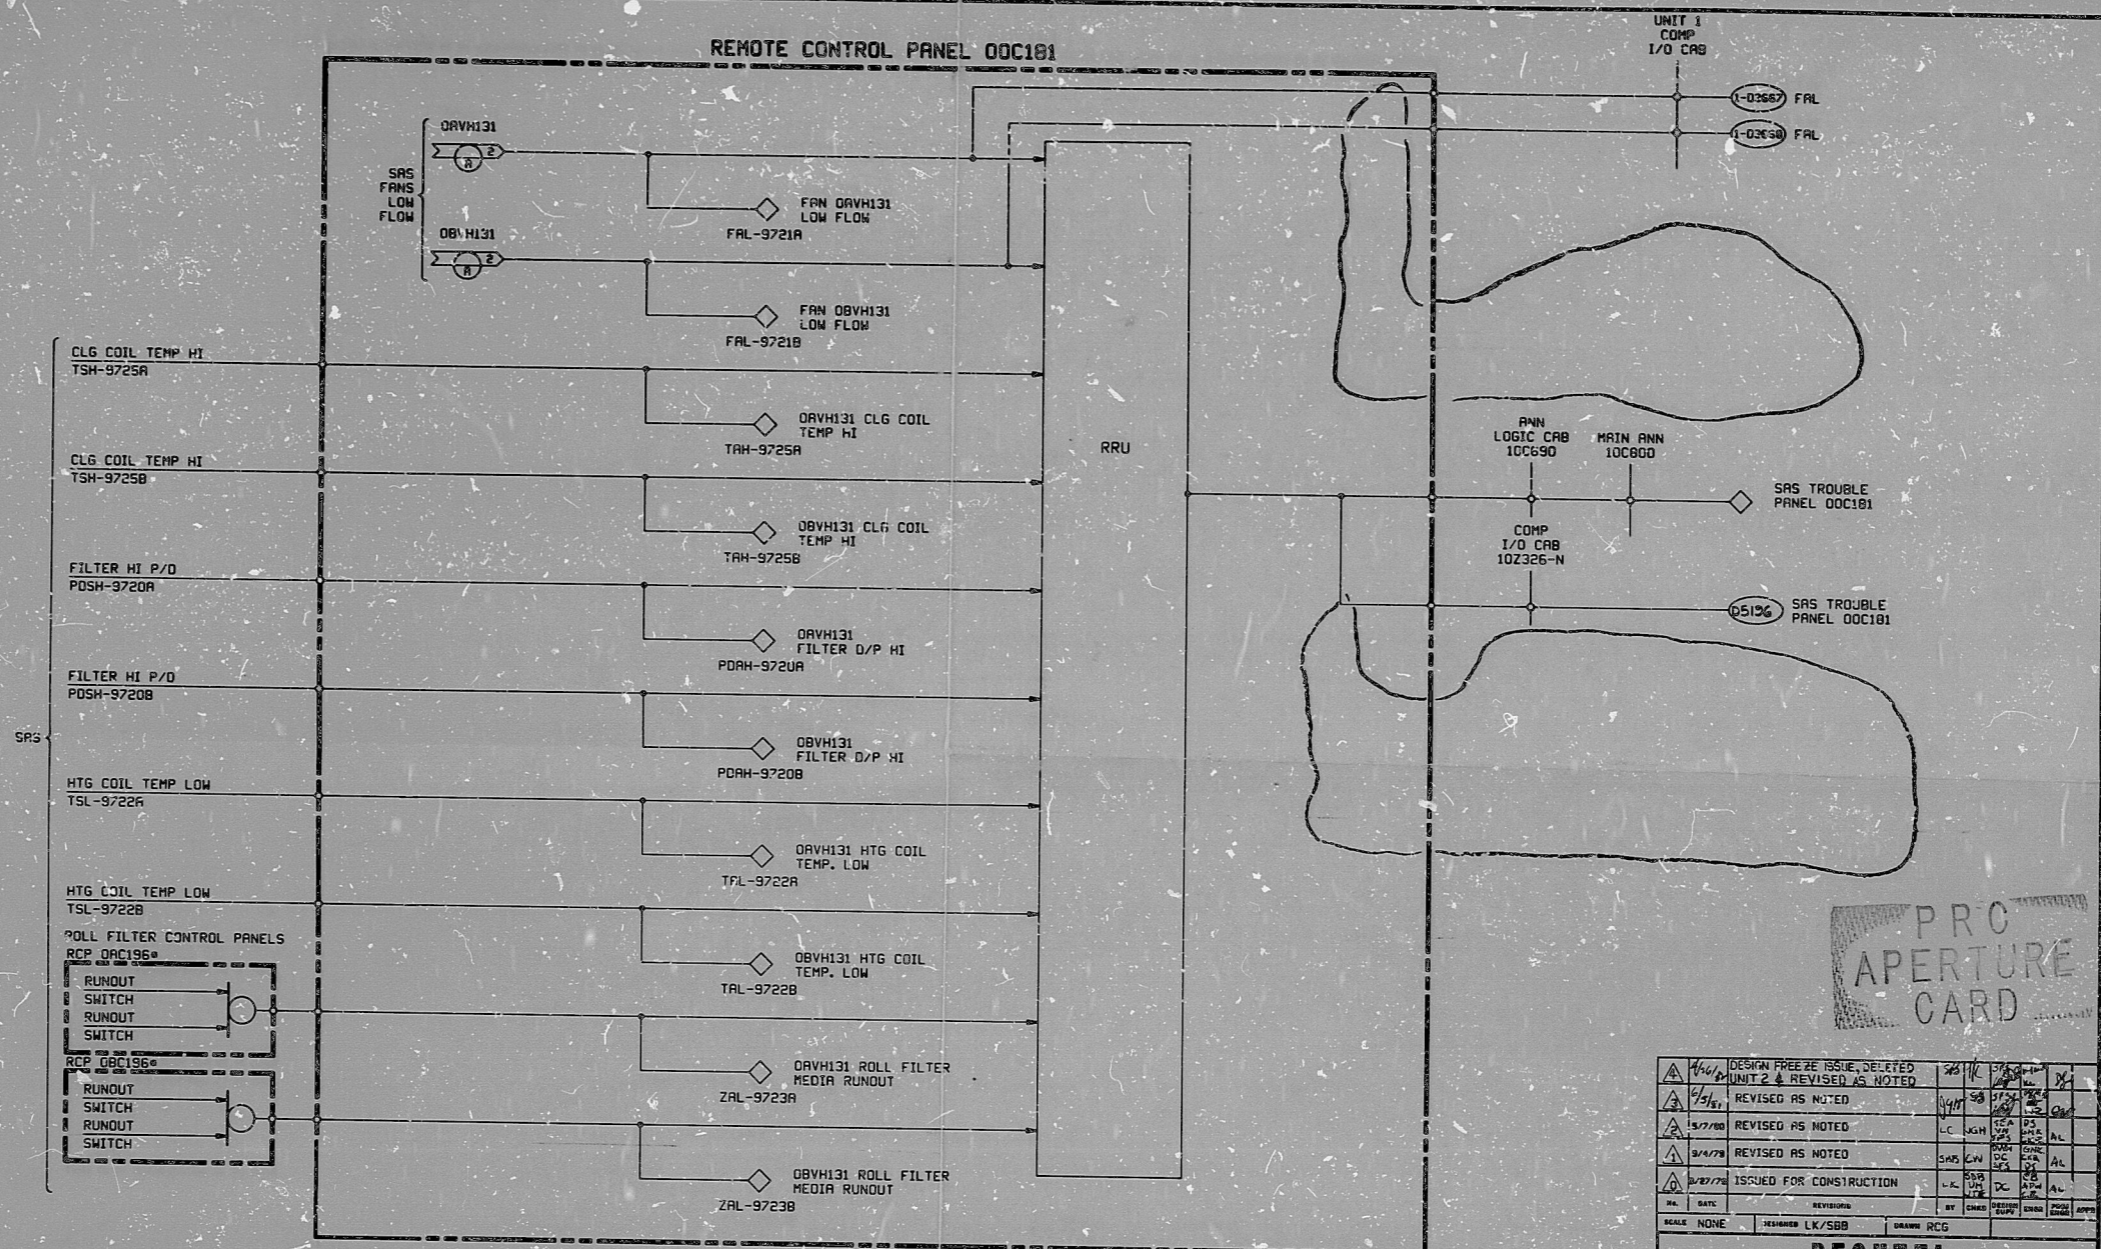

ALARMS 00C181

This drawing and the design it covers are the property of BECHTEL. They are hereby loaned and not to be reproduced, copied, loaned, exhibited, nor used except in the limited way and under conditions provided by any written consent given by the holder of this document.

PRO APERTURE CARD

4/14/77	DESIGN FREEZE ISSUE, DELAYED UNIT 2 & REVISED AS NOTED	SA	MR	DC	AL
4/21/77	REVISED AS NOTED	SA	MR	DC	AL
5/7/77	REVISED AS NOTED	SA	MR	DC	AL
5/14/77	REVISED AS NOTED	SA	MR	DC	AL
5/27/77	ISSUED FOR CONSTRUCTION	SA	MR	DC	AL

BECHTEL
SAN FRANCISCO
PUBLIC SERVICE ELECTRIC AND GAS COMPANY
HOPE CREEK GENERATING STATION

LOGIC DIAGRAM
AUXILIARY BLDG. - SERVICE AREA
ALARMS-00C181

NO.	DATE	REVISION	BY	CHKD	APP'D
SCALE	NONE	REVISION	LK/SBB	DATE	RCG

JOB No. 10855 DRAWING No. H-93-0 SH 5 4

SU-GL

24X

I certify that the microfilm image contained on this microform were made in the normal and regular course of business. This is a true, full correct and complete reproduction and replacement for and/or in lieu of original documents generated by the Bechtel group of companies.
Signed: DANNY Camera Operator Date: 4-27-82 Camera Type: MRG 1

RIDS

8307250597

