


J-10-0 SHT. 9

LOGIC CABINET AC-652

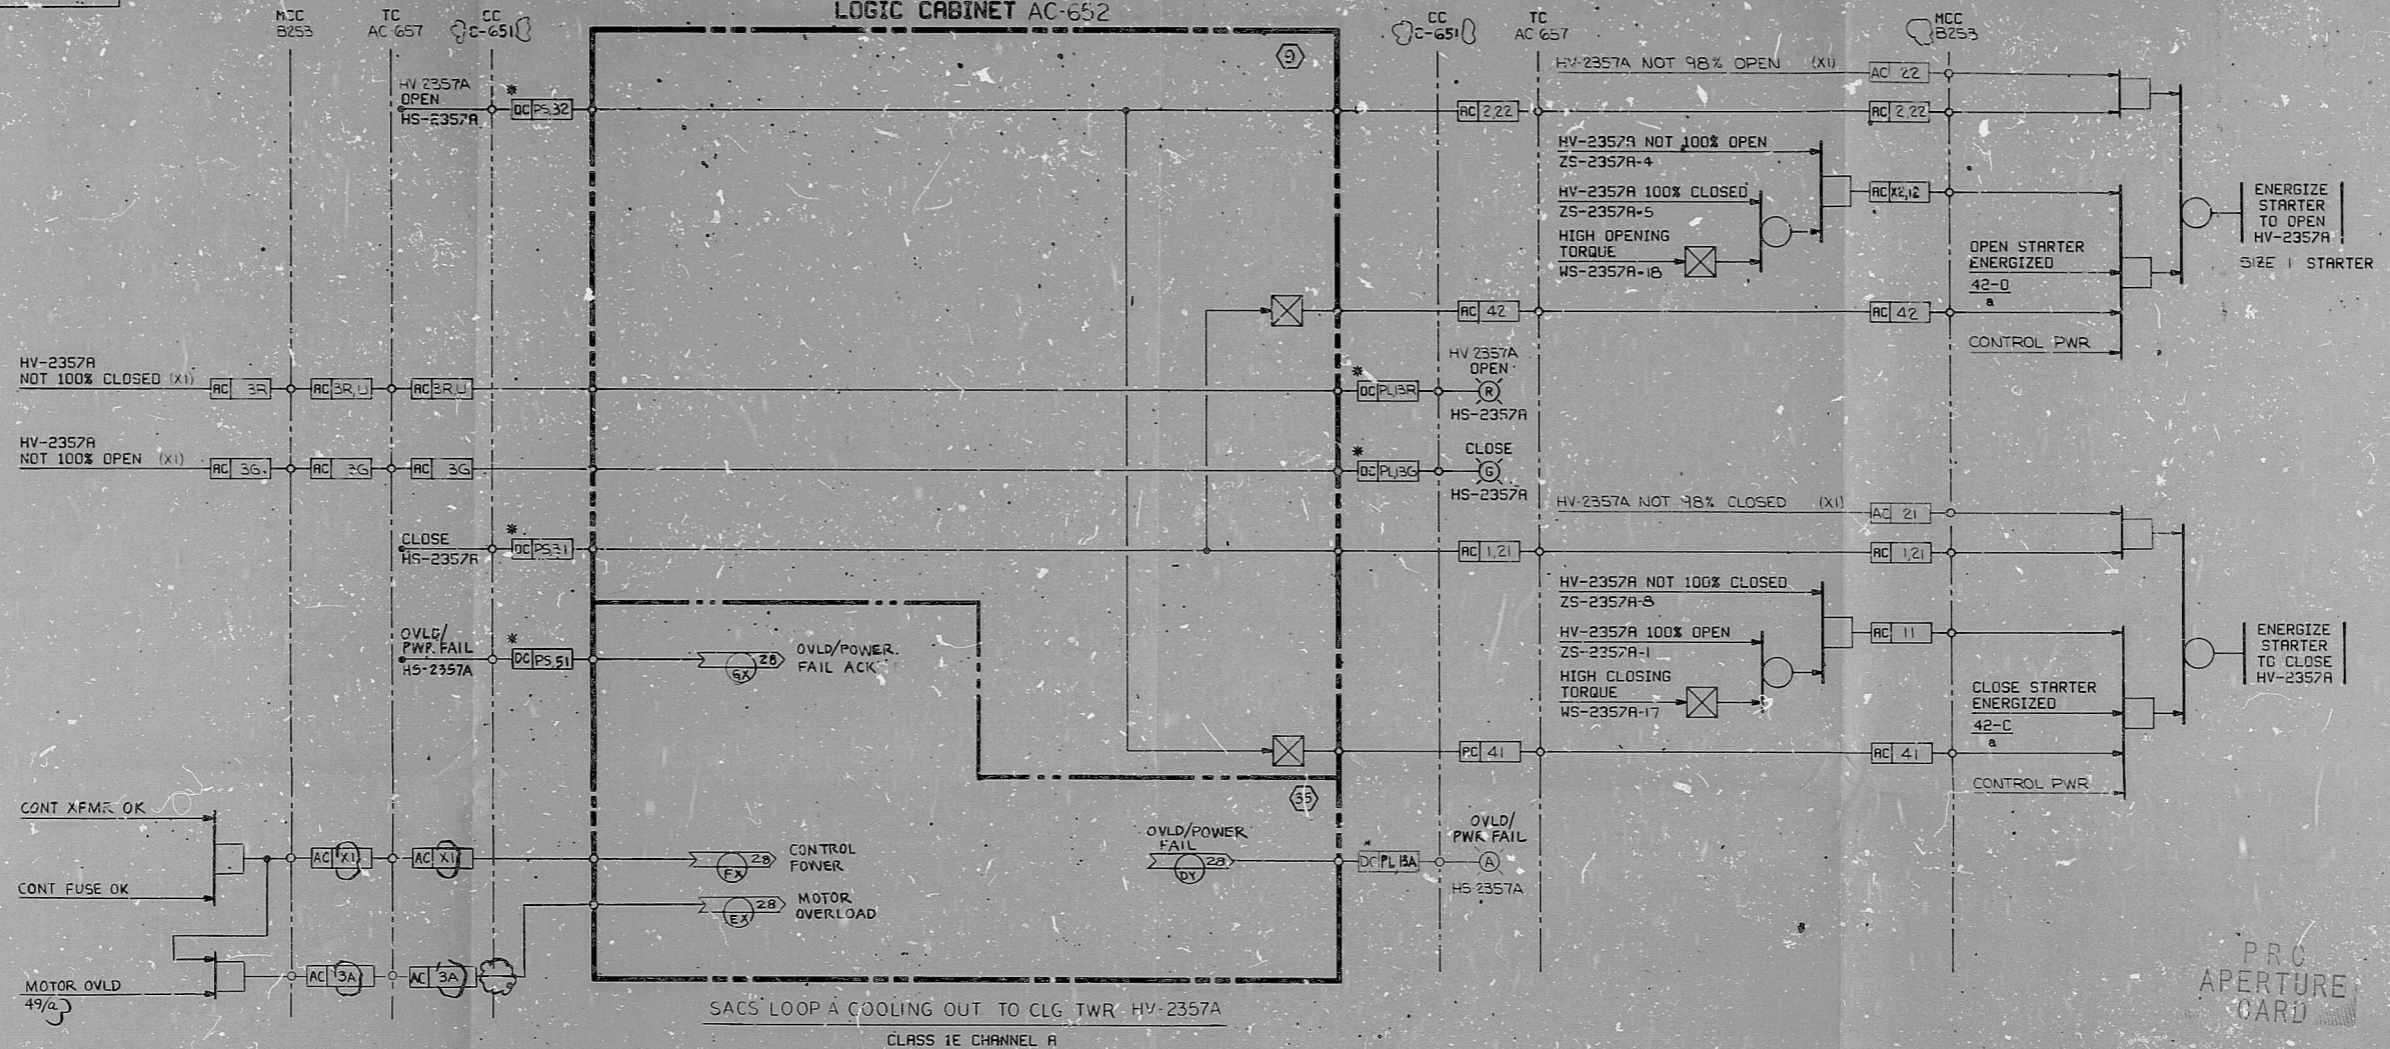

SACS LOOP A COOLING OUT TO CLG TWR HV-2357A  
CLASS 1E CHANNEL A

This drawing and the design it covers are the property of BECHTEL. They are hereby loaned and on the borrower's express agreement that they will not be reproduced, copied, loaned, exhibited, nor used except in the limited way and private use permitted by any written consent given by the lender to the borrower.

|                    |                       |
|--------------------|-----------------------|
| OVLDT/PWR FAIL (A) |                       |
| HV-2357A           |                       |
| HV 2357A OPEN (R)  |                       |
| CLOSE (G)          | CONTROL CONSOLE C651A |
| MOMENTARY          |                       |

|         |                                       |    |    |    |    |    |
|---------|---------------------------------------|----|----|----|----|----|
| 4/17/82 | DESIGN FREEZE ISSUE                   | RF | JS | ES | GH | FK |
| 4/18/82 | REVISED BAILEY INTERFACE AND AS NOTED | AM | ca | ca | ca | ca |
| 5/1/82  | REVISED AS NOTED                      | DL | ca | ca | ca | ca |
| 5/1/82  | REVISED AS NOTED                      | DL | ca | ca | ca | ca |
| 5/1/82  | REVISED AS NOTED                      | DL | ca | ca | ca | ca |
| 5/1/82  | ISSUED FOR CONSTRUCTION               | DL | ca | ca | ca | ca |
| 5/1/82  | ISSUED FOR CONSTRUCTION               | DL | ca | ca | ca | ca |
| 5/1/82  | ISSUED FOR CONSTRUCTION               | DL | ca | ca | ca | ca |

SCALE: NONE

DESIGNED: PWW

DRAWN: FAT

BECHTEL  
SAN FRANCISCO

PUBLIC SERVICE ELECTRIC AND GAS COMPANY  
HOPE CREEK GENERATING STATION

LOGIC DIAGRAM  
STATION SERVICE WATER SYSTEM  
SACS LOOP A COOLING OUT TO CLG TWR HV-2357A

|         |               |      |
|---------|---------------|------|
| JOB No. | DRAWING No.   | REV. |
| 10855   | J-10-0 SHT. 9 | 5 Q  |

S/U - EA

22 X 34 10" SIZE

RIDS

8307250711

