


J-10-0 SHT. 14

LOGIC CABINET AC-652

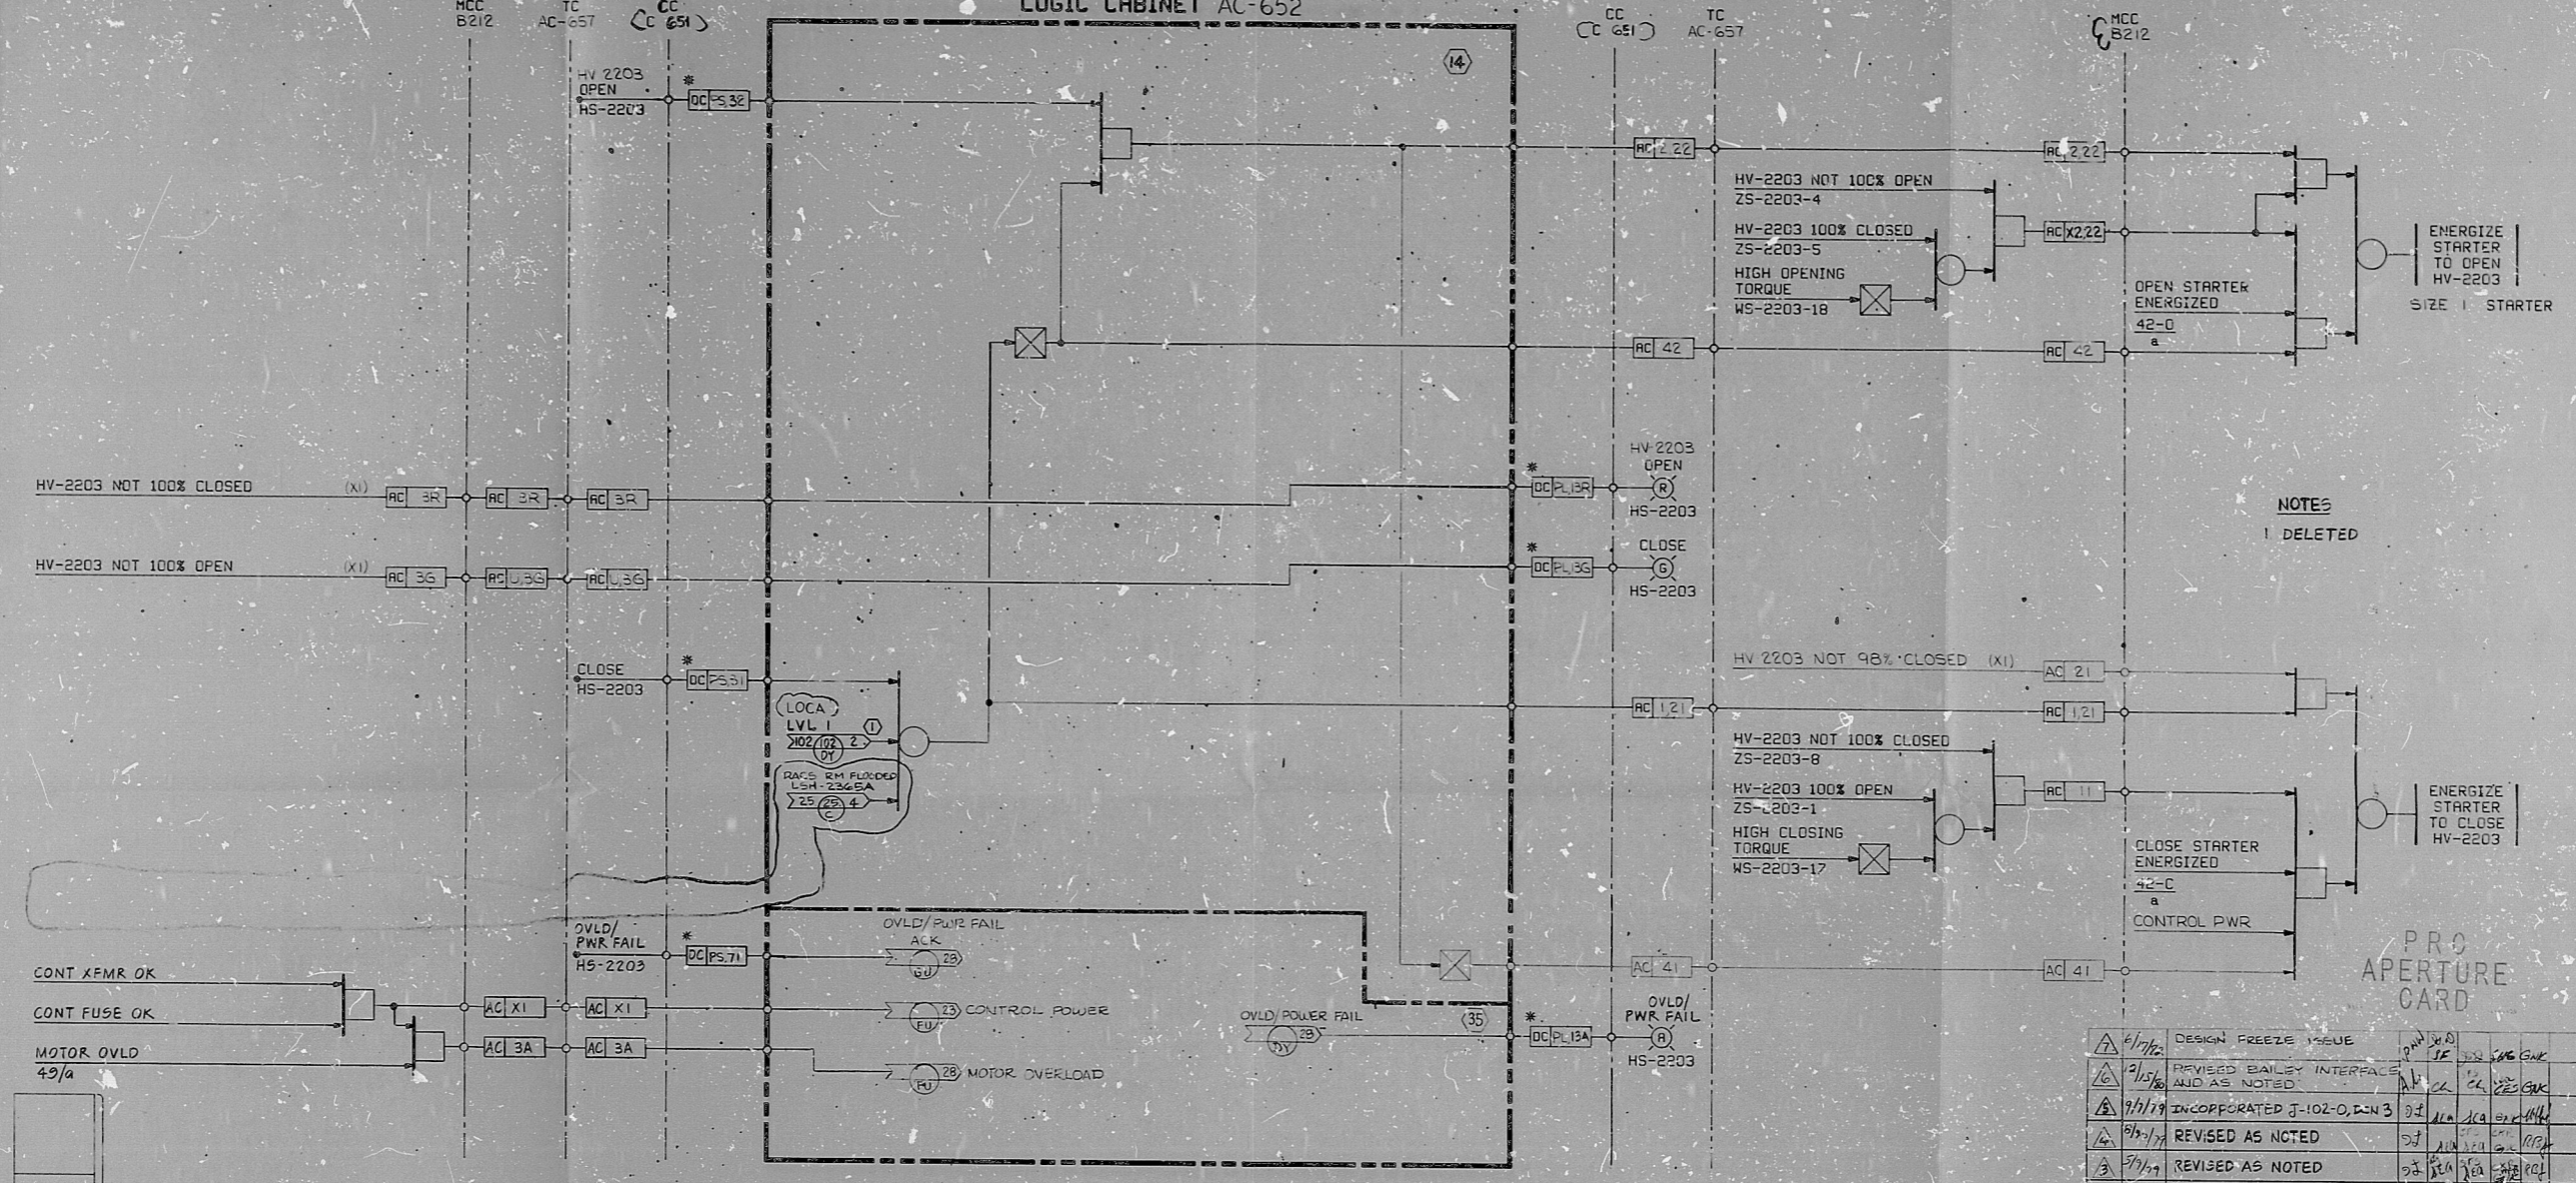

RACS HX COOLING LOOP A SUPPLY HV-2203
CLASS 1E CHANNEL R

NOTES
1 DELETED

PRO APERTURE CARD

4/1/72	DESIGN FREEZE ISSUE	JW	JE	JE	JE	JE	JE
7/15/72	REVISED BAILEY INTERFACES AND AS NOTED	JW	JE	JE	JE	JE	JE
9/17/72	INCORPORATED J-102-0, DCN 3	JW	JE	JE	JE	JE	JE
9/21/72	REVISED AS NOTED	JW	JE	JE	JE	JE	JE
3/1/73	REVISED AS NOTED	JW	JE	JE	JE	JE	JE
3/14/73	REVISED AS NOTED	JW	JE	JE	JE	JE	JE
7/1/73	ISSUED FOR CONSTRUCTION	JW	JE	JE	JE	JE	JE

SCALE: NONE DESIGNED: P.W.W. DRAWN: RCG

BECHTEL
SAN FRANCISCO

PUBLIC SERVICE ELECTRIC AND GAS COMPANY
HOPE CREEK GENERATING STATION

LOGIC DIAGRAM
STATION SERVICE WATER SYSTEM
RACS HX COOLING LOOP A SUPPLY HV-2203

JOB No.	DRAWING No.	REV.
10855	J-10-0 SHT 14	7 Q

S/U - EA

This drawing and the design it covers are the property of BECHTEL. They are hereby loaned and on the borrower's express agreement that they will not be reproduced, copied, loaned, exhibited, nor used except in the limited way and private use permitted by any written consent given by the lender to the borrower.

- H5-2203
- OVLDT/PWR FAIL (A)
- HV 2203 OPEN (R)
- CLOSE (G) CONTROL CONSOLE CG51A

NO. ENTRY

11776 RONG/NC/100-210

22 X 34 "D" SIZE

RIDS

8307250719

