



J-10-0 SHT. 19

This drawing and the design it covers are the property of BECHTEL. They are hereby loaned and on the borrower's express agreement that they will not be reproduced, copied, loaned, exhibited, nor used except in the limited way and private use permitted by any written consent given by this letter to the borrower.

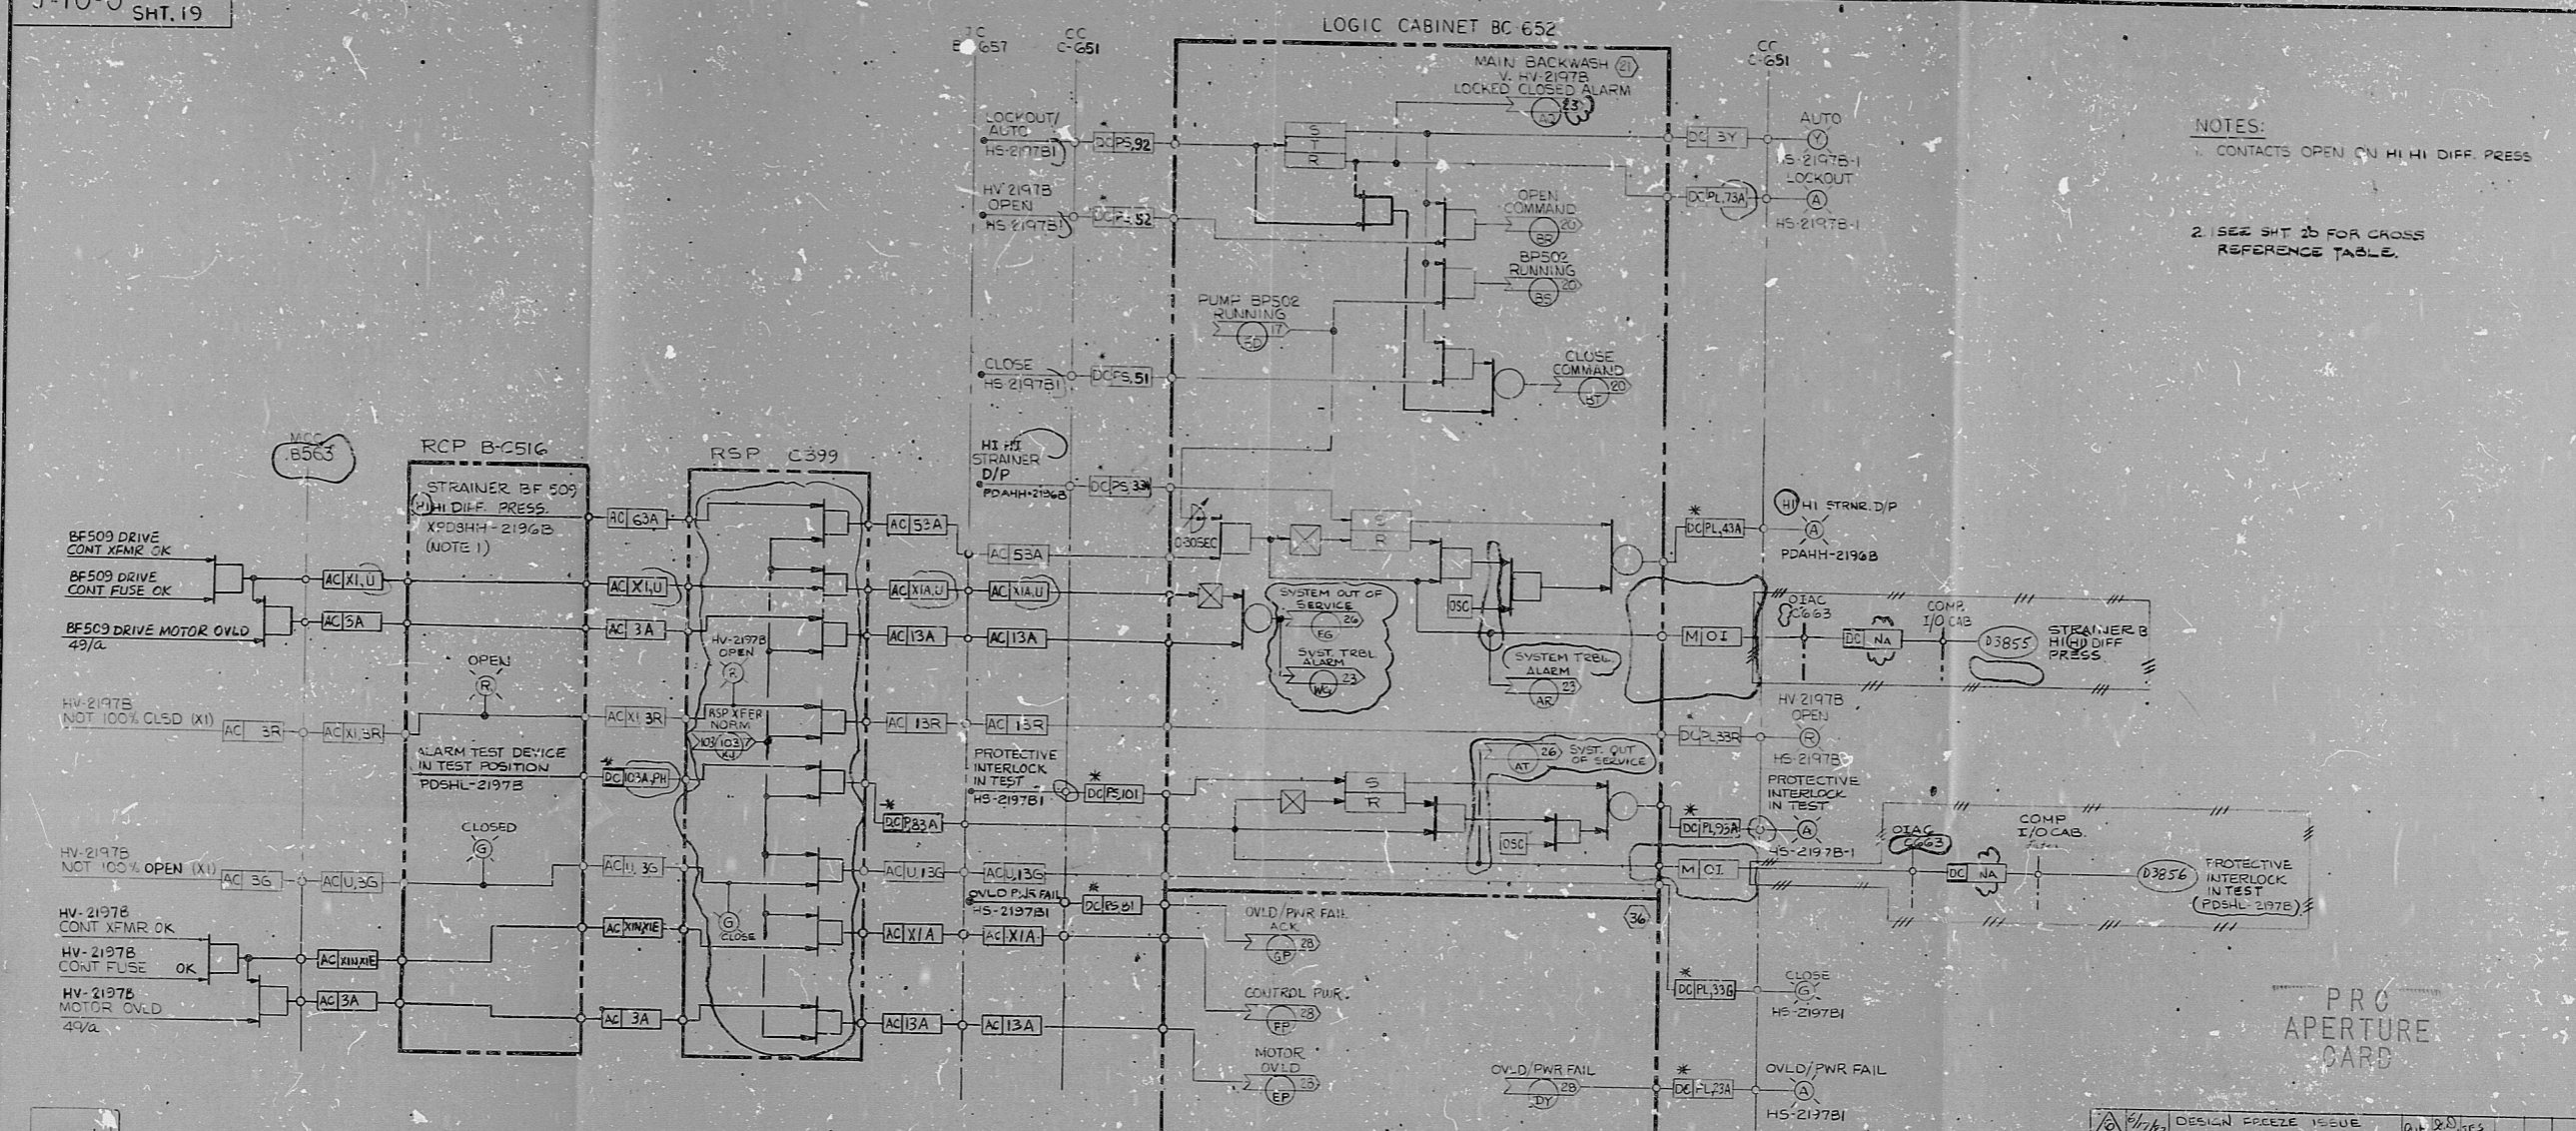

NOTES:
 1. CONTACTS OPEN ON HI HI DIFF PRESS
 2. SEE SHT 20 FOR CROSS REFERENCE TABLE.

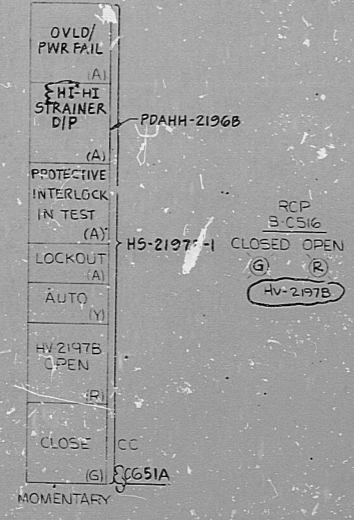

NO.	DATE	REVISIONS	BY	CHECK	DESIGN	SUPP.	ENGR.	PROJ.	APPR.
1	1/14/76	DESIGN FREEZE ISSUE	AW	JD	SPS	SPS	SPS	SPS	SPS
2	1/16/76	REVISED BAILEY INTERFACE AND AS NOTED	AW	CA	CA	CA	CA	CA	CA
3	1/21/76	REVISED AS NOTED	JD	CA	CA	CA	CA	CA	CA
4	1/21/76	REVISED AS NOTED	JD	CA	CA	CA	CA	CA	CA
5	1/21/76	REVISED AS NOTED	JD	CA	CA	CA	CA	CA	CA
6	1/21/76	REVISED AS NOTED	JD	CA	CA	CA	CA	CA	CA
7	1/21/76	ISSUED FOR CONSTRUCTION	JD	CA	CA	CA	CA	CA	CA

SCALE: NONE

DESIGNED: PWW

DRAWN: FAT

BECHTEL
 SAN FRANCISCO

PUBLIC SERVICE ELECTRIC AND GAS COMPANY
 HOPE CREEK GENERATING STATION

LOGIC DIAGRAM
 STATION SERVICE WATER SYSTEM
 STRAINERS BF509 & DF509 MAIN BACKWASH VLV'S

JOB No.	DRAWING No.	REV.
10855	J-10-0 SHT. 19	6 Q

S/U-EA

RIDS

8307250727

