



J-10-0 SHT. 21

RCP AC-515 (NOTE 1)

- NOTES:
- RCP AC515 TO BE SUPPLIED & WIRED BY TRAVELING SCREEN VENDOR.
  - THESE SWITCHES TO BE PROVIDED BY TRAVELING SCREEN VENDOR.
  - REFER TO VENDOR PRINT M-020 VENDOR LOGIC DIAGRAMS
  - RUN SIGNAL CONSISTS OF "SLOW" OR "FAST" MODE.
  - ISOLATION DEVICE PROVIDED BY TRAVELING SCREEN VENDOR, SEE VENDOR PRINTS M020.

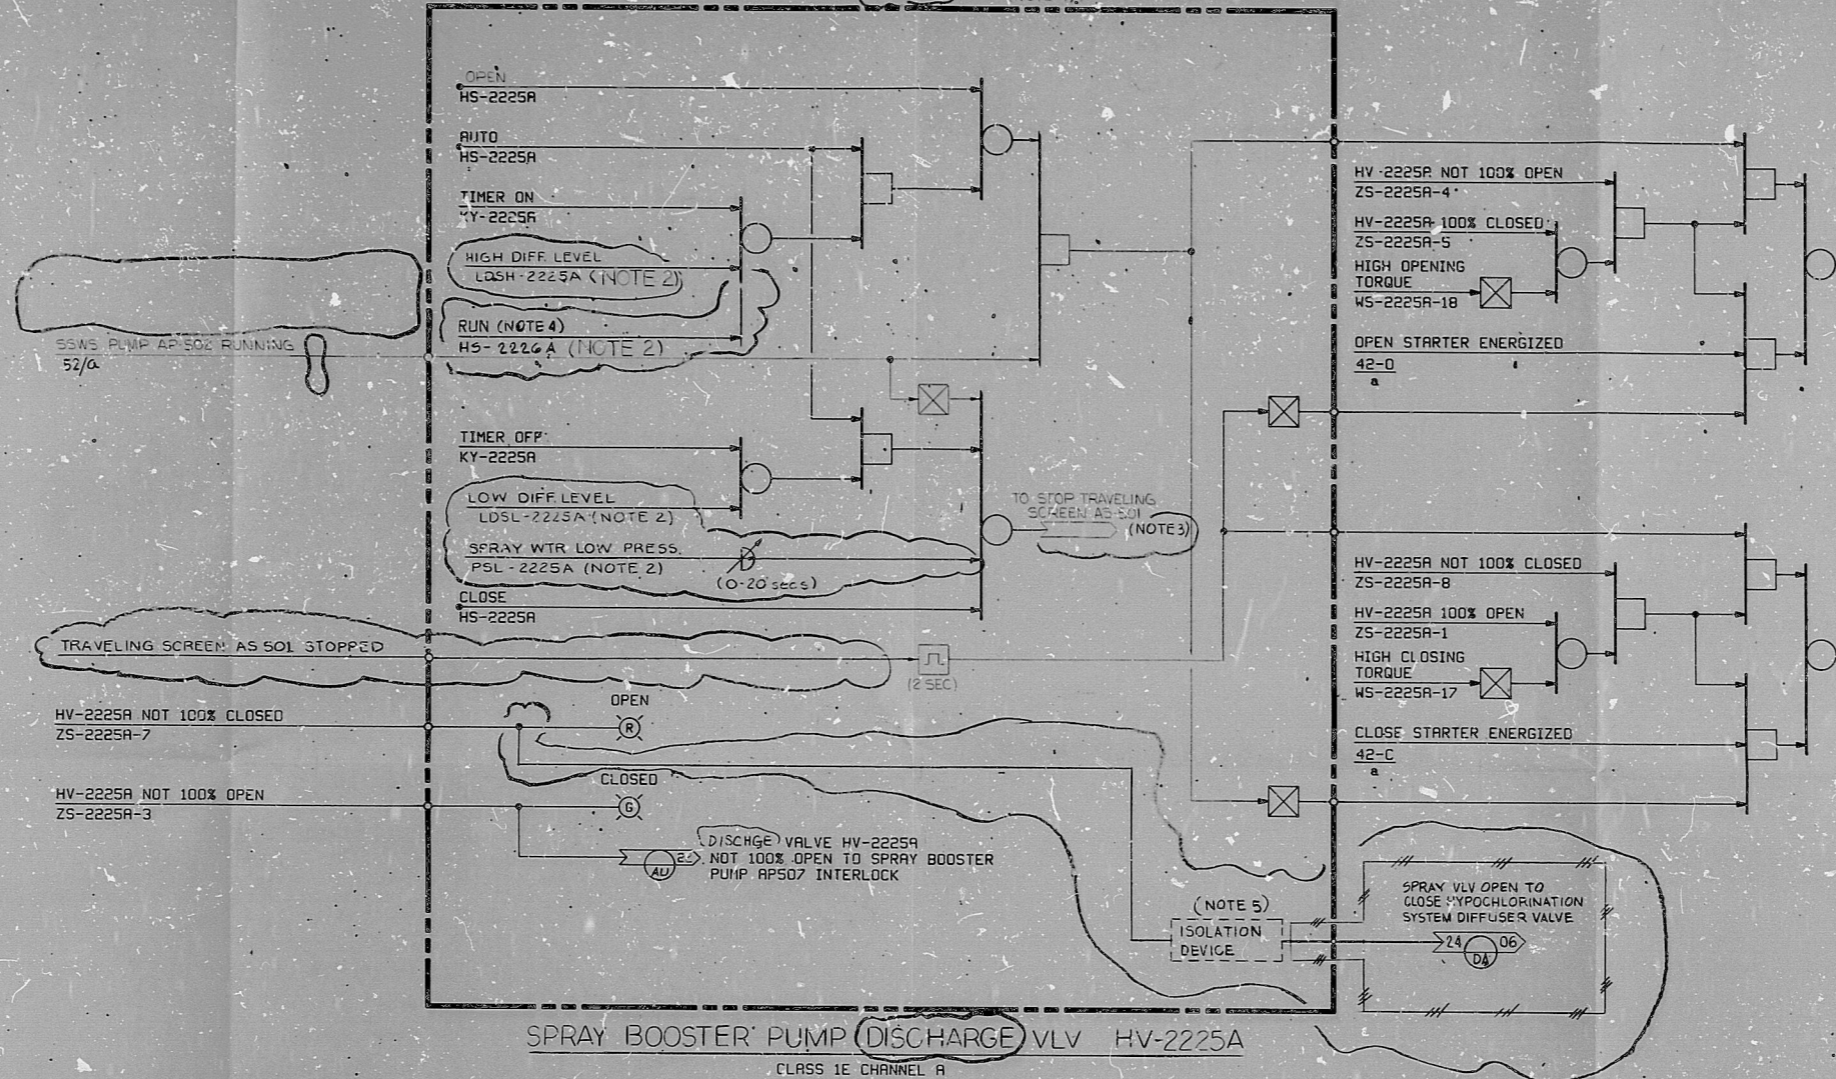

This drawing and the design it covers are the property of BECHTEL. They are hereby loaned and on the borrower's express agreement that they will not be reproduced, copied, loaned, exhibited, nor used except in the limited way and under the conditions permitted by the lender to the borrower.

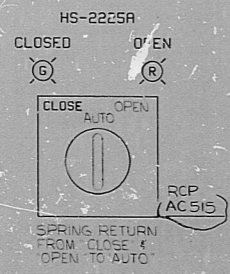

CROSS REFERENCE TABLE

SSWS PUMP	SPRAY PUMP	DISCHARGE VALVE	HAND SW.	POSITION SW. (NOTE 2 SHT 1)	TORQUE SW. (NOTE 2 SHT 1)	TIMER	DIFF. LEVEL SW.		RCP	PRESS SWITCH	CLASS 1E CHANNEL	TRAVELING SCREEN
							CONTROL	ALARM				
AP502	AP507	HV-2225A	HS-2225A	ZS-2225A	WS-2225A	KY-2225A	LDSL-2225A	LDSH-2225A	AC 515	PSL-2225A	A	AS 501
BP502	BP507	HV-2225B	HS-2225B	ZS-2225B	WS-2225B	KY-2225B	LDSL-2225B	LDSH-2225B	BC 515	B	B	BS 501
CP502	CP507	HV-2225C	HS-2225C	ZS-2225C	WS-2225C	KY-2225C	LDSL-2225C	LDSH-2225C	CC 515	C	C	CS 501
DP502	DP507	HV-2225D	HS-2225D	ZS-2225D	WS-2225D	KY-2225D	LDSL-2225D	LDSH-2225D	DC 515	D	D	DS 501

PRO APERTURE CARD

NO.	DATE	REVISIONS	BY	CHK	DESIGN	INSTR	ENGR	APPV
SCALE	NONE	DESIGNED	PWW	DRAWN	SRP			
<b>BECHTEL</b> SAN FRANCISCO								
PUBLIC SERVICE ELECTRIC AND GAS COMPANY HOPE CREEK GENERATING STATION								
LOGIC DIAGRAM STATION SERVICE WATER SYSTEM SPRAY BOOSTER PUMP DISCHG VALVES								
JOB No.	DRAWING No.	REV.						
10855	J-10-0 SHT 21	1 Q						

S/U - EP

RIDS

830725073|

