


CROSS REFERENCE TABLE

CLASS IE CHANNELS	TRAVELING SCREEN	SPRAY SHUTOFF VLV	SPRAY BOOSTER PP	MCC	RCP	TC	LC	CKT No.	COMPUTER I/O CAB	COMPUTER POINT ID						
										HI-HI Δ	MOVING	STOPPED	BOOSTER PUMP			
A	AS 501	HV-2225A	AP 507	Later	AC 515	AC 652	AC 652	31	Later	D 5535	D 2950	D 4108	D 4100	D 4939	D 4943	D 4947
B	BS 501	HV-2225B	BP 507		BC 515	BC 652	BC 652	32		D 5536	D 2982	D 4109	D 4101	D 4940	D 4944	D 4948
C	CS 501	HV-2225C	CP 507		CC 515	CC 652	CC 652	33		D 5537	D 2984	D 4110	D 4102	D 4941	D 4945	D 4949
D	DS 501	HV-2225D	DP 507		DC 515	DC 652	DC 652	34		D 5538	D 2986	D 4111	D 4103	D 4942	D 4946	D 4950

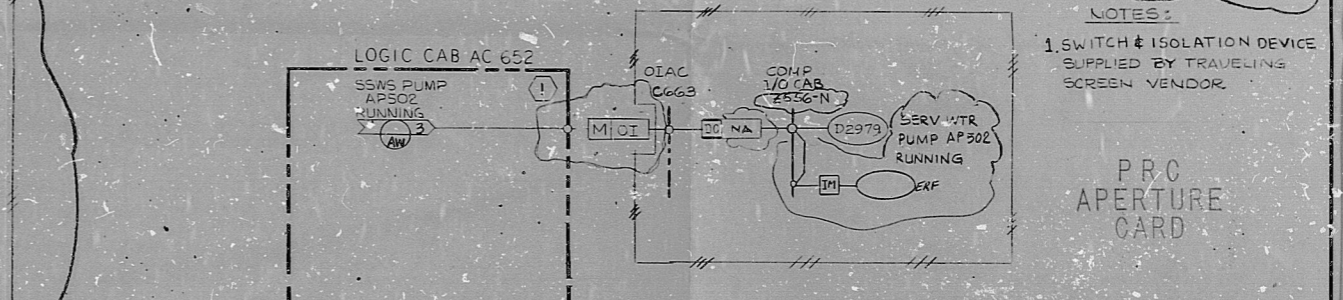

CROSS REF. TABLE

SSWS PUMP	LOGIC CABINET	COMPUTER POINT ID	CIRCUIT NO.	CLASS IE CHANNEL	COMP I/O CAB	SSWS PUMP RUNNING
AP502	AC 652	D 2979	1	A	Z 656-N	SHT. 3 ARROW AW
BP502	BC 652	D 2981	2	B	Z 657-N	SHT. 5 ARROW AX
CP502	CC 652	D 2983	3	C	Z 658-N	SHT. 3 ARROW AW
DP502	DC 652	D 2985	4	D	Z 659-N	SHT. 5 ARROW AX

REVISIONS

NO.	DATE	REVISIONS	BY	CHKD	DESIGN	ENGR	PROJ	APPR
1	1/10/78	DESIGN FREEZE ISSUE	PWW	JF	SSS	EMG		
2	1/16/78	REMOVED BAILEY INTERFACE AND AS NOTED	JF	SSS	EMG			
3	2/1/78	REVISED AS NOTED	JF	SSS	EMG			
4	2/1/78	REVISED AS NOTED	JF	SSS	EMG			
5	2/1/78	REMOVED 'HOLD' REVISED AS NOTED	JF	SSS	EMG			
6	2/1/78	REVISED AS NOTED	JF	SSS	EMG			
7	2/1/78	ISSUED FOR CONSTRUCTION	JF	SSS	EMG			

SCALE NONE

DESIGNED PWW, DRAWN EMG

**BECHTEL**  
SAN FRANCISCO

PUBLIC SERVICE ELECTRIC AND GAS COMPANY  
HOPE CREEK GENERATING STATION

LOGIC DIAGRAM  
STATION SERVICE WATER SYSTEM  
ALARMS & COMPUTER INPUTS

JOB No.	DRAWING No.	REV.
10855	J-10-0 SHT. 24	6

S/U-EA,RJ,AK

This drawing and the design it covers are the property of BECHTEL. They are loaned and on the borrower's express agreement that they will not be reproduced, copied, loaned, exhibited, or used except in the limited way and private use permitted by the lender to the borrower.

22"  
17"  
11"  
0.5"  
11"  
17"  
22"

22"  
17"  
11"  
0.5"  
11"  
17"  
22"

RIDS

8307250736

