


22

22

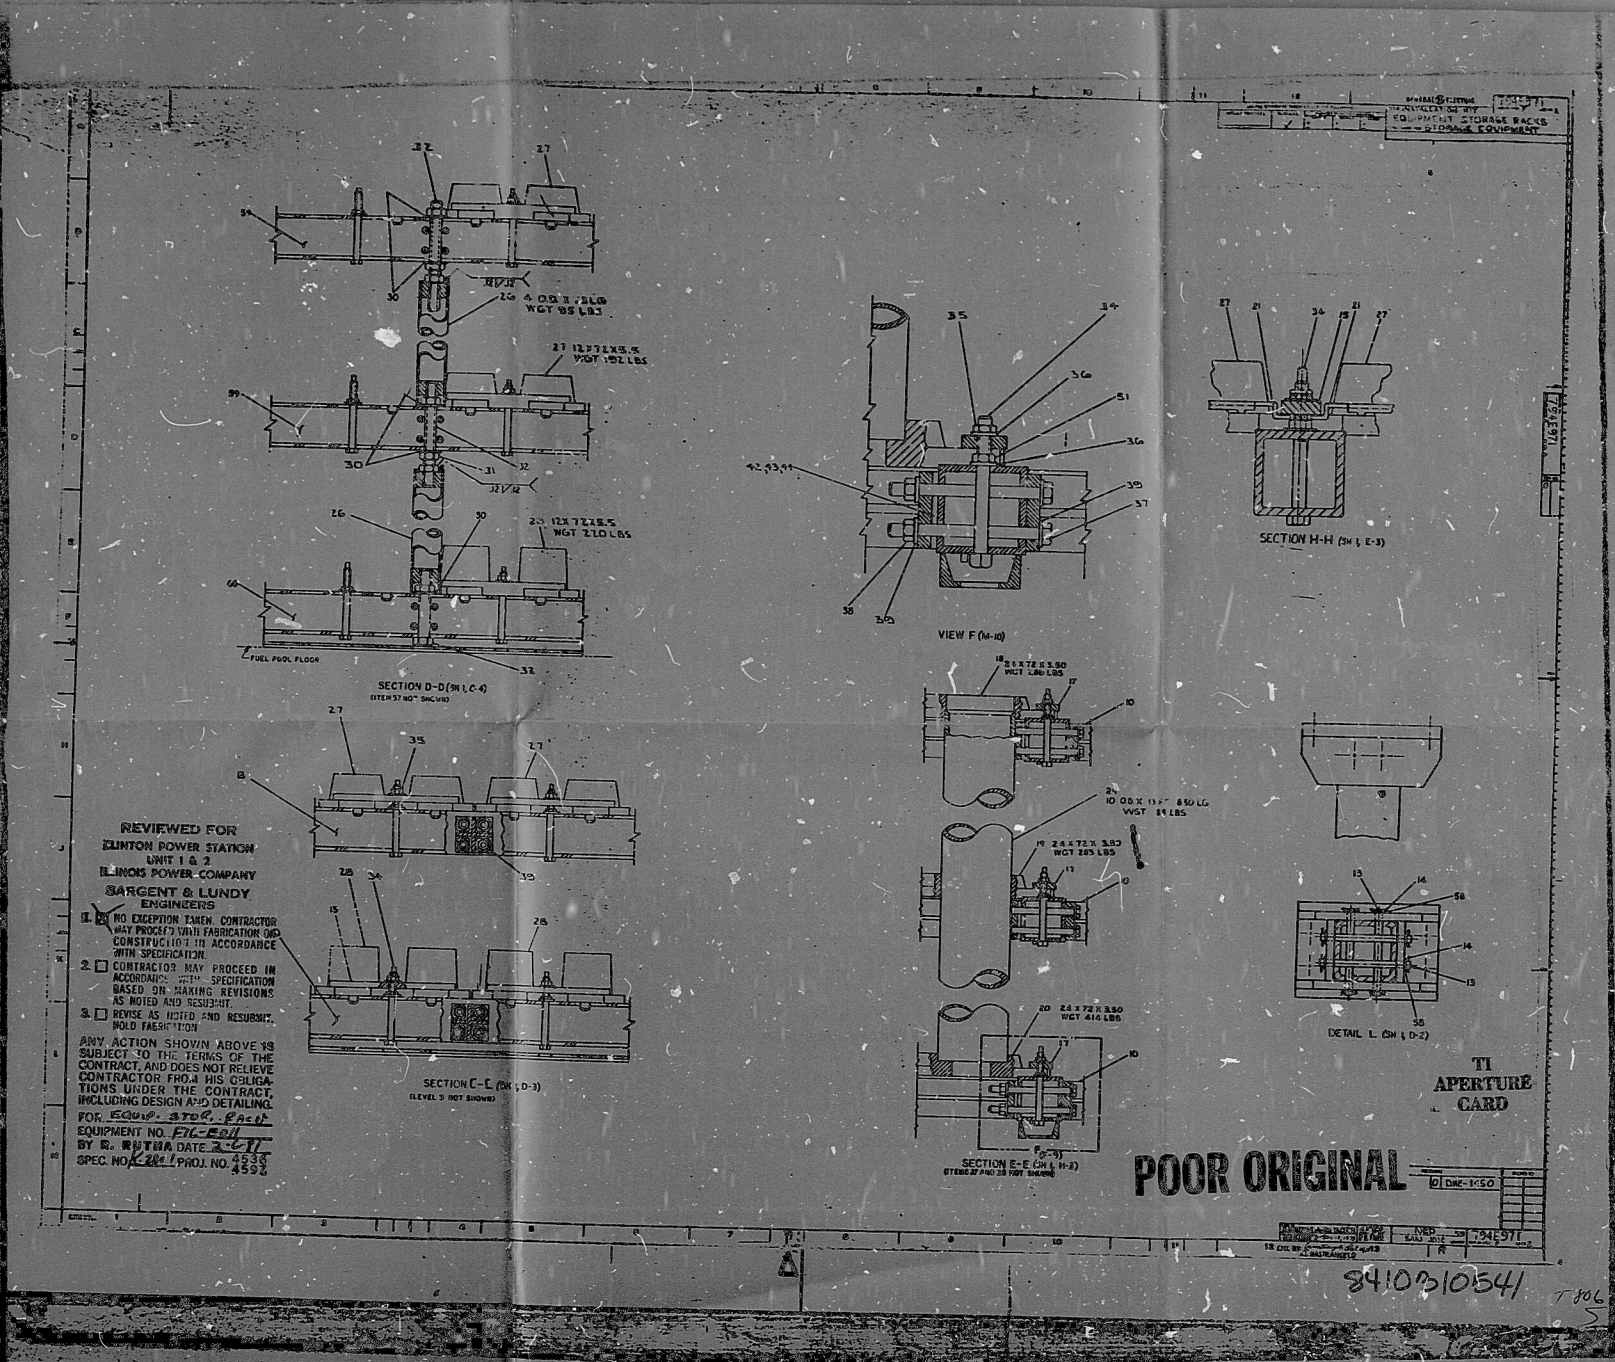

REVIEWED FOR
CLINTON POWER STATION
UNIT 1 & 2
BLACKS POWER COMPANY
SARGENT & LUNDY
ENGINEERS

- 1. NO EXCEPTION TAKEN CONTRACTOR HAS PROCEEDED WITH FABRICATION AND CONSTRUCTION IN ACCORDANCE WITH SPECIFICATION.
 - 2. CONTRACTOR MAY PROCEED IN ACCORDANCE WITH SPECIFICATION BASED ON MAKING REVISIONS AS NOTED AND RECORDED.
 - 3. REVERSE AS NOTED AND RESUBMIT HOLD FABRICATION.
- ANY ACTION SHOWN ABOVE IS SUBJECT TO THE TERMS OF THE CONTRACT AND DOES NOT RELIEVE CONTRACTOR FROM HIS OBLIGATIONS UNDER THE CONTRACT, INCLUDING DESIGN AND DETAILING FOR EQUIPMENT.
- EQUIPMENT NO. ETC-001
BY E. W. T. H. A. DATE 2-11-77
SPEC. NO. 2241 PROJ. NO. 4553

PDR

8410310541

