
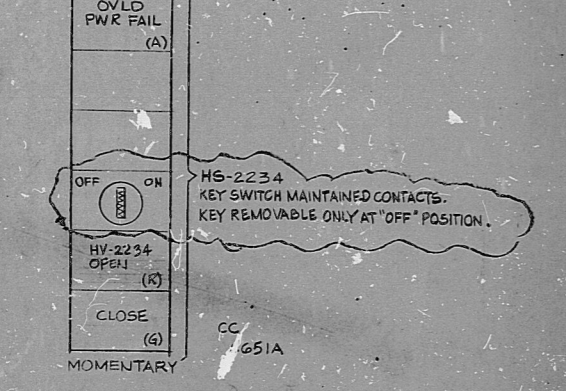


J-10-0 SHT. 25

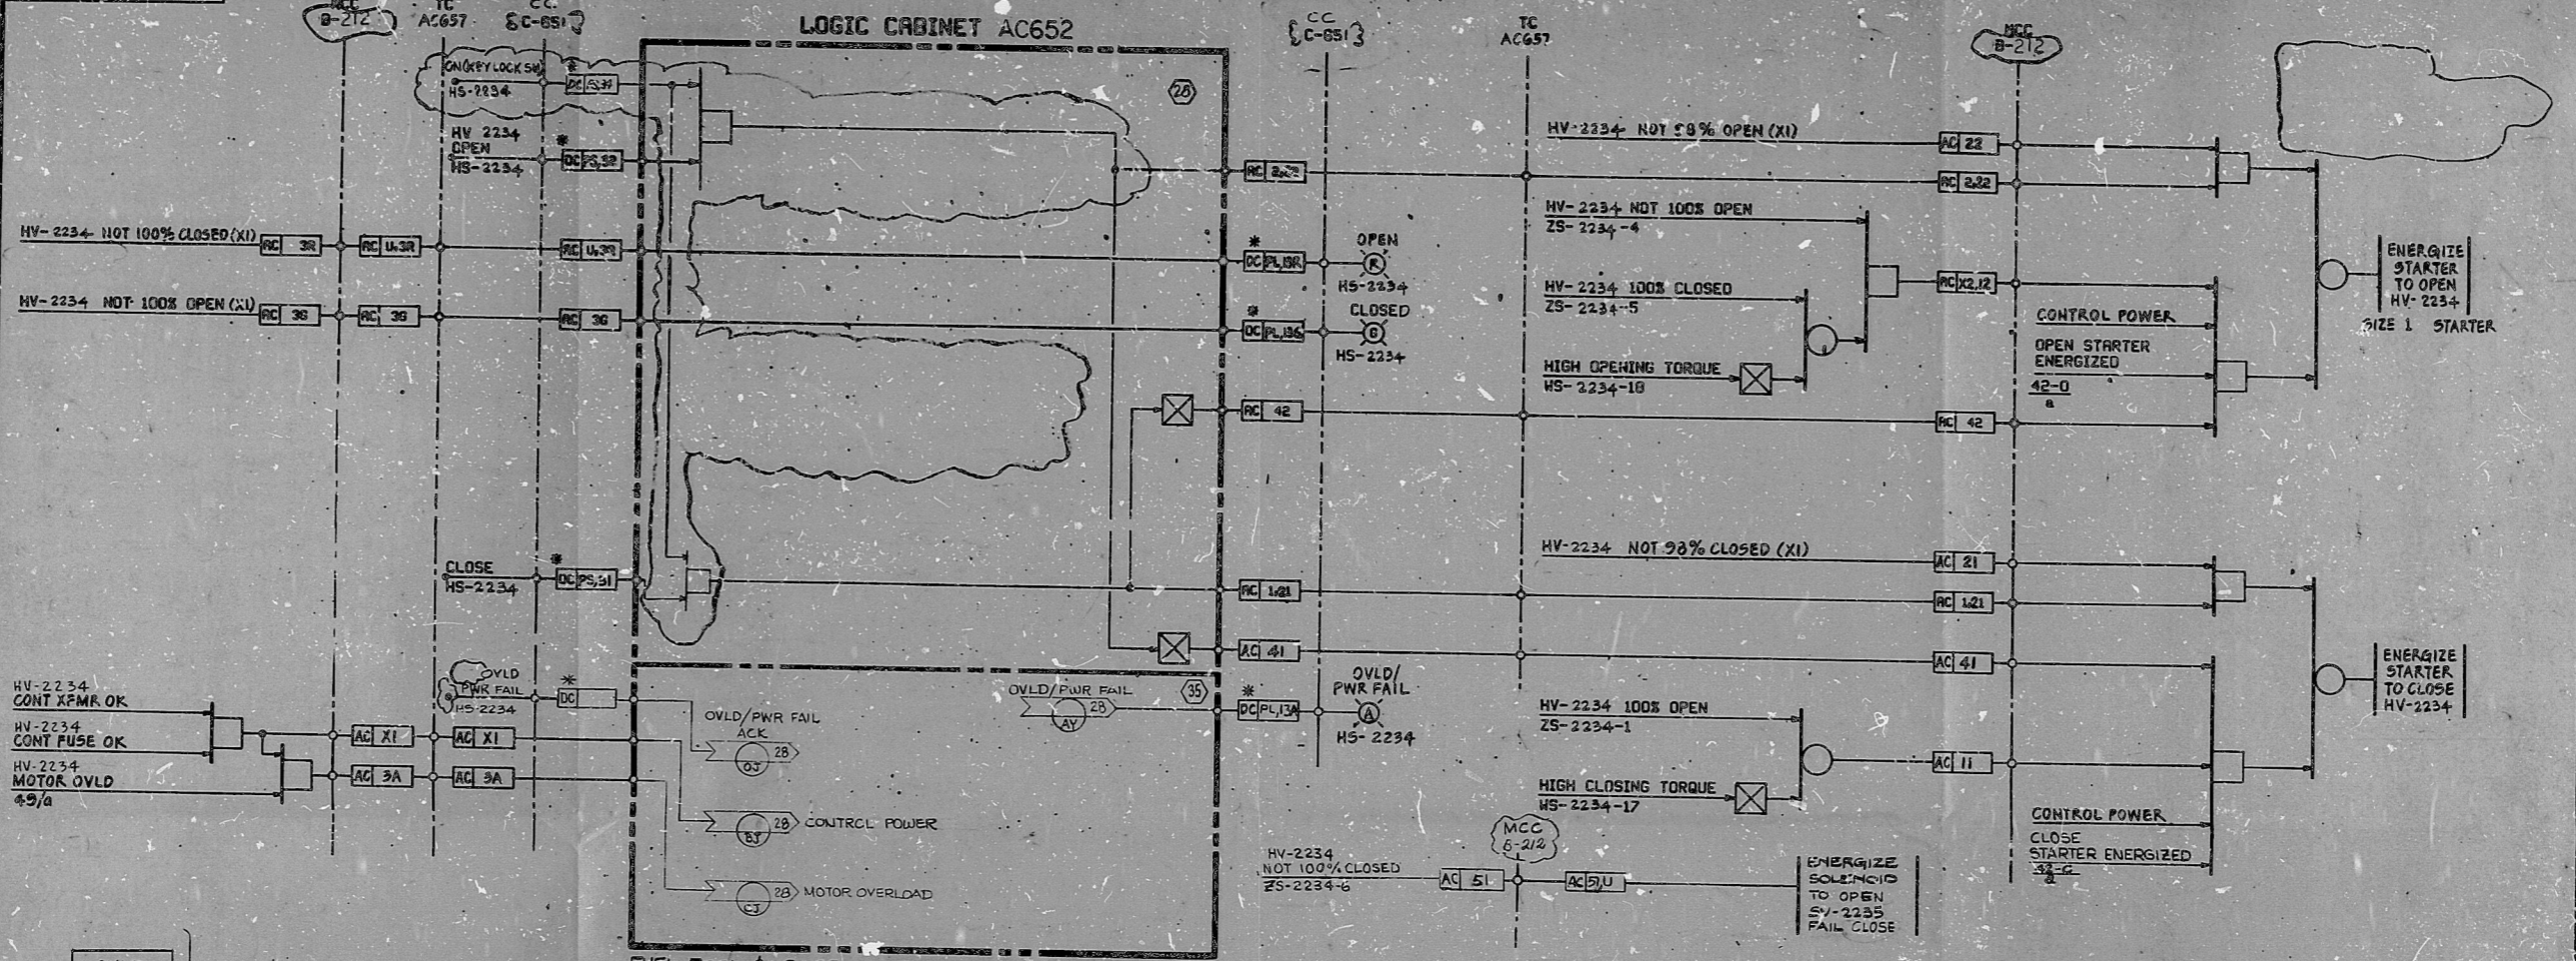

FUEL POOL & SACS LOOP A CLASS 1E MAKEUP ISLN VALVE HV-2234 & LEAKAGE DRAIN VALVE SV-2235 CLASS 1E-CHANNEL A

CROSS REFERENCE TABLE

MAKEUP VALVE NO.	SERVICE	DRAIN VALVE	HAND SWITCH	LOGIC CAB	TC	PWR DIST PNL	CIRCUIT NO	CLASS 1E CHANNEL	MCC	CIRCUIT NO. FOR ALL OPEN ARROWS	OVLD / PWR FAIL LIGHT ARROW
HV-2234	FUEL POOL & SACS LOOP A CLG WTR CLASS 1E MAKEUP & DRAIN	SV-2235	HS-2234	AC652	AC657	LATER	28	A	B-212	(35)	AY SHT. 28
HV-2236		SV-2237	HS-2236				29	A			DY SHT. 28
HV-2238		SV-2239	HS-2238	BC652	BC657		30	B			AY SHT. 28
HV-F073		SV-F074	HS-F073				43	B	B-212	(36)	DY SHT. 28

NO.	DATE	REVISIONS	BY	CHKD	APPD
1	5/1/78	DESIGN PRINTE ISSUE			
2	10/15/78	REVISED BAILEY INTERFACE AND AS NOTED	PA	OK	DESIGNER
3	11/1/78	REVISED AS NOTED	DT	11/1/78	11/1/78
4	11/1/78	ISSUED FOR CONSTRUCTION THIS SHEET ADDED	DT	11/1/78	11/1/78

**DECHTEL**  
SAN FRANCISCO

PUBLIC SERVICE ELECTRIC AND GAS COMPANY  
HOPE CREEK GENERATING STATION

**LOGIC DIAGRAM**  
STATION SERVICE WATER SYSTEM

FUEL POOL & SACS CLASS 1E MAKEUP ISLN & DRAIN VS

JOB NO.	DRAWING NO.	SHT.	REV.
10355	J-10-0	SHT. 25	3

This drawing and the design it covers are the property of DECHTEL. They are hereby loaned and of the borrower's express agreement that they will not be reproduced, copied, loaned, exhibited, nor used except in the manner and for the period of time specified in the contract or any written consent given by the lender to the borrower.

S/U - LATER

RIDS

8307250737

