


22"

22"

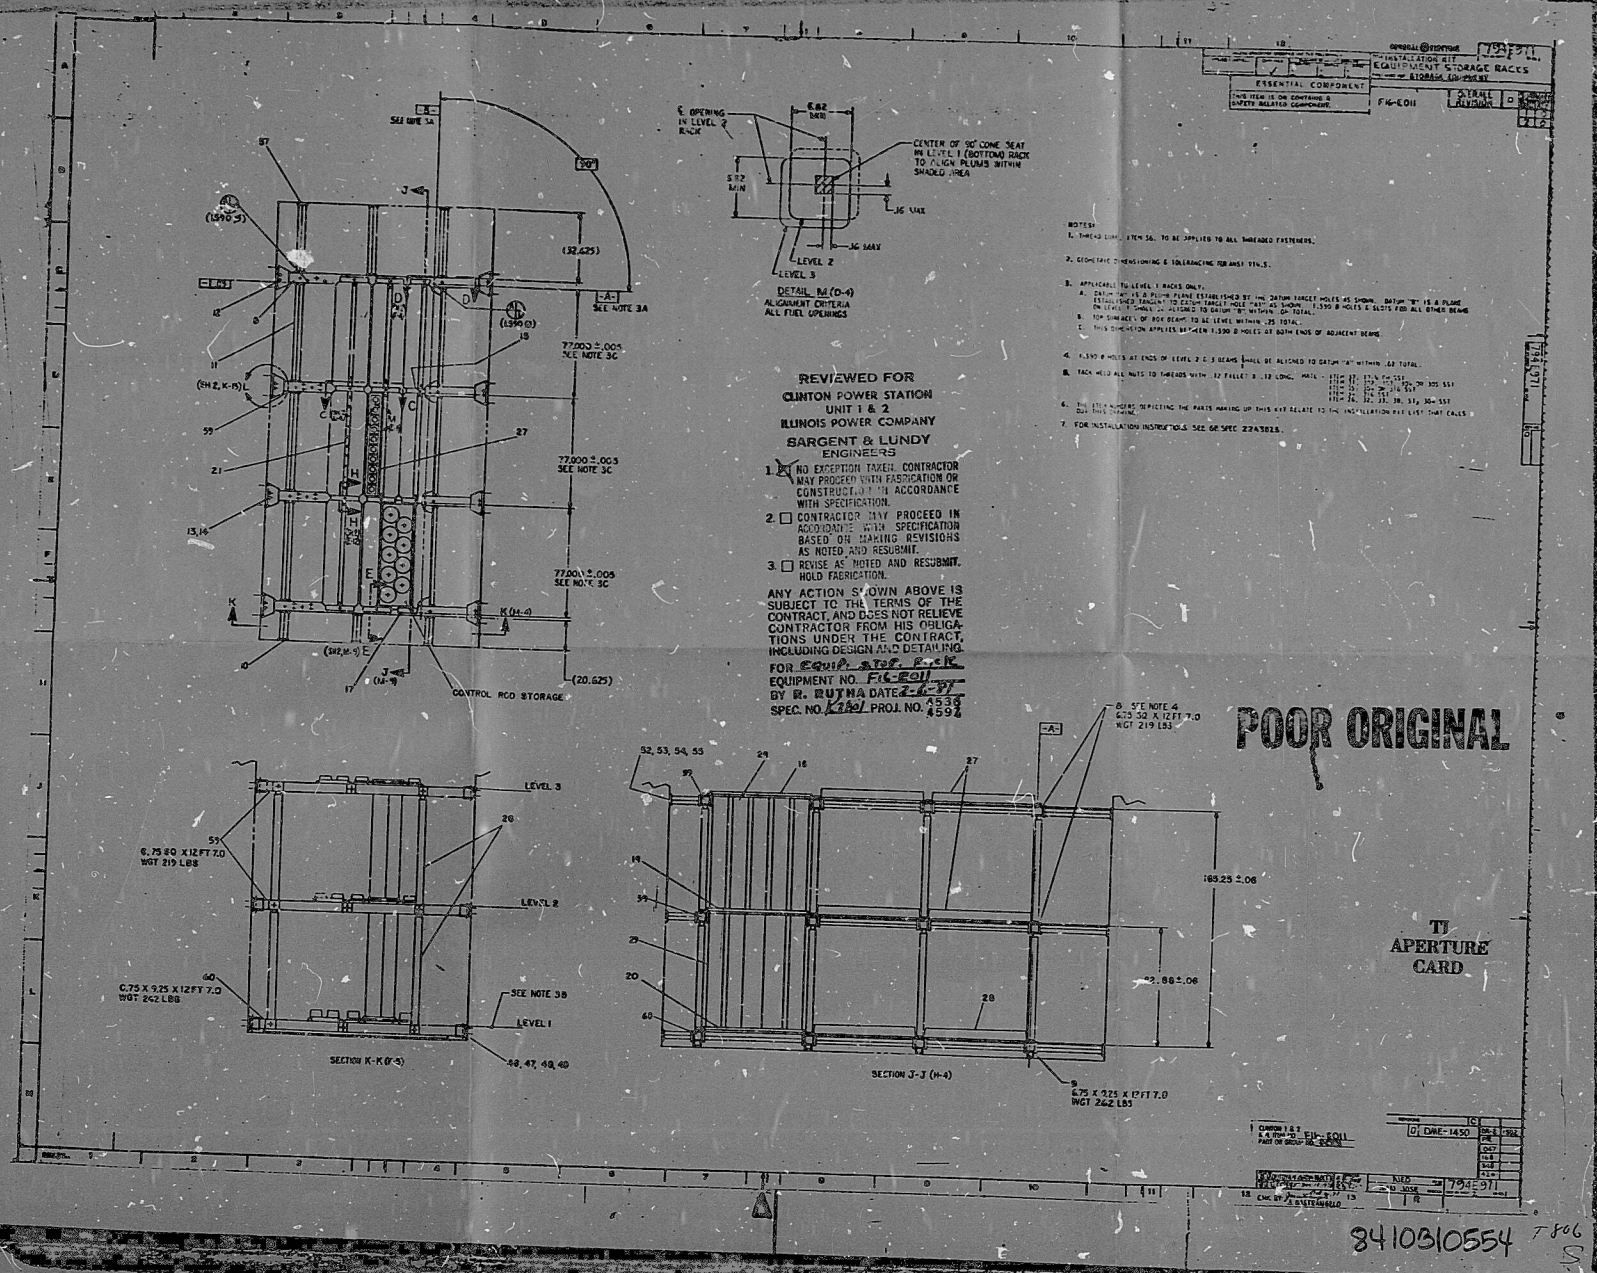

22"

22"

PDR

8410810554

