


J-10-0 SH. 30

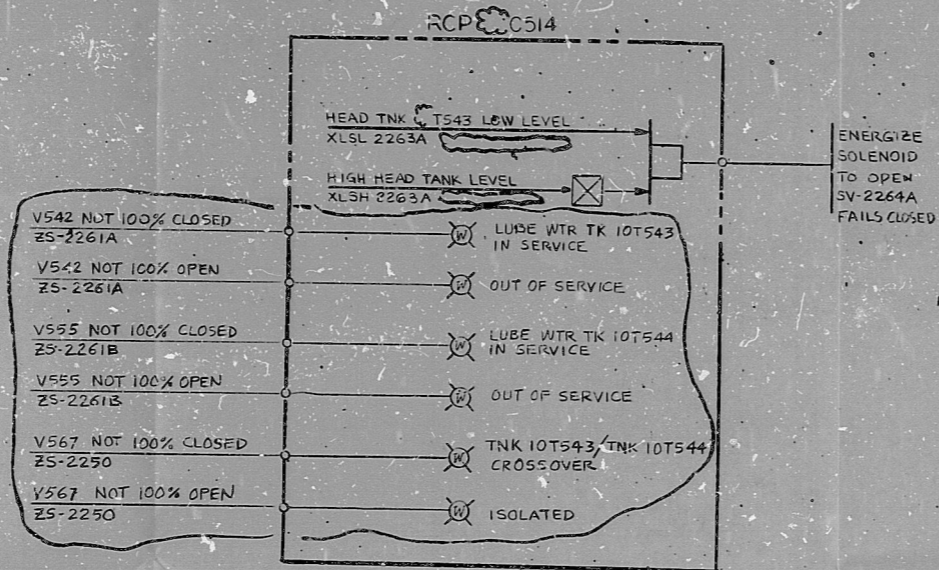

NOTE:
1. DELETED
2. DELETED


SSWS LUBE WTR HEAD TK LVL CONT & STAT LIGHTS

CROSS-REFERENCE TABLE

LUBE WTR HEAD TNK	LEVEL SWITCH	REPEATER RELAY CONTACT	REPEATER RELAY CONTACT	PANEL NUMBER	SOLENOID VLY
TS43	LSHL 2263A	XLSL 2263A	XLSH 2263A	C514	SV2264A
TS44	LSHL 2263B	XLSL 2263B	XLSH 2263B		SV2264B

P/R
APERTURE
CARD

This drawing and its data are the property of BECHTEL. They are hereby loaned and used as the licensee's property. No part of this drawing may be reproduced, copied, or transmitted in any form or by any means, electronic or mechanical, including photocopying, recording, or by any information storage and retrieval system, without the prior written permission of BECHTEL.

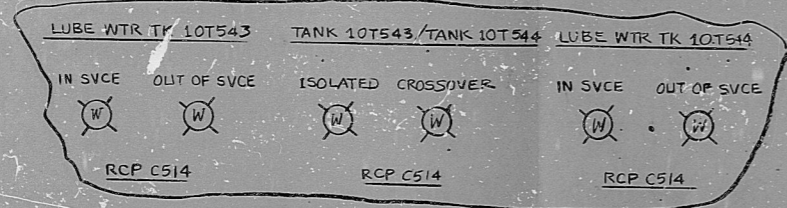

△									
△									
△									
△	1/4	REVISED PANEL NO ADDED							
△	1/4	STATUS LIGHTS, AND AS NOTED							
△	1/12	DESIGN FREEZE ISSUE							
△	1/12	ISSUED FOR CONSTRUCTION							
DATE	BY	REVISIONS	BY	CHKD	DESIGN	ENGR	PRGR	APPR	
SCALE	NONE	DESIGNED	PWW	DRAWN	FAT				
BECHTEL SAN FRANCISCO									
PUBLIC SERVICE ELECTRIC AND GAS COMPANY HOPE CREEK GENERATING STATION									
LOGIC DIAGRAM STATION SERVICE WATER SYSTEM									
SSWS LUBE WTR HEAD TK LVL CONTROL & STATUS LIGHTS									
JOB No.		DRAWING No.		REV.					
10355		J-10-0 SH. 30		I					

S/U-EA

0710

RIDS

8307250746

