




PDA

7A12270511

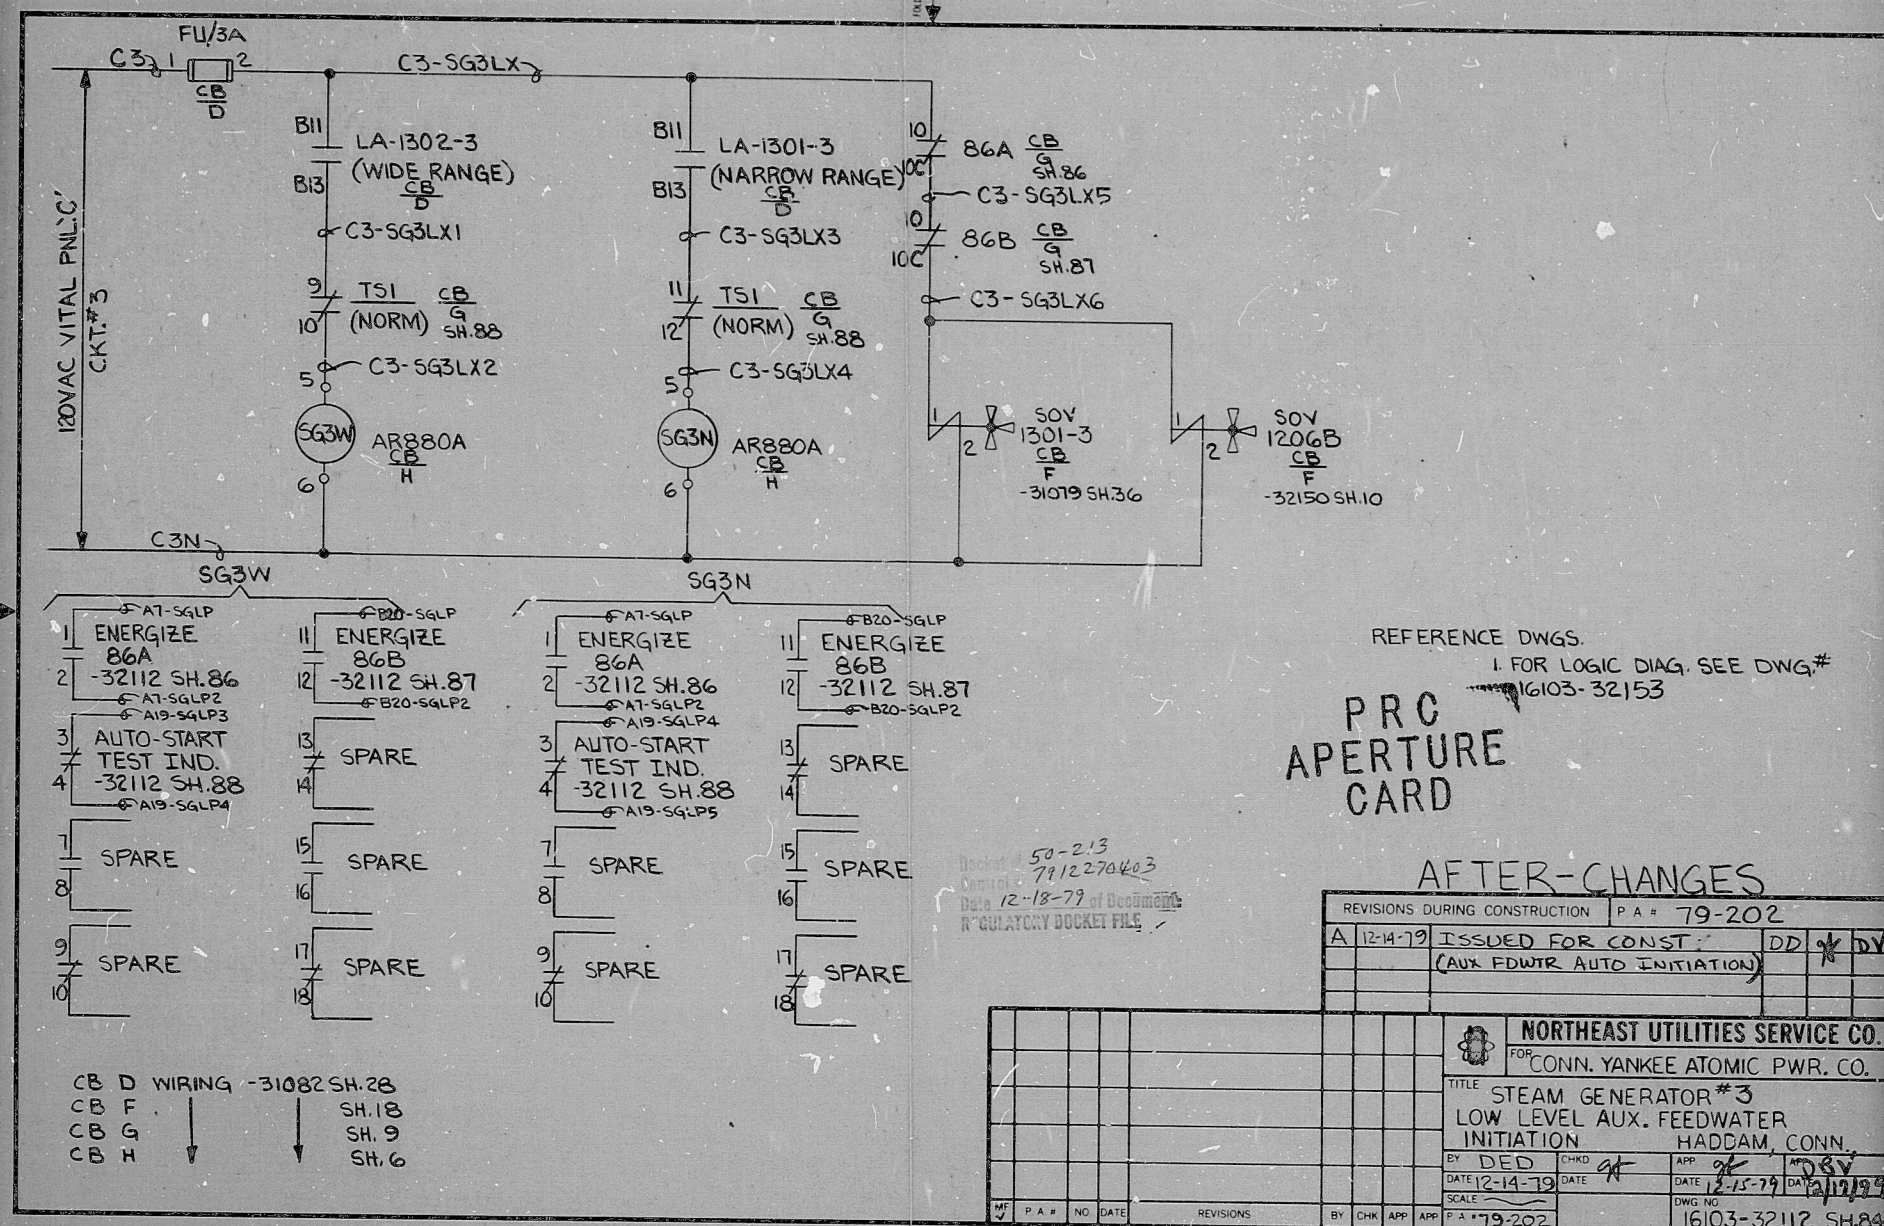