


REV.	17
ISO. NO.	MCFI INC 5
BUILDING:	REACTOR ZONE RB
DUKE PIPING CLASS:	ASME SECTION III CLASS B
SYSTEM SYMBOL:	REACTOR COOLANT - NC
PIPING SPEC.:	NC II PS. 2501.1 NC 12.7
DRAWING NO.:	NC.1414.03-20-00.04
PROJECT:	MC GUIRE
NUCLEAR SAFETY RELATED	
NO.	REVISION
4	ADDED NCIF-53
3	YN12655: DELETED PRE-ASSY SECTIONS INCP227, 228, 229, & CHANGE THEM TO MATERIAL "C" AT TRANSFER POINT. REVISED "D" TO "B" AT INCP218
2	DIRECTION OF SLOPE CHANGED
1	REL. for Construction VAN# 11427 - SLOPE LINE
0	

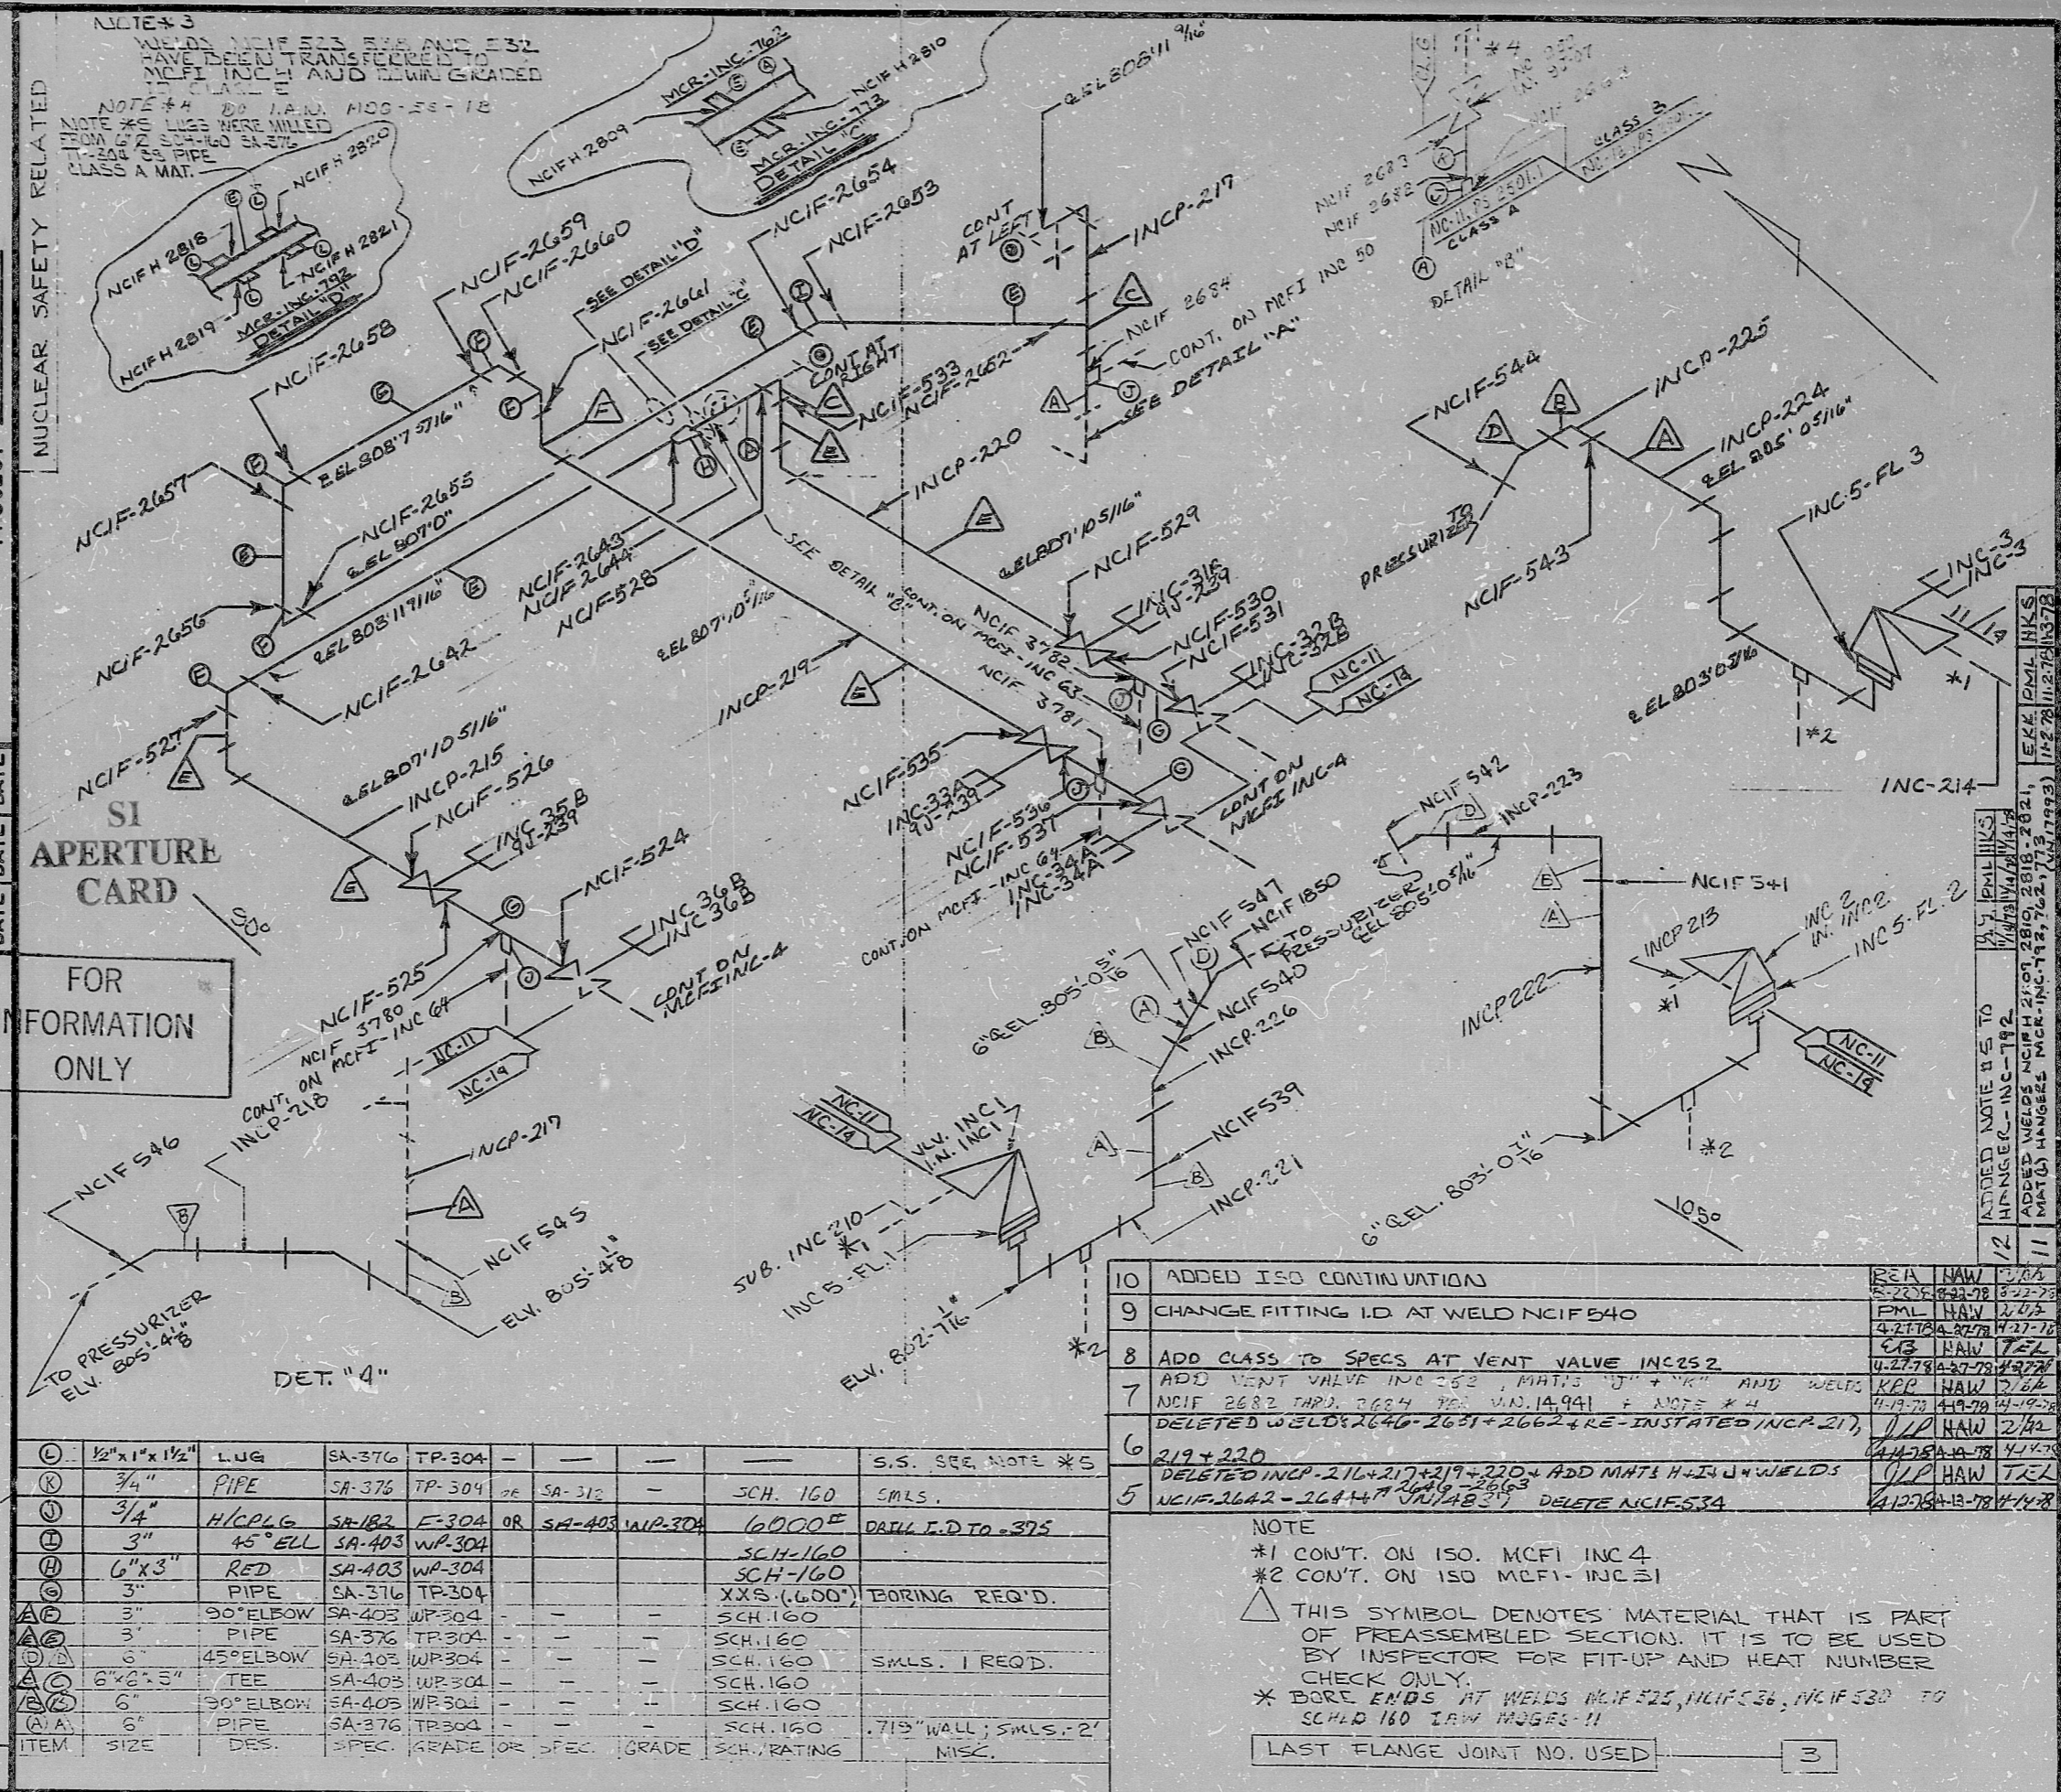

FOR INFORMATION ONLY

ITEM	SIZE	DES.	SPEC.	GRADE	OR SPEC.	GRADE	SCH.	RATING
(C)	1/2"x1 1/2"	LUG	SA-376	TP-304	-	-	-	S.S. SEE NOTE *5
(K)	3/4"	PIPE	SA-376	TP-304	SA-312	-	SCH. 160	SMLS.
(P)	3/4"	HIC PLG	SA-182	E-304	OR SA-403	WR-304	6000E	DRILL I.D. TO .375
(H)	3"	45° ELL	SA-403	WR-304	-	-	SCH-160	
(R)	6"x3"	RED	SA-403	WR-304	-	-	SCH-160	
(G)	3"	PIPE	SA-376	TP-304	-	-	XXS (.600")	DRILLING REQ'D.
(A)	3"	90° ELBOW	SA-403	WR-304	-	-	SCH. 160	
(D)	3"	PIPE	SA-376	TP-304	-	-	SCH. 160	
(B)	6"	45° ELBOW	SA-403	WR-304	-	-	SCH. 160	SMLS. 1 REQ'D.
(C)	6"x2 1/2"	TEE	SA-403	WR-304	-	-	SCH. 160	
(A)	6"	90° ELBOW	SA-403	WR-304	-	-	SCH. 160	
(A)	6"	PIPE	SA-376	TP-304	-	-	SCH. 160	.715" WALL; SMLS.-2' MISC.

- 10 ADDED ISO CONTINUATION
  - 9 CHANGE FITTING I.D. AT WELD NCIF540
  - 8 ADD CLASS TO SPECS AT VENT VALVE INCP222
  - 7 ADD VENT VALVE INC 532, MAT'S "J" & "K" AND WELDS NCIF 2682 TARD, 2684 TARD, VAN. 14941 & NOTE \*4
  - 6 DELETED WELDS 2646-2631+2662+RE-INSTATED INCP 217, 219+220
  - 5 DELETED INCP-216+217+219+220+ ADD MATS H+I+J+WELDS NCIF-2642-2644+2649-2663
- NOTE  
 \*1 CONT. ON ISO. MCFI INC 4  
 \*2 CONT. ON ISO MCFI-INC 31  
 ▲ THIS SYMBOL DENOTES MATERIAL THAT IS PART OF PREASSEMBLED SECTION. IT IS TO BE USED BY INSPECTOR FOR FIT-UP AND HEAT NUMBER CHECK ONLY.  
 \* BORE ENDS AT WELDS NCIF 525, NCIF 536, NCIF 530 TO SCH. 160 2" W. HUGGS-11
- LAST FLANGE JOINT NO. USED 3

REVISIONS: 17 (11-18-78), 16 (11-18-78), 15 (11-18-78), 14 (11-18-78), 13 (11-18-78), 12 (11-18-78), 11 (11-18-78), 10 (11-18-78), 9 (11-18-78), 8 (11-18-78), 7 (11-18-78), 6 (11-18-78), 5 (11-18-78), 4 (11-18-78), 3 (11-18-78), 2 (11-18-78), 1 (11-18-78), 0 (11-18-78)

ADDITIONAL NOTES: 14 (11-18-78) REV TO ADD FLAGS AT VLV. INC 1, 2, 3, 9, 28, 29, 30, 99, 100

8903220516

PDR RIDS

