

INSERVICE INSPECTION


REV. 9	BUILDING: REACTOR ZONE R-2
ISO NO: MCFI-INC-33	DUKE PIPING CLASS: ASME SECT. III CL. A
	SYSTEM SYMBOL: REACTOR COOLANT
	PIPING SPEC: NC-03 PS250.1
	DRAWING NO: MC-1414-03.20-00.02
	PROJECT: MCGUIRE
NO.	REVISION
4	REVISED TO ADD WELDS NCIF 2590 THRU NCIF 2593 AND SUBS INCP 403 THRU INCP 405. ADD MAT. J, DELETED NCIF 1508, SUB INCL 15 AND 15A, INCP-223
3	CHANGED CL. CHANGES AT VLV, INC. 115, DELETED MATS F6, ADDED MATS H, I, J. CONT. TO ISO, CHANGED INC 116 ITEM NUMBER (MINS 3413 AND 11,091)
2	ADD NCIF 15 AND NCIF 1508
1	REL. FOR CONST. PER V.N. (7336, 7337, 7338)
7	ADDED WELDS NCIF-2619, 2620, DELETED NCIF-2618, INCP-403 PER V.N. 14592
6	REVISED TO DELETE WELD NCIF 2590 PER V.N. 14592

NOTE TWO:
 ▲ THIS SYMBOL DENOTES MATERIALS THAT ARE PARTS OF PREASSEMBLED SECTIONS. THEY ARE TO BE USED BY INSPECTOR FOR FIT-UP AND HEAT NUMBER CHECK.

FOR INFORMATION ONLY
 SI APERTURE CARD

NOTE ONE:
 ○ POSSIBLE FIELD FIT SUBASSEMBLY INVOLVED.

DATE	DATE	DATE	DATE	DATE	DATE
4/11/78	4/11/78	4/11/78	4/11/78	4/11/78	4/11/78
4/11/78	4/11/78	4/11/78	4/11/78	4/11/78	4/11/78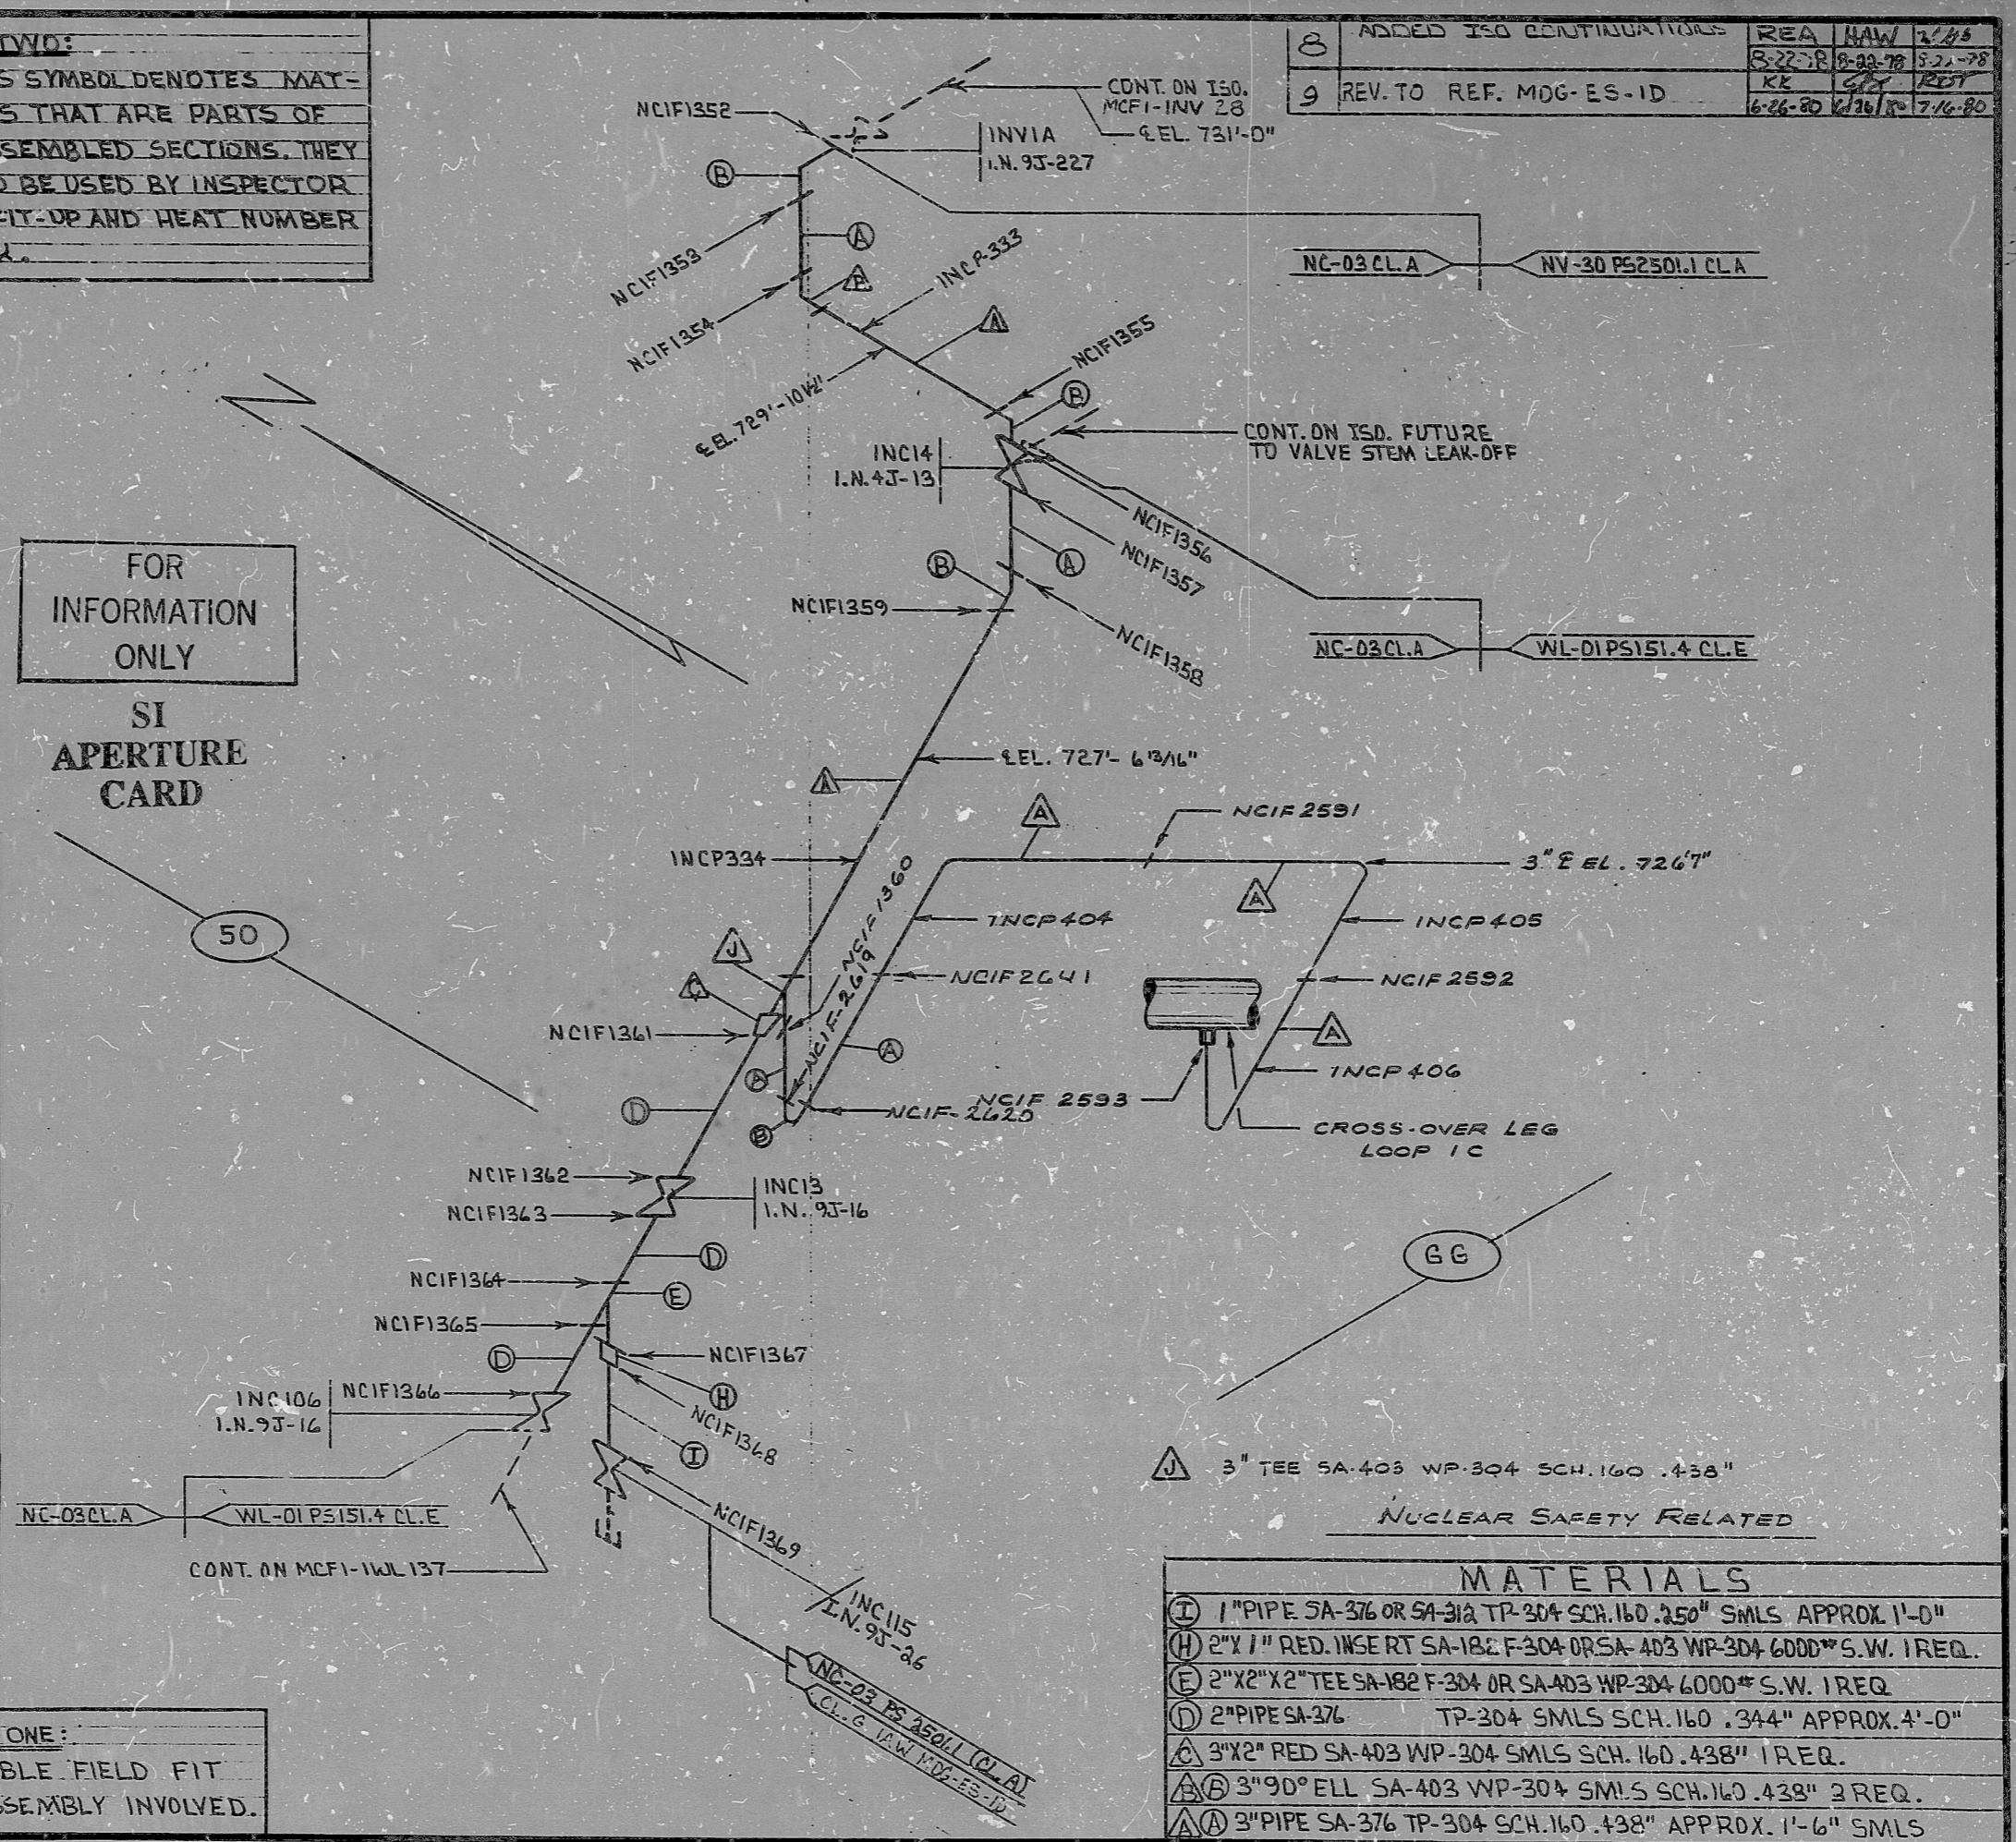
8	ADDED ISO CONTINUATIONS	REA	HAW	2/85
9	REV. TO REF. MDG-ES-ID	8-22-78	8-22-78	8-22-78
		KK	GT	REY
		6-26-80	4/30/80	7-16-80

62

PDR RIDS

8903230133

