


3	REV. TO DELETE NOTE : ADDED CONT.	MR	SA	DT	ISQ NO: MCFI-INC52	REV. 3
2	ADD TEXT TO THE ^{INSERT SHD} AS PART OF SUB INC-92	MR	SA	DT	DUKE PIPING CLASS: ASME SECT. III CL. A	BUILDING: REACTOR R-22
1	REVISE TO CHANGE INT SPEC. FROM MS-30, PS-2501.1 TO MS-36, PS-2501.1	MR	SA	DT	SYSTEM SYMBOL: NC-REACTOR COOLANT	
0	RELEASED FOR CONSTRUCTION	MR	SA	DT	PIPING SPEC: NC-01 PS-2501.1	
NO.	REVISION	ORIG.	CHKD.	APPR.	DRAWING NO.: MC-1414-03.20-00,03	
		DATE	DATE	DATE	PROJECT MCENURE	

NUCLEAR SAFETY RELATED

FOR INFORMATION ONLY

SI APERTURE CARD

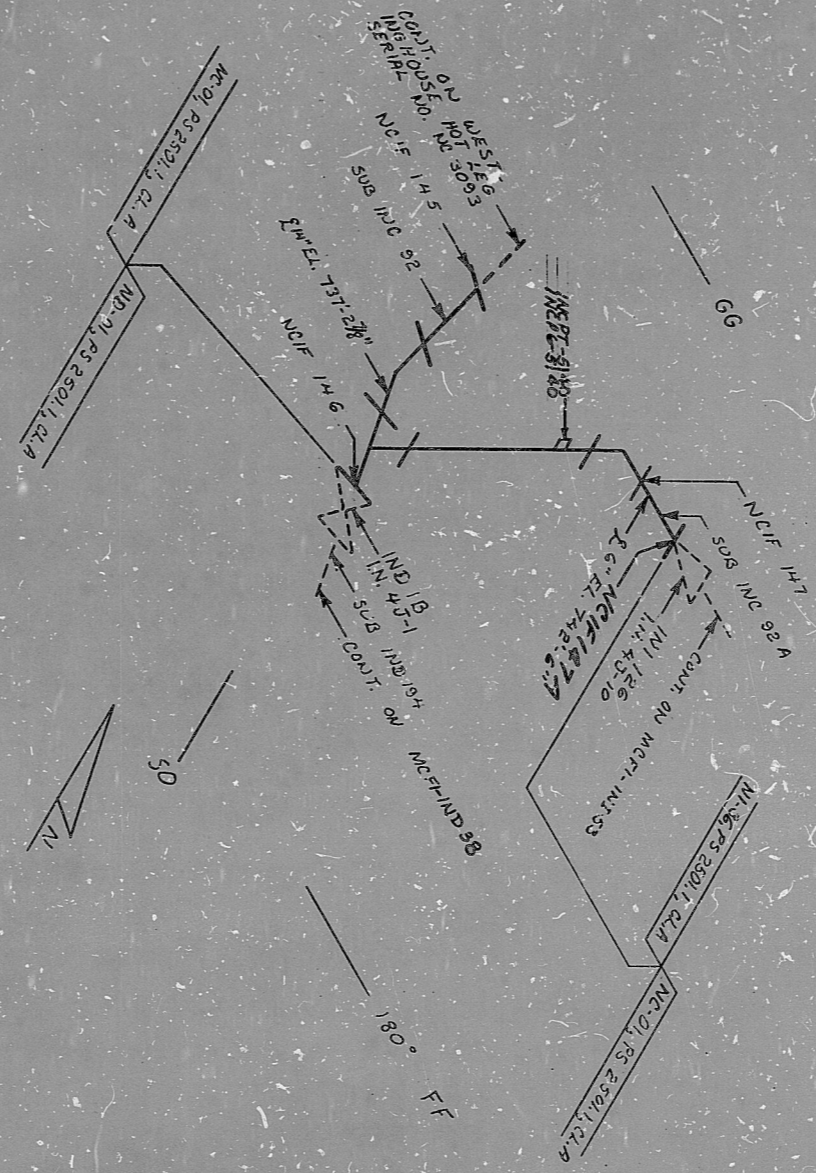

9

PDR RIDS

8903230259

