


INSERVICE INSPECTION

REV. 5	ISO. NO: MCFI-1N153	BR	AK	SP	BR
BUILDING: REACTOR R-4 1R2	DUKE PIPING CLASS: A+B ASME SECT. III	DATE	DATE	DATE	DATE
	SYSTEM SYMBOL: NI - SAFETY INJECTION	11/20/80	11/20/80	11/20/80	11/20/80
	PIPING SPEC: NI-30+36 PS 2501.1	11/20/80	11/20/80	11/20/80	11/20/80
	DRAWING NO: MC-1414-09-22-00	11/20/80	11/20/80	11/20/80	11/20/80
	PROJECT: MCGUIRE	11/20/80	11/20/80	11/20/80	11/20/80

NUCLEAR SAFETY RELATED

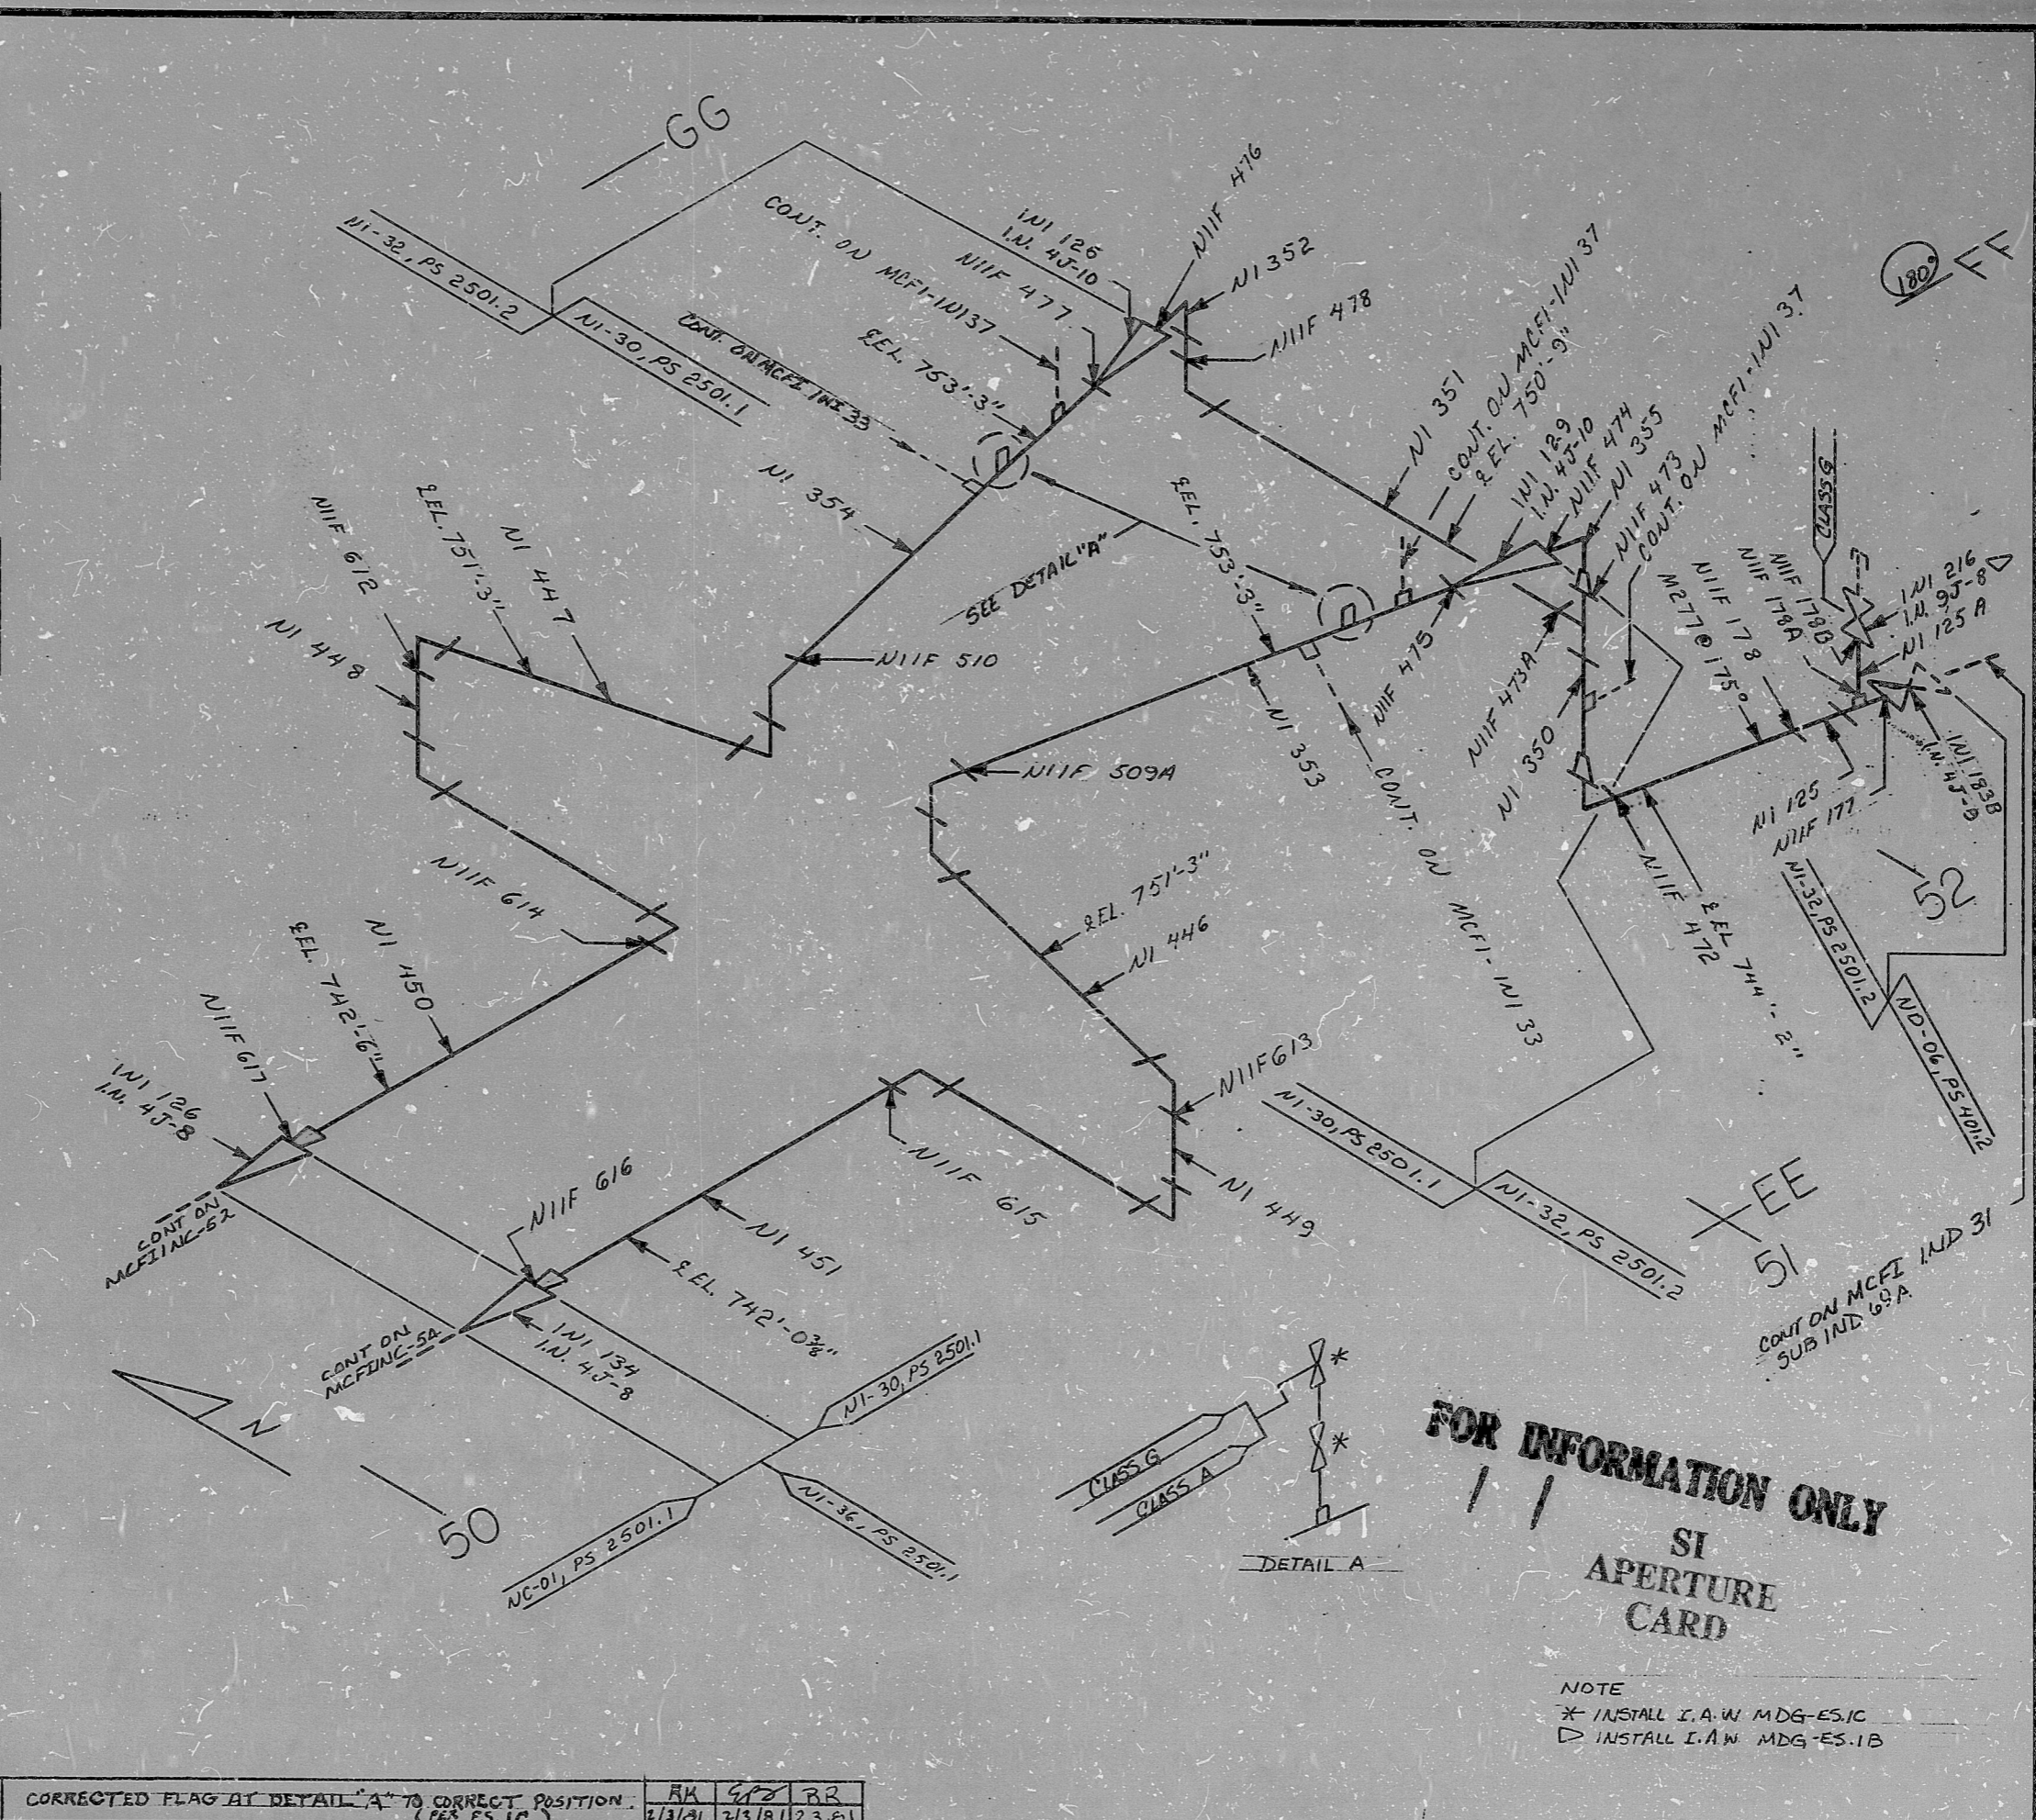

FOR INFORMATION ONLY  
SI  
APERTURE  
CARD

NOTE  
\* INSTALL I.A.W MDG-ES.1C  
□ INSTALL I.A.W MDG-ES.1B

NO. 5	CORRECTED FLAG AT DETAIL "A" TO CORRECT POSITION. (PER ES.1C)	AK	SP	BR
		2/3/81	2/3/81	2/3/81





8903280118

PDR RIDS

