

17"



11"

8.5"

8.5"

11"

17"

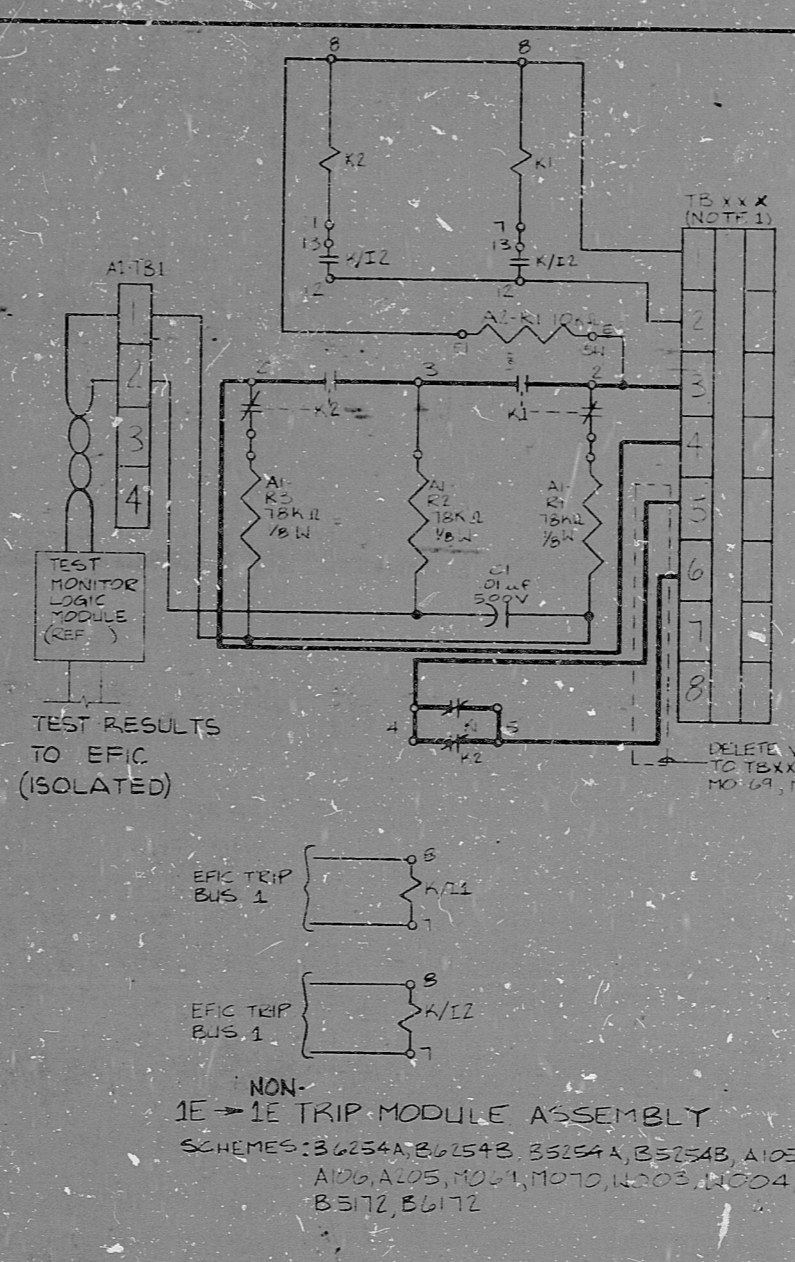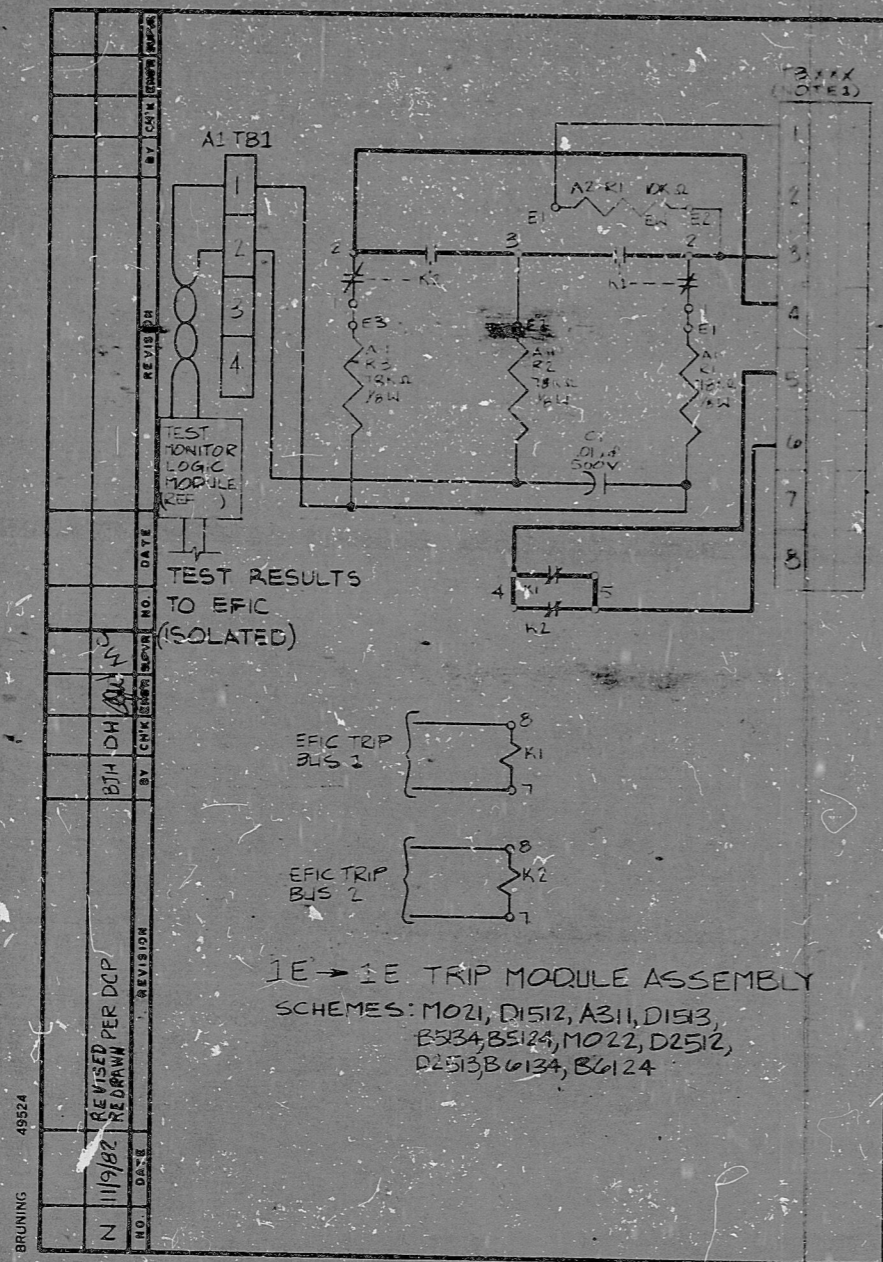

FOR INFORMATION ONLY
THIS DOCUMENT IS NOT CONTROLLED. PLEASE USE, VERIFY INFORMATION WITH A CONTROLLED DOCUMENT

NOTES:
1. MODULE ASSY TB'S ASSIGNED AS FOLLOWS:
TB-XX-X
EFIC TRIP BUS TRIP ASSY SEQ TA TB ... IA, IE, NO, 1A1, 1A2 ...
2. CROSS REF TO VENDOR ASSY POSITION NO'S AVAILABLE ON EE96.
3. EXTERNAL TRIP SIGNAL PATHS SHOWN IN BOLD LINE FOR CLARITY.

REF: 1 VP SERIES 17006
ENGINEER FOR INFORMATION REVIEWER ONLY

ARKANSAS POWER AND LIGHT COMPANY
ARKANSAS NUCLEAR ONE UNIT 1

SCHEMATIC DIAGRAM
EFIC TRIP INTERFACE EQUIPMENT
TRIP RELAY ASSEMBLY
INTERNAL WIRING

DRAWING NO. F-86
REV. N.
8309260577

PROC APERTURE CARD

17"

11"

8.5"

8.5"

11"

17"

RIDS

8307260577

