


22"
17"
11"
8.5"
7"
E
D
C
B
A

This drawing shall be drawn in accordance with the requirements of the specification. It is the responsibility of the drafter to ensure that the drawing is complete and correct. The drafter shall be responsible for the accuracy of the drawing and shall ensure that it is in accordance with the specification. The drafter shall be responsible for the accuracy of the drawing and shall ensure that it is in accordance with the specification.

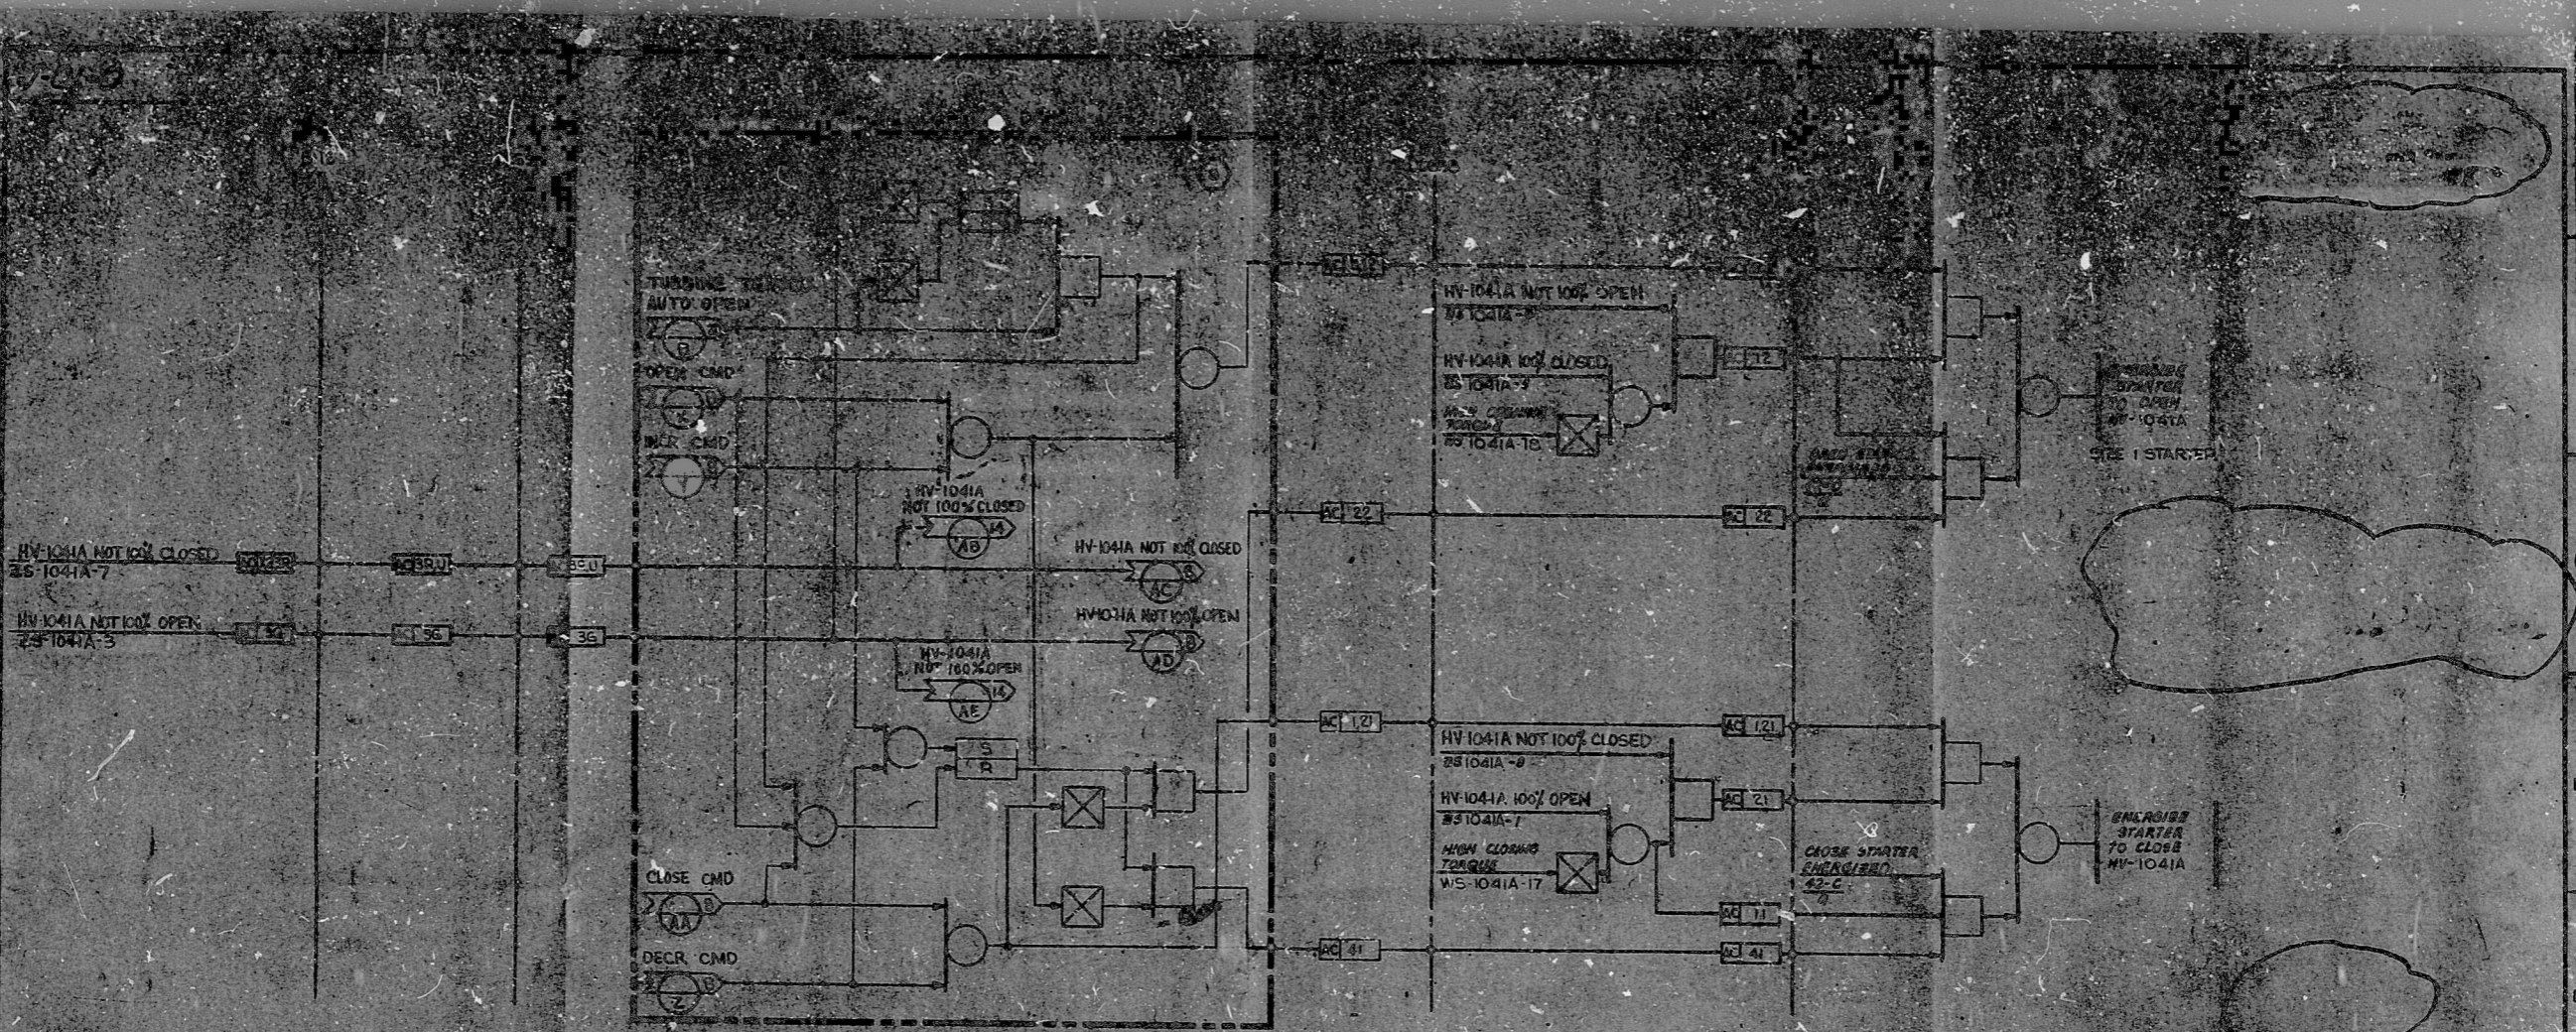

CROSS UNDER PIPE DRAIN VALVE HV-1041A

CROSS REFERENCE TABLE

VALVE	HAND SW (SHT. #)	LOGIC CABINET	T.C.	MCC	CIRCUIT NO.
HW1021A	HS1021	DC653	DC653	C112	9
HW1041D				E141	10
HW1022A				B112	11
HW1042D				B141	12
HW1023A				D112	13
				B101	
				D12	

P.R.C. APERTURE CARD

NO.	DESCRIPTION	DATE	BY
1	DESIGN		
2	CONSTRUCTION		
3			

22"
17"
11"
8.5"
7"
E
D
C
B
A

RIDS

830710258

