



J-01-0 SHZ 11

LOGIC CABINET DC655

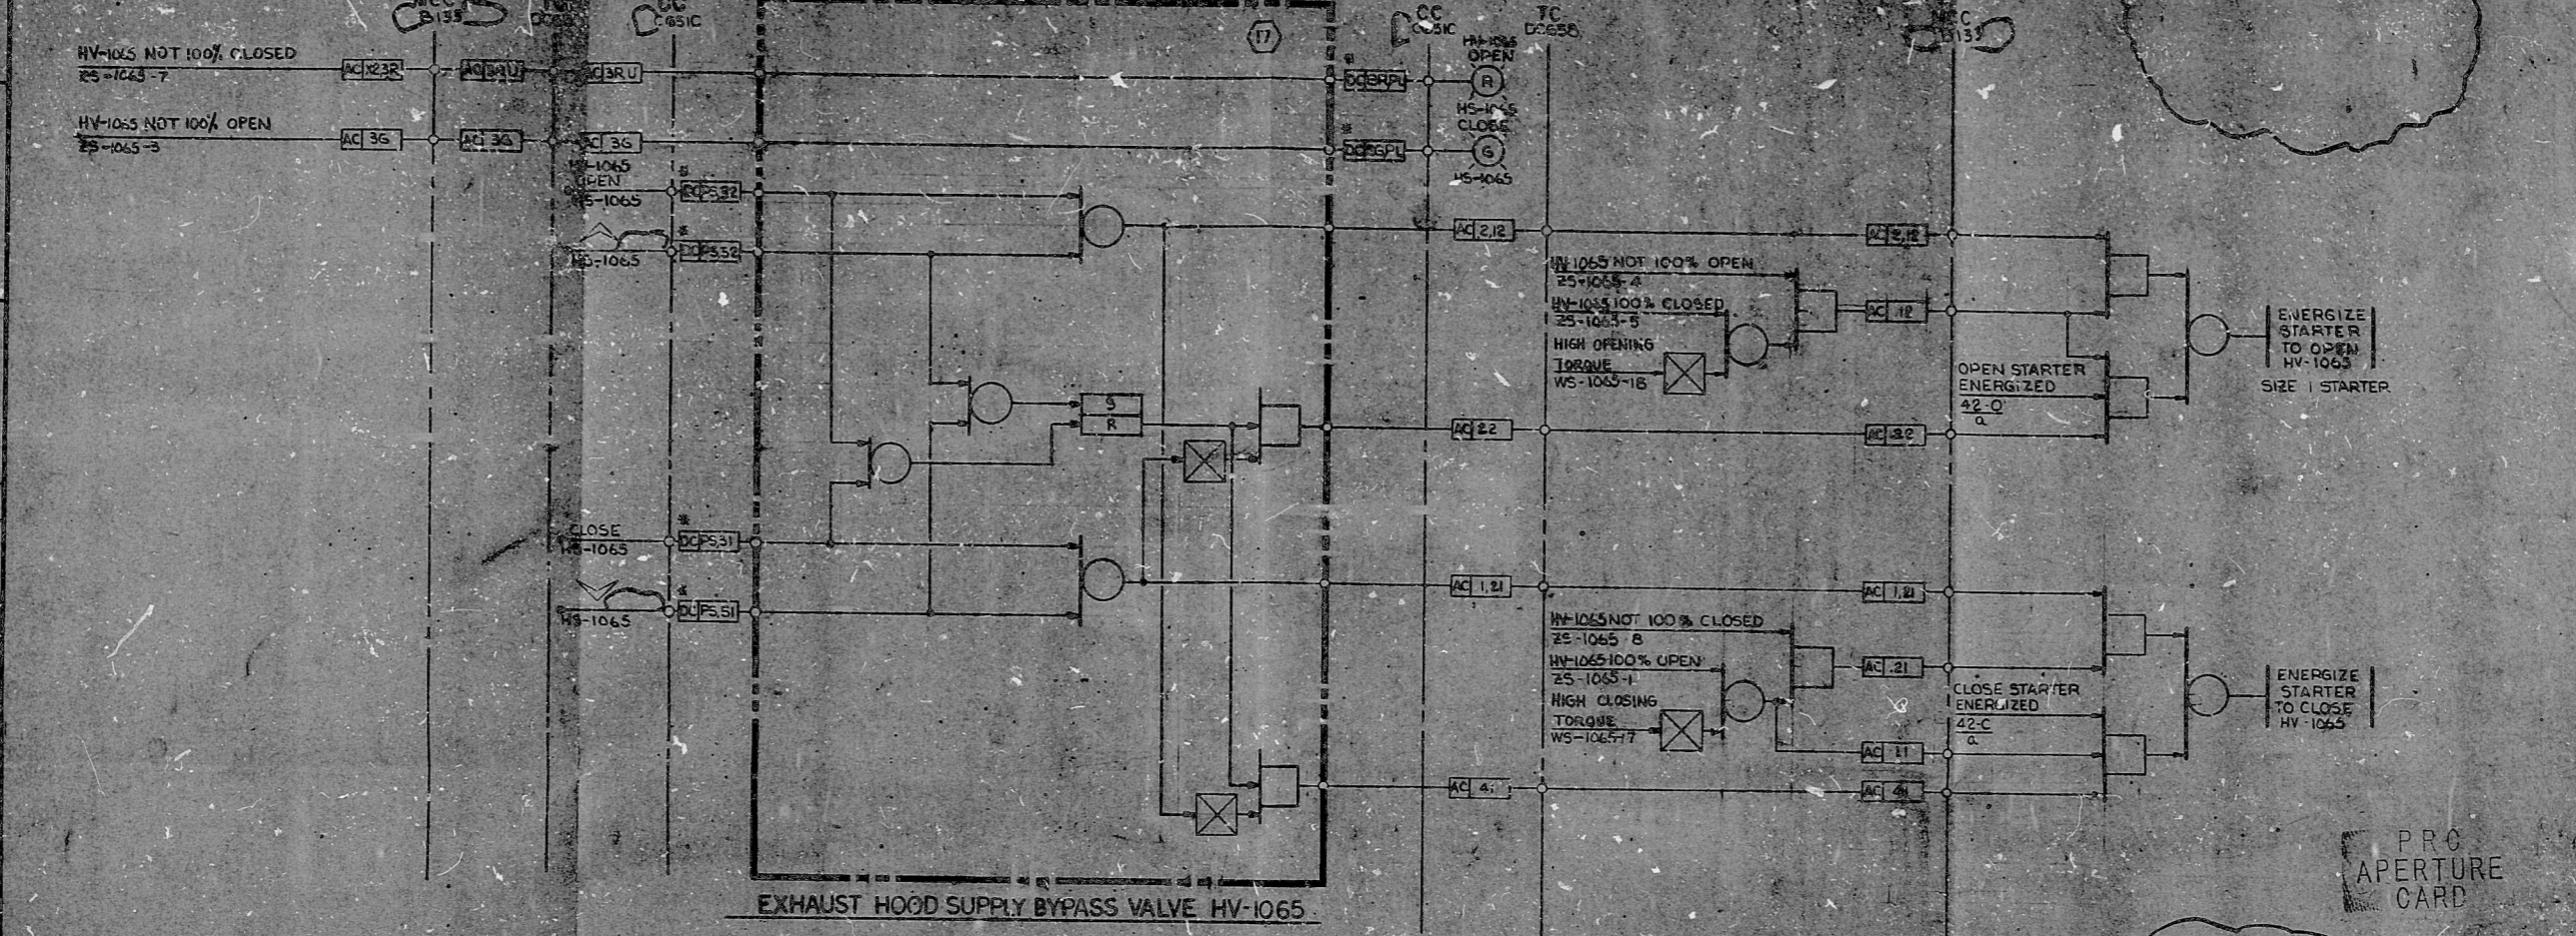

EXHAUST HOOD SUPPLY BYPASS VALVE HV-1065

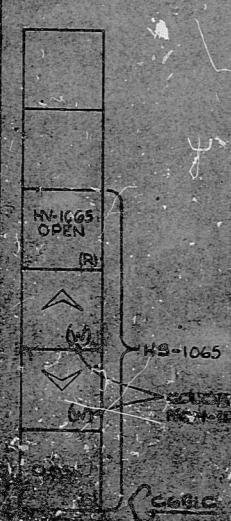

DESIGN FREEZE ISSUE	26		
REVISED BAILEY INTERFACE AS NOTED	48		
REVISED AS NOTED	62		
REVISED AS NOTED	62		
ISSUED FOR CONSTRUCTION	62		

BEKTEL
SAN FRANCISCO
ELECTRIC AND GAS DIVISION
PLANT 47370
LOGIC CABINET

22" 17" 11" 8.5" 8.5" 11" 17" 22"

RIDS

8307270263

