


J-02-0 SHT. 3

This drawing and the design it covers are the property of BECHTEL. They are merely loaned and on the borrower's express agreement that they will not be reproduced, copied, loaned, exhibited, nor used except in the limited way and private use permitted by any written consent given by the lender to the borrower.

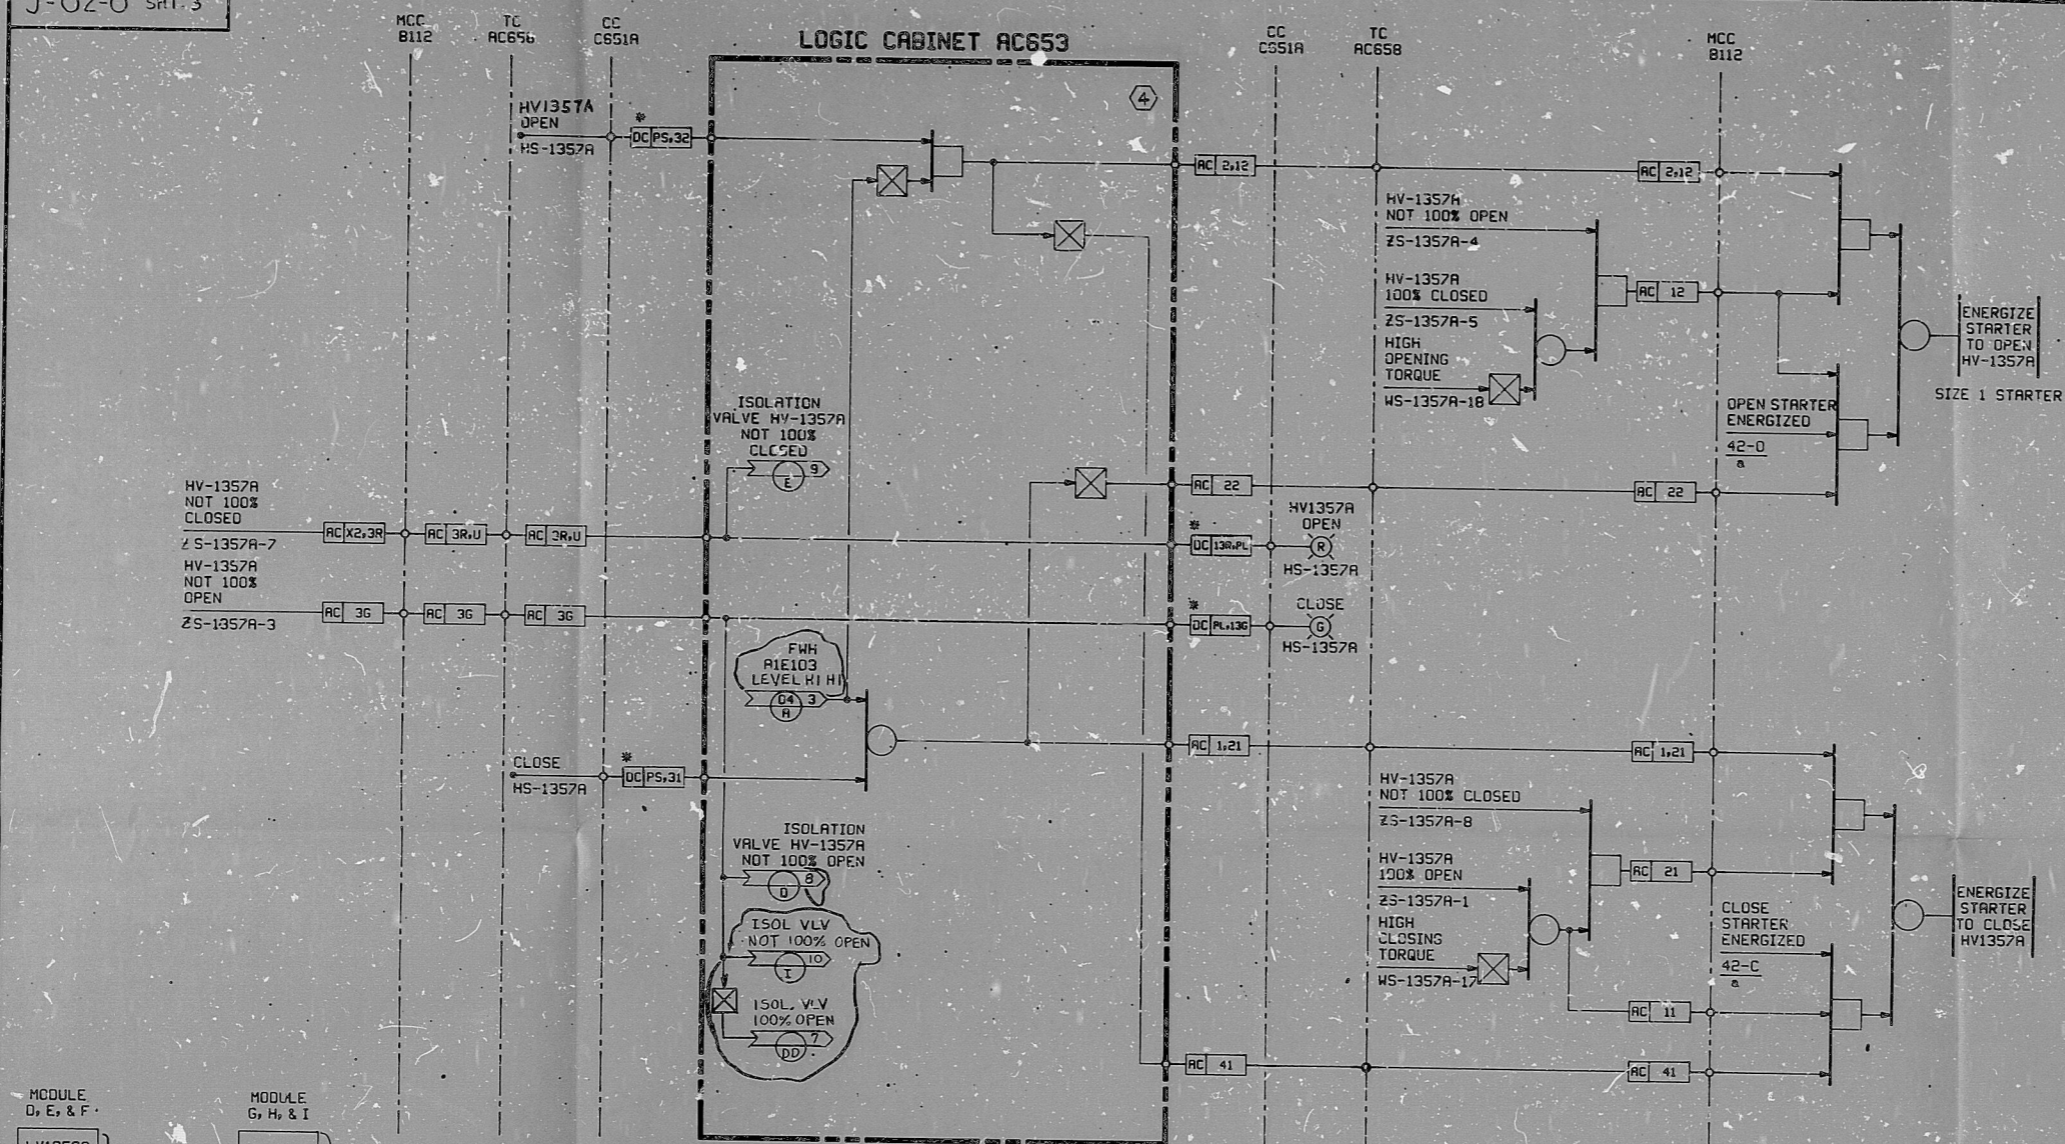

NOTES:

1. DELETES
2. CIRCUIT NUMBERS ORIGINATE ON THIS SHEET AND ALSO APPLY TO J-04-0 SHT. 8.

MODULE D, E, & F	MODULE G, H, & I
LV1356A ON (W)	SEC. 1 HS-1356A SEE SHT. 6
CLOSE (G)	SEC. 1 NOT USED
XV1374A OPEN (R)	SEC. 2 ZIL-1366A (SEE SHT. 10)
CLOSE (G)	SEC. 2 ZIL-1366A (SEE SHT. 10)
HV1357A OPEN (R)	SEC. 3 HS-1357A
CLOSE (G)	SEC. 3 HS-1357A
MONENTARY (G)	MONENTARY (G)

CROSS REFERENCE TABLE

SHELL EXTR. ISLN. VALVE	FWH	CONTROL SWITCH	ISLN. VLV. NOT 100% OPEN (ARROW D)	MCC	TC	LOGIC CAB.	CIRCUIT NO.	HAND SWITCH LAYOUT	ISOLATION VALVE 100% OPEN (ARROW I)
HV-1357A	R1E103	HS-1357A	J-04-0 SHT. 3 (ARROW A) FWH R1E103 SHT. 8	B112	AC658	AC653	4	D 3 3	
HV-1357B	B1E103	HS-1357B	J-04-0 SHT. 3 (ARROW A) FWH B1E103 SHT. 8	B141	BC658	BC653	5	E 3 3	
HV-1357C	C1E103	HS-1357C	J-04-0 SHT. 3 (ARROW A) FWH C1E103 SHT. 8	B122	CC658	CC653	6	F 3 3	
HV-1358A	A2E104	HS-1358A	J-04-0 SHT. 3 (ARROW A) FWH A2E104 SHT. 8	B112	AC658	AC653	7	K 3 4	
HV-1358B	B2E104	HS-1358B	J-04-0 SHT. 3 (ARROW A) FWH B2E104 SHT. 8	B141	BC658	BC653	8	L 3 4	
HV-1358C	C2E104	HS-1358C	J-04-0 SHT. 3 (ARROW A) FWH C2E104 SHT. 8	B122	CC658	CC653	9	M 3 4	
HV-1365A	A E106	HS-1365A	J-04-0 SHT. 8 (ARROW F) FWH A E106 SHT. 10	B142	AC658	AC653	10 (NOTE 2)	G 3 3	ARROW D, I
HV-1365B	B E106	HS-1365B	J-04-0 SHT. 8 (ARROW F) FWH B E106 SHT. 10	B123	BC658	BC653	11 (NOTE 2)	H 3 3	EE, I
HV-1365C	C E106	HS-1365C	J-04-0 SHT. 8 (ARROW F) FWH C E106 SHT. 10	B132	CC658	CC653	12 (NOTE 2)	I 3 3	FF, I

P.P.O. APERTURE CARD

NO.	DATE	REVISIONS	BY	CHKD.	DESIGN SUPV.	ENGR.	PROJ. ENGR.	APPR.
1	11/10/78	REVISED PER P1810/ISC VLV INTERLOCK CHANGED AND ASKED	AM	RB	RB	RB	RB	RB
2	11/14/78	DESIGN FREEZE ISSUE	TP	RB	RB	RB	RB	RB
3	10/17/78	REVISED BAILEY INTERFACE AS NOTED	AM	RB	RB	RB	RB	RB
4	11/17/78	REVISED AS NOTED	RB	RB	RB	RB	RB	RB
5	11/17/78	REVISED AS NOTED	RB	RB	RB	RB	RB	RB
6	11/17/78	ISSUED FOR CONSTRUCTION	S	I	C	N	E	D

BECHTEL
SAN FRANCISCO

PUBLIC SERVICE ELECTRIC AND GAS COMPANY
HCP E CREEK GENERATING STATION

LOGIC DIAGRAM
EXTRACTION STEAM
HEATERS 3, 4, & 6 ISOLATION VALVES

JOB No.	DRAWING No.	REV.
18855	J-02-0	SHT. 3

S/U - AF

RIDS

8307270271

