


J-02-0 SHT. 4


This drawing and the design it covers are the property of BECHTEL. They are hereby loaned, not sold, to the borrower's express agreement that they will not be reproduced, copied, loaned, exhibited, nor used except in the limited way and private use permitted by any written consent given by the lender to the borrower.

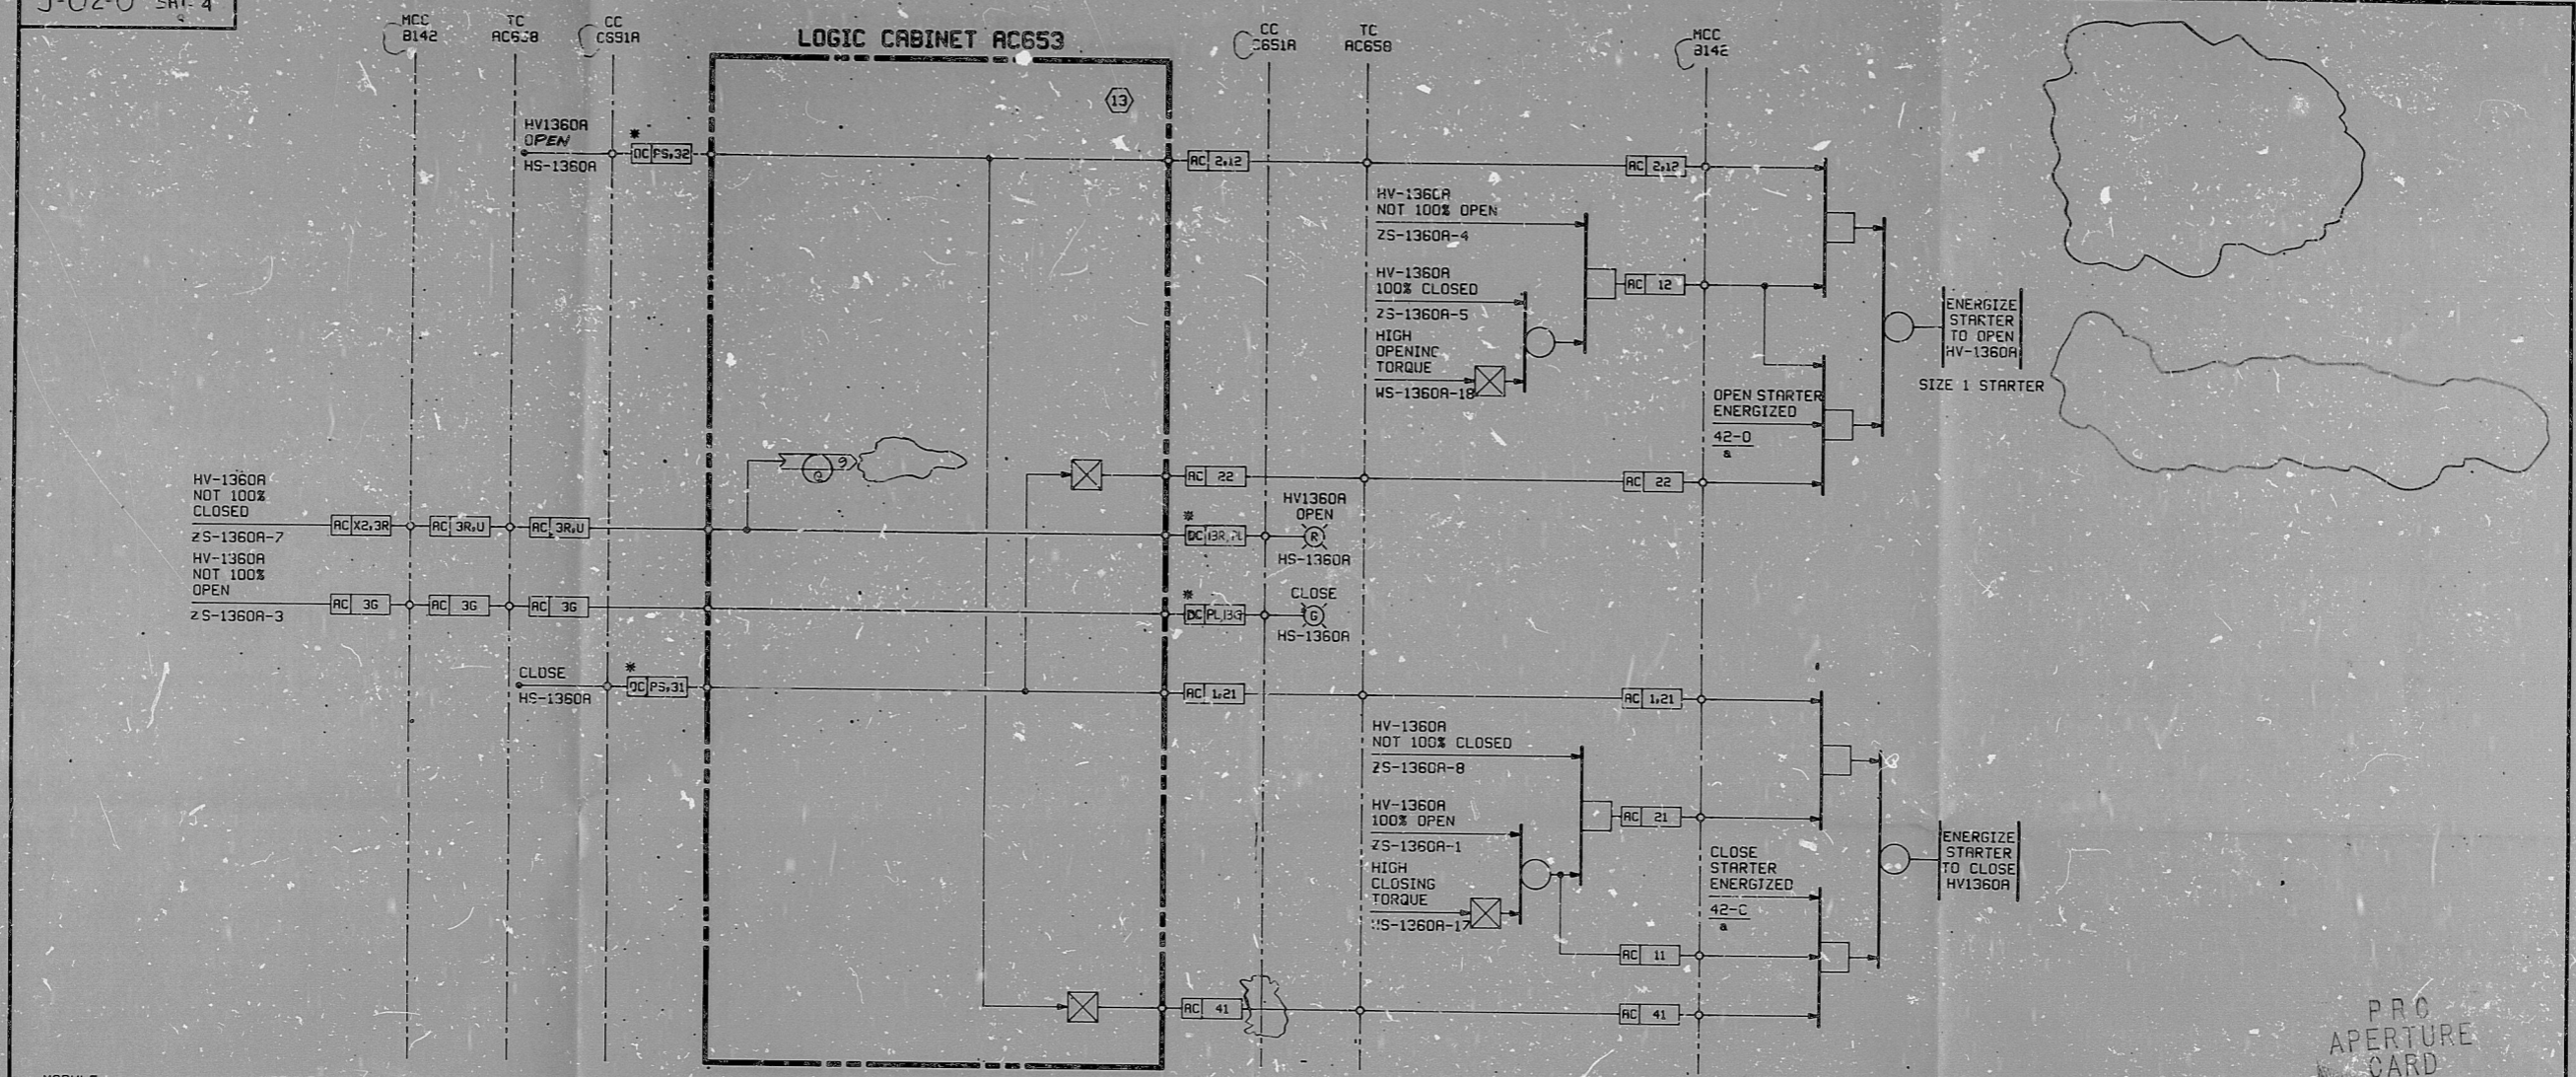

FWH-A3E105 SHELL ISOLATION VALVE HV-1360A  
MSTR, SEP. B DRAIN ISOLATION

CROSS REFERENCE TABLE

SERVICE	VALVE NO.	CONTROL SWITCH	CIRCUIT NO.	MCC	TC	LOGIC CAB.	S/U SYSTEM	HAND SWITCH LAYOUT	AKROW Q
FWH-A3E105 SHELL ISLN. VALVE MSTR, SEP. B DRAIN ISLN.	HV-1360A	HS-1360A	13	B142	AC658	AC653	AC	A 2 2	SHT. 2
FWH-A3E105 SHELL ISLN. VALVE MSTR, SEP. A DRAIN ISLN.	HV-1361A	HS-1361A	14	B142	AC658	AC653	AC	A 1 2	
FWH-B3E105 SHELL ISLN. VALVE MSTR, SEP. B DRAIN ISLN.	HV-1360B	HS-1360B	15	B123	BC658	BC653	AC	B 2 2	
FWH-B3E105 SHELL ISLN. VALVE MSTR, SEP. A DRAIN ISLN.	HV-1361B	HS-1361B	16	B123	BC658	BC653	AC	B 1 2	
FWH-C3E105 SHELL ISLN. VALVE MSTR, SEP. B DRAIN ISLN.	HV-1360C	HS-1360C	17	B132	CC658	CC653	AC	C 2 2	
FWH-C3E105 SHELL ISLN. VALVE MSTR, SEP. A DRAIN ISLN.	HV-1361C	HS-1361C	18	B132	CC658	CC653	AC	C 1 2	
FWH #3 A, B, & C SHELL MOTOR ASSIST BTV TO FWH #3B	XV-1374A	HS-1374A	33	B112	AC658	AC653	AF	D 2 3	SPARE
MOTOR ASSIST BTV TO FWH #3B	XV-1374B	HS-1374B	34	B141	BC658	BC653	AF	E 2 3	
MOTOR ASSIST BTV TO FWH #3C	XV-1374C	HS-1374C	35	B122	CC658	CC653	AF	F 2 3	
MOTOR ASSIST BTV TO FWH #4A	XV-1375A	HS-1375A	36	B112	AC658	AC653	AF	K 2 4	
MOTOR ASSIST BTV TO FWH #3B	XV-1375B	HS-1375B	37	B141	BC658	BC653	AF	L 2 4	
MOTOR ASSIST BTV TO FWH #4C	XV-1375C	HS-1375C	38	B122	CC658	CC653	AF	H 2 4	

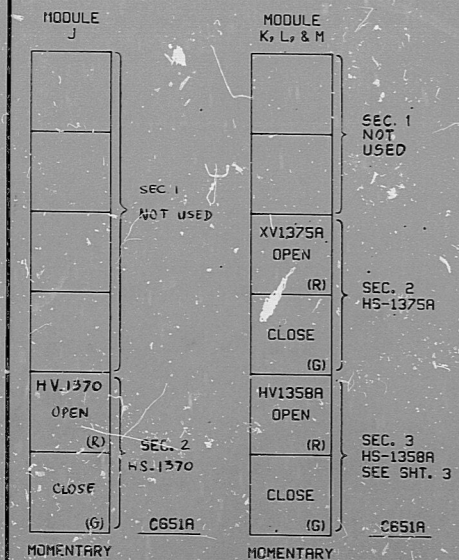

P.A.C. APERTURE CARD

DESIGN FREEZE ISSUE	7P	20/1/80	10/1/80	10/1/80	10/1/80	
CHANGED TITLE	10/1/80	10/1/80	10/1/80	10/1/80	10/1/80	
REVISED AS NOTED	10/1/80	10/1/80	10/1/80	10/1/80	10/1/80	
ISSUED FOR CONSTRUCTION	5/1/80	5/1/80	5/1/80	5/1/80	5/1/80	
NO.	DATE	DESIGNED	BY	CHKD	ENGR	APPD
SCALE	NONE	DESIGNED	CHS	DRAWN	RCG	
<b>BECHTEL</b> SAN FRANCISCO						
PUBLIC SERVICE ELECTRIC AND GAS COMPANY HOPE CREEK GENERATING STATION						
LOGIC DIAGRAM EXTRACTION STEAM MISCELLANEOUS MOTOR OPERATED VALVES						
JOB No.	DRAWING No.	REV.				
10855	J-02-0	SHT. 4	3			

S/U - AC, AF, CA



RIDS

8307270272

