


J-02-0 SH. 5

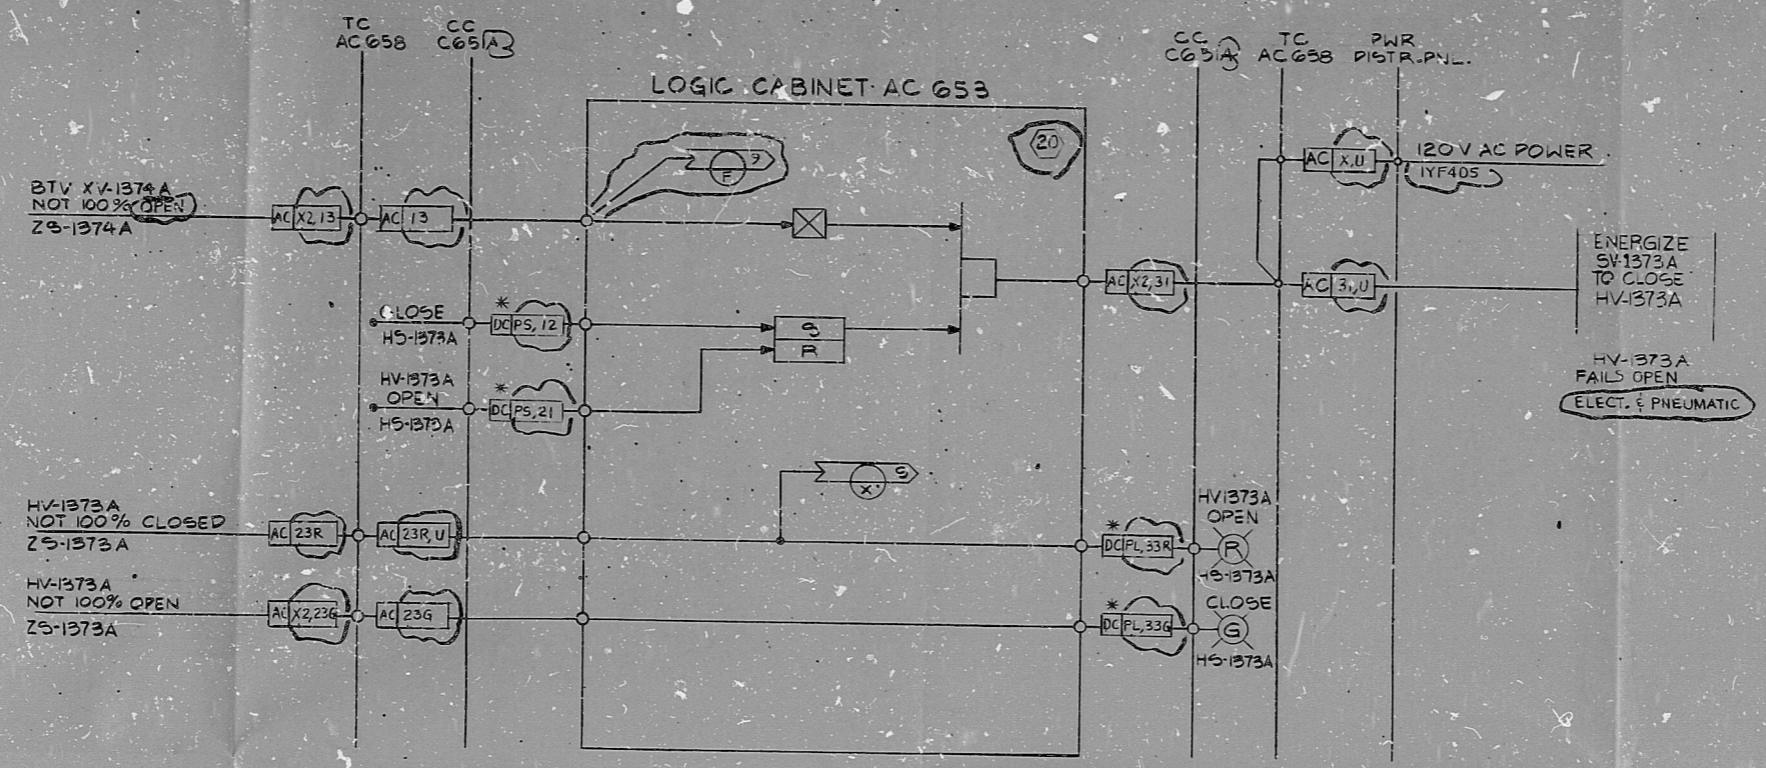

TURB. 9TH STAGE EXTRACTION STEAM LINE DRAIN VALVE HV-1373A

MODULE NO. P, V, H, & X

	SEC. 1 NOT USED
HV-1373A OPEN (R)	SEC. 2 HV-1373A
CLOSE (G)	
HV-1388A OPEN (R)	SEC. 3 HV-1388A SEE SHT. 6
CLOSE (G)	

MOMENTARY C651A

CROSS REFERENCE TABLE

SERVICE DESCRIPTION	DRN VLV	SOL VAL	HAND SWITCH	POSITION SWITCH	BLEEPER TRIP VLV		TC	LC	POWER DIST. PNL	CIRCUIT NO.	SWITCH		
					VALVE	POS. SW.					MODULE	SEC	SHT
TURB. 9TH STAGE XSTM DRN	HV-1373 A	SV-1373 A	HS-1373A	ZS-1373A	XV-1374 A	ZS-1374 A	AC 658	AC 653	YF405	20	N	2	5
							BC 658	BC 653	YF405	21	O	2	5
							CC 658	CC 653	YF405	22	P	2	5
							AC 658	AC 653	YF405	23	V	2	5
							BC 658	BC 653	YF406	24	W	2	5
							CC 658	CC 653	YF407	25	X	2	5

PRC APERTURE GARD

NO.	DATE	REVISIONS	BY	CHKD	APPD
1		REVISED PER P110 CHANGE, REVISED CWT & KNP AS NOTED	MA	TD	PA
2		DESIGN FREEZE ISSUE, REWRAN	7P	SS	PA
3		REVISE BAILEY INTER. AS NOTED			
4		REVISED AS NOTED			
5		REVISED AS NOTED			
6		REVISED AS NOTED			
7		ISSUED FOR CONSTRUCTION			

**BECHTEL**  
SAN FRANCISCO

PUBLIC SERVICE ELECTRIC AND GAS COMPANY  
MCPE CREEK GENERATING STATION

LOGIC DIAGRAM  
EXTRACTION STEAM  
TURB. 9TH STAGE XSTM LINE DRAIN VLV

JOB NO.	DRAWING NO.	REV.
10855	J-02-0 SH. 5	5

S/U-AF

RIDS

8307270278

