


J-02-0 SHT. 6

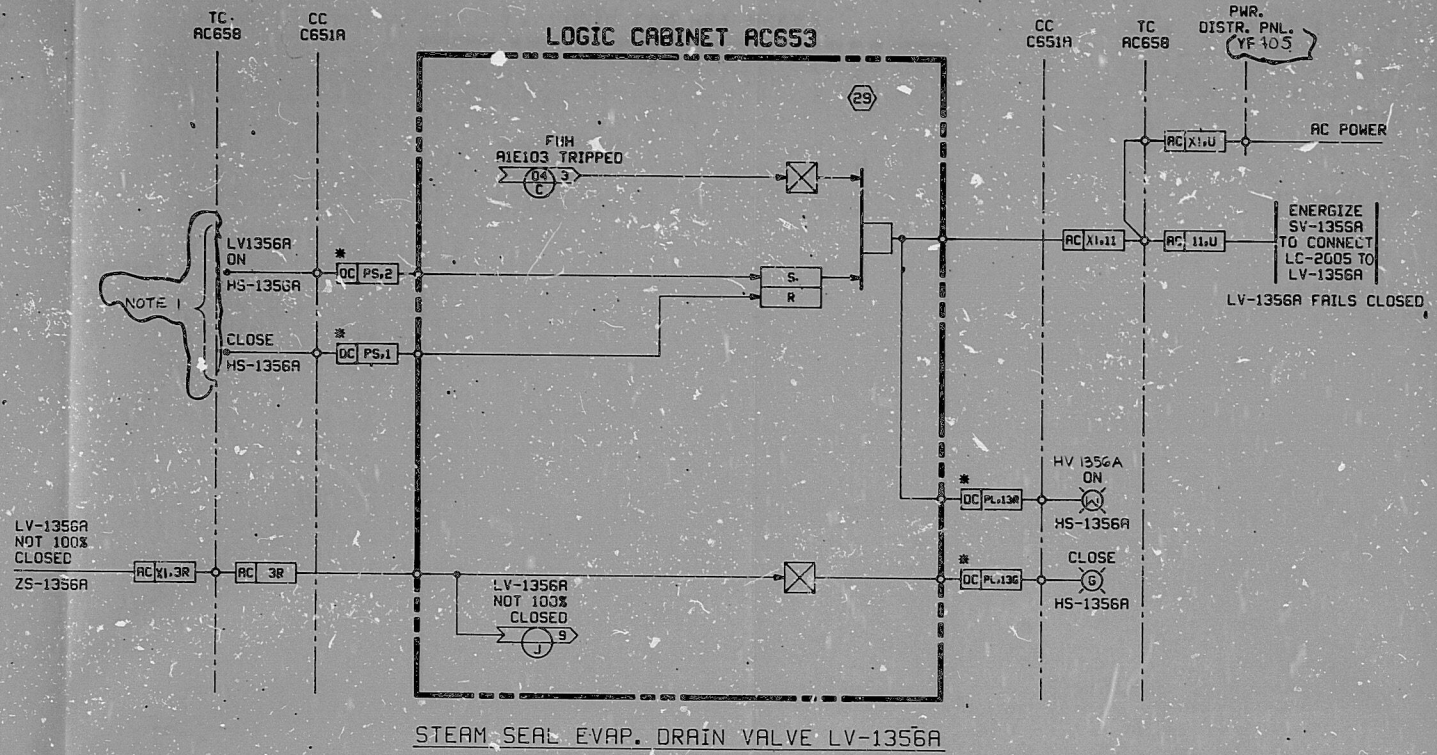

NOTE:  
1. SWITCH ARRANGEMENT SHOWN ON SHT. 3

This drawing and the design it covers are the property of BECHTEL. They are hereby loaned and on the borrower's express agreement that they will not be reproduced, copied, loaned, exhibited, nor used except in the limited way and private use permitted by any written consent given by the borrower.

CROSS REFERENCE TABLE

SSE DRAIN VALVE	SOLENOID VALVE	CONTROL SWITCH	POSITION SWITCH	FWH	TC	LOGIC CABINET	POWER DISTR. PANEL	CIRCUIT NO.	HAND SWITCH LAYOUT	FWH TRIPPED		
									MODULE	SEC	SHT.	
LV-1356A	SV-1356A	HS-1356A	ZS-1356A	A1E103	AC658	AC653	1405	29	D	1	3	J-04-0 SHT 3 ARROW (C)
LV-1356B	SV-1356B	HS-1356B	ZS-1356B	B1E103	BC658	BC653	1406	30	E	1	3	J-04-0 SHT 3 ARROW (C)
LV-1356C	SV-1356C	HS-1356C	ZS-1356C	C1E103	CC658	CC653	1407	31	F	1	3	J-04-0 SHT 3 ARROW (C)

PRO APERTURE CARD

1/14/82	REVISED ENR. DISTR. PNL.	11U	20	30	30	30	30	30	30	30	30	30
1/21/82	DESIGN FREEZE ISSUE	7P	20	30	30	30	30	30	30	30	30	30
1/21/82	REVISED AS NOTED	RB	20	30	30	30	30	30	30	30	30	30
1/14/82	REVISED AS NOTED	RB	20	30	30	30	30	30	30	30	30	30
1/14/82	ISSUED FOR CONSTRUCTION	S	G	N	E	D						

SCALE: NONE DESIGNED: CHS DRAWN: RCG

**BECHTEL**  
SAN FRANCISCO

PUBLIC SERVICE ELECTRIC AND GAS COMPANY  
HOPE CREEK GENERATING STATION

LOGIC DIAGRAM  
EXTRACTION STEAM  
STEAM SEAL EVAP. DRAIN CONTROL VALVES

JOB No.	DRAWING No.	REV.
10855	J-02-0	SHT 6 4

S/U - AF



RIDS

8307270277

