

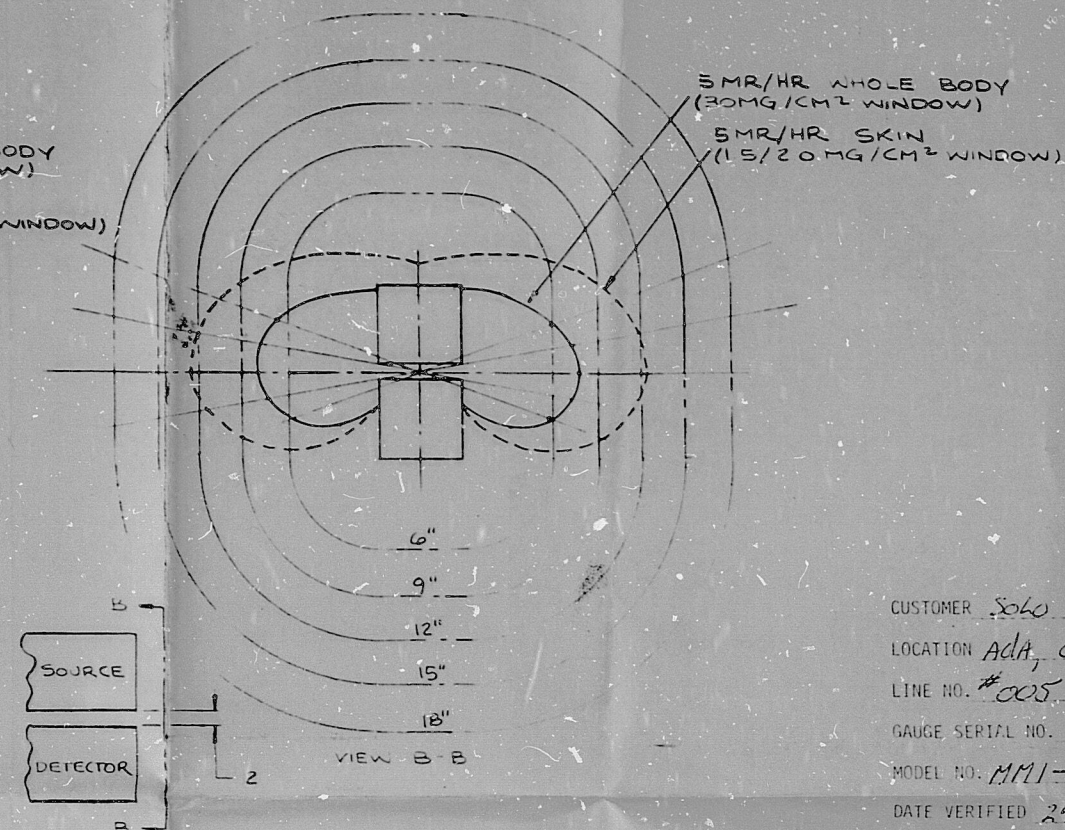


DO NOT SCALE

REV
A - REDRAWN

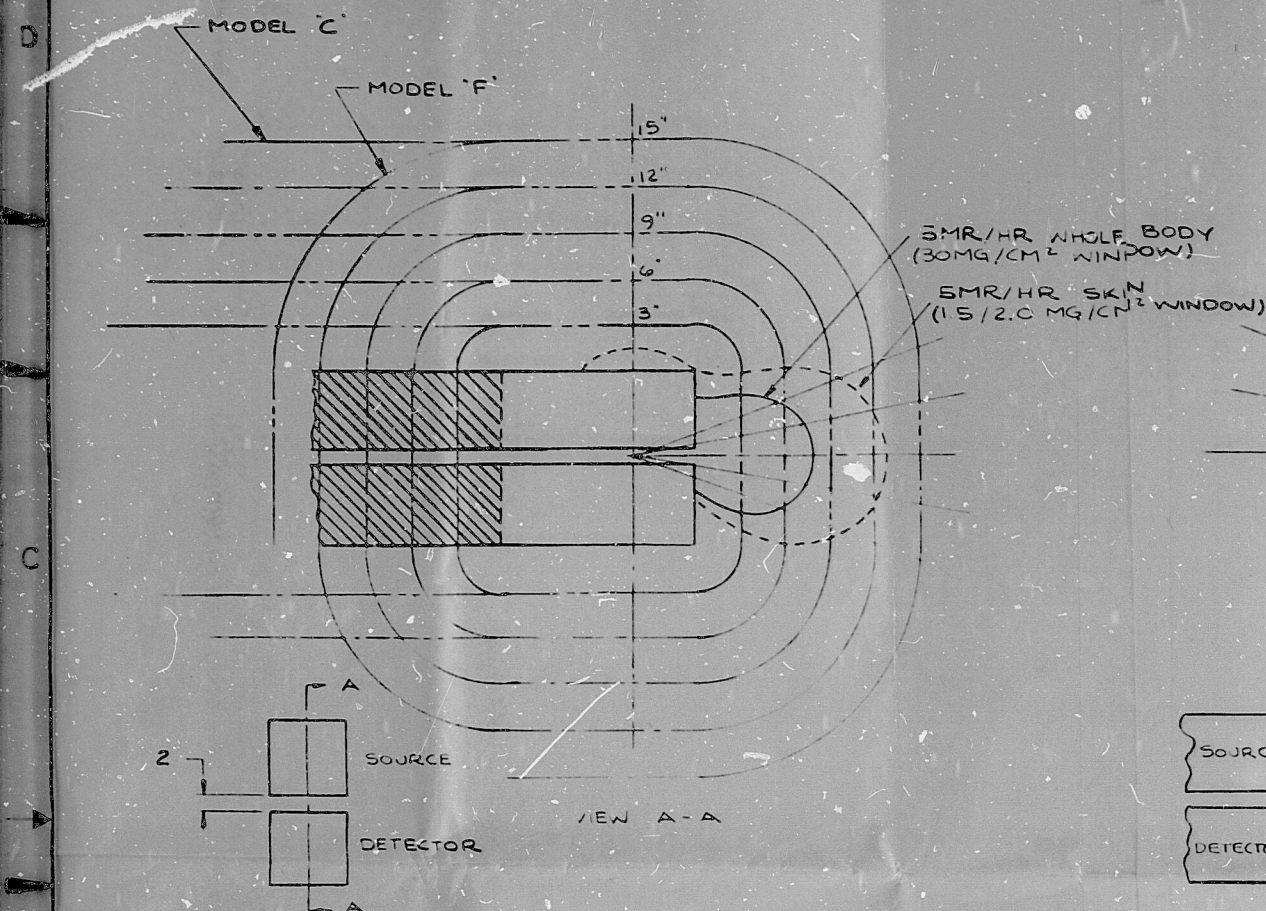

CUSTOMER: SOLO CUP
LOCATION: ADA, OK.
LINE NO. #005
GAUGE SERIAL NO. 8147 Source Serial No. 178
MODEL NO. MM1-FL-SR-60-ST-6P
DATE VERIFIED 24 August 1984
INDEV CONTROL SYSTEMS, INC.
RIRCA LIC. NO. 33-004-02

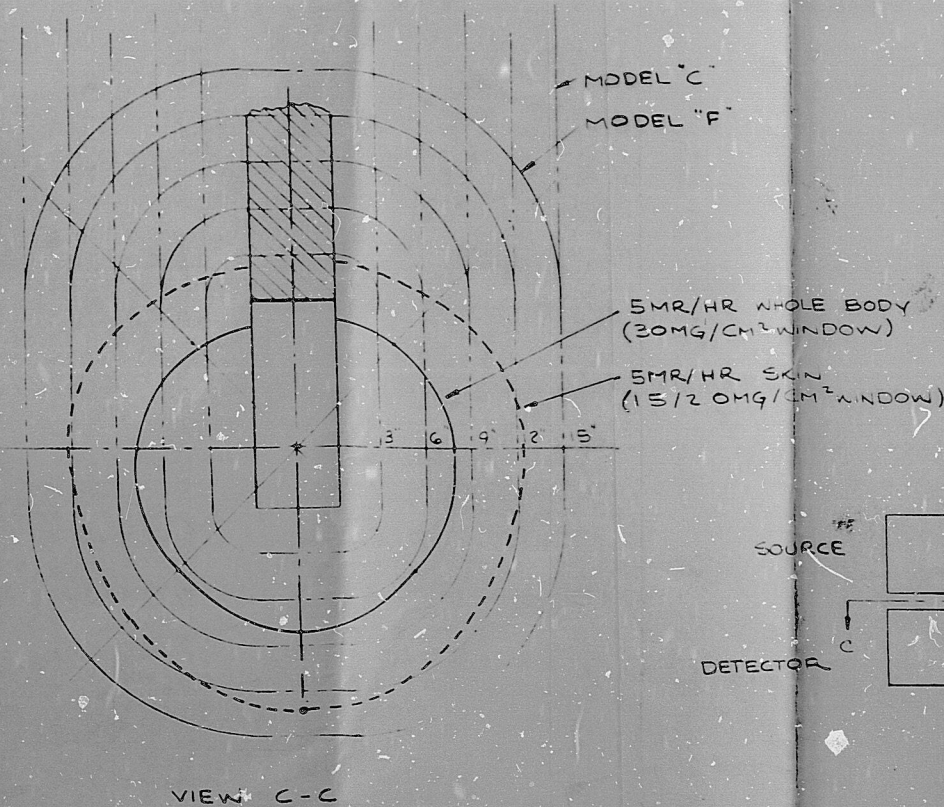

SOURCE: 100mCi STRONTIUM 90
BETAMIKE MODEL 'Y' OR 'F' WITH HOLDER 015030
SHADED SECTIONS ARE PART OF MODEL 'Y' ONLY
COUNTER: NUCLEAR CHICAGO # 2650-56
WITH SOURCE CLOSED MAX LEVEL AT
ANY SURFACE = 12 Mr/hr

TI
APERTURE
CARD

8412070020

DRAWN J DJNN	TITLE RADIATION PROFILE SR90
DATE 12-20-77	
DESIGN	DWG NO
DEV	009023
CHECKED	REV
DRAFT	1A
	SHEET 1 OF 1

60390

PDR RIDS

8412070020

