



J-04-0 3m 2

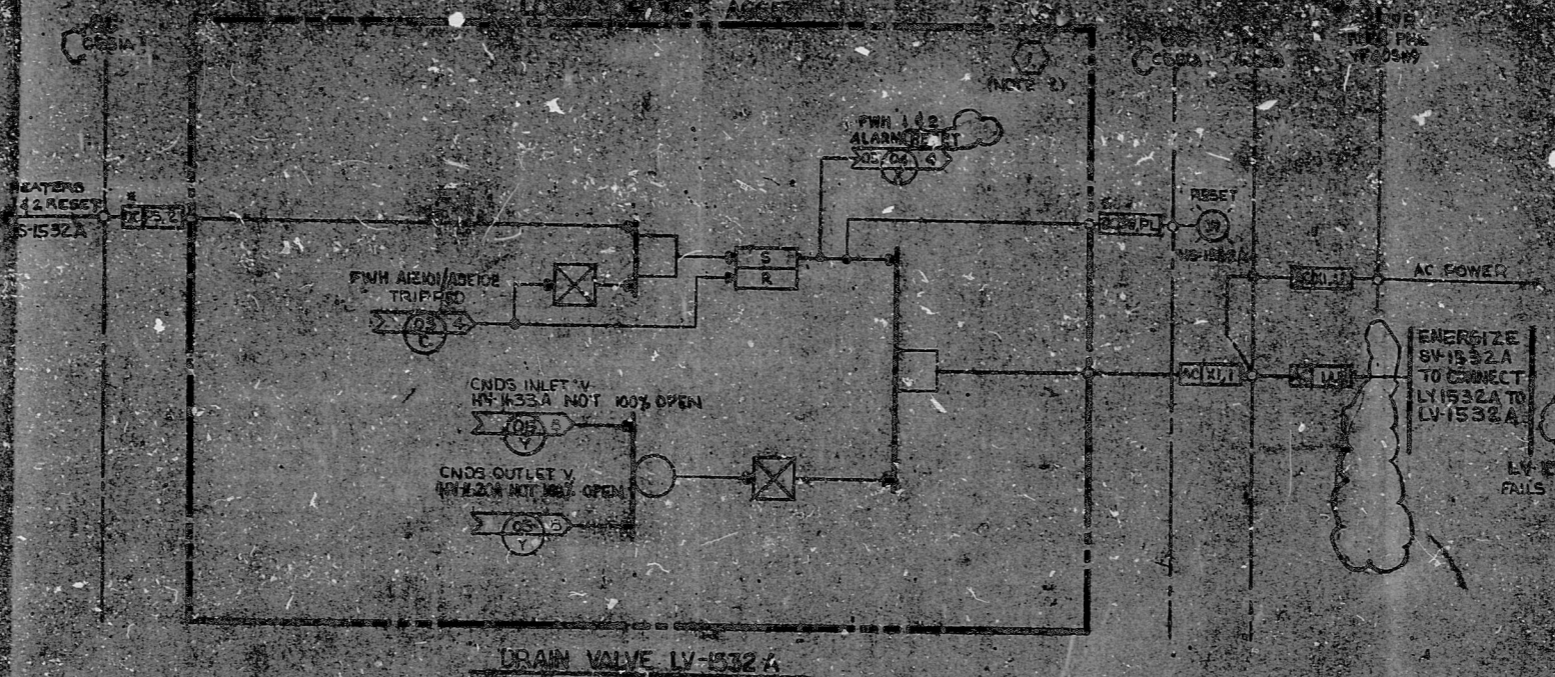

NOTES:
 1. THESE SWITCH CONTACTS OPEN UPON THE CONDITION STATED.
 2. CIRCUIT NUMBERS ALSO APPLY TO 3-03 SHIT 4

CROSS REFERENCE TABLE

FWH	DRAIN VALVE	SOLENOID VALVE	RESET SW	FWH TRIPPED	CNDS V. NOT 100% OPEN		CIRCUIT NO. (NOTE 2)	CC	TC	LOGIC CABINET	FUSE/PWL & FUSE NO.	HARD SWITCH LAYOUT			
					INLET	OUTLET						MODULE	FUNCTION	PWG.	SHIT
AE103	LV-1532A	SV-1532A	HS-1532A	AE101/ABORT	HV-1532A	HV-1532A	1	CC651A	AC250	AC653	YF405#3	M	2	J-03	
BE103	LV-1532A	SV-1532A	HS-1532A	BE101/ABORT	HV-1532A	HV-1532A	2		EC830	EC653	YF406#9	M	4	J-03	
CE103	LV-1532A	SV-1532A	HS-1532A	CE101/ABORT	HV-1532A	HV-1532A	3		CC653	CC653	YF407#8	M	6	J-03	

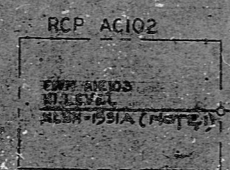

FWH	LEVEL SWITCH	SOLENOID VALVE	SUMP LINE CONTROL VALVE	REP	POWER
AE103	KS-1531A	SV-1531A	LV-1531A	AC20P	AC200
BE103	KS-1531B	SV-1531B	LV-1531B	AC20P	AC200
CE103	KS-1531C	SV-1531C	LV-1531C	AC20P	AC200

LEVEL SWITCH TRIP OPEN

RIDS

830T270328

