


J-11-0 SHT. 15


This drawing and the design it covers, are the property of BECHTEL. They are hereby loaned to the borrower's express agreement that they will not be reproduced, copied, loaned, exhibited, or used except in the limited way and private use permitted by any written consent given by the lender to the borrower.

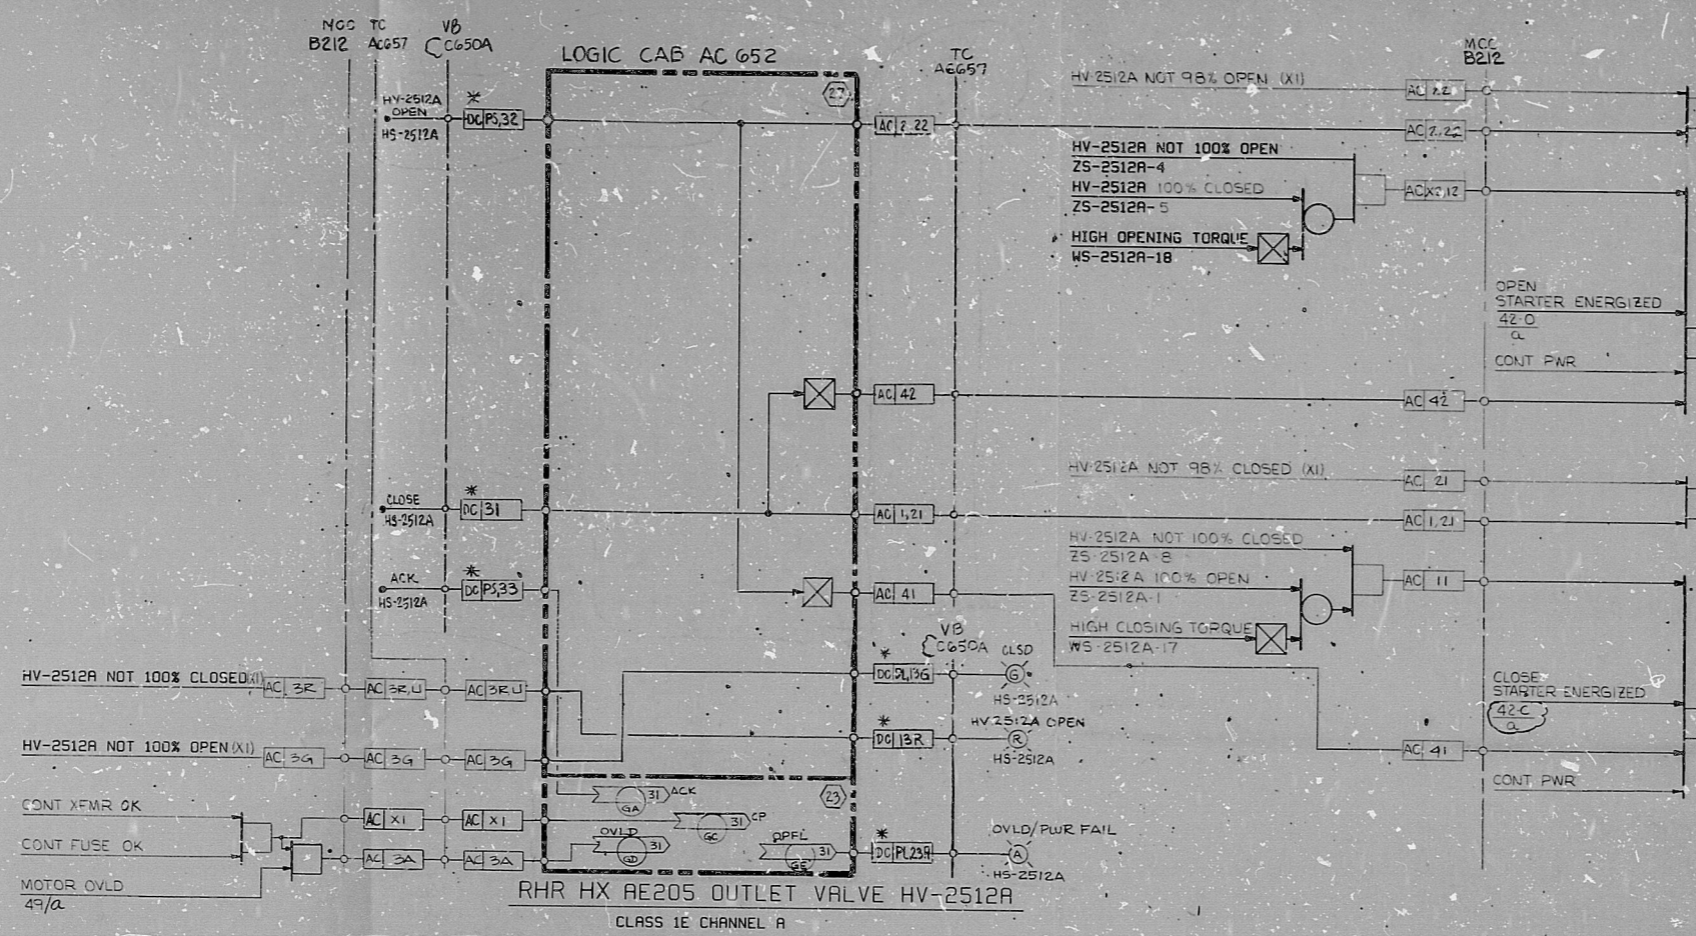

- NOTES:
1. 120VAC PWR IS FROM PUMP SEAL & MOTOR BRG. CLG. WTR. SUPPLY VALVE.
 2. CONTACT OPENS ON CONDITION STATED.
 3. LOGIC 'AND' MUST BE HARD-WIRED.

CROSS REFERENCE TABLE

PUMP NO.	SERVICE	DIFF. PRESS. SW.	LOGIC CABINET	VALVE NO.	CKT. NO.
AP202	PUMP SEAL CLR	PD5HL-2533A	AC652	HV-2520A	19
BP202	MOTOR BRG. CLR	-2510A	BC652	HV-2520B	20
CP202	PUMP SEAL CLR	-2530B	CC652	HV-2520C	21
DP202	MOTOR BRG. CLR	-2510C	DC652	HV-2520D	22

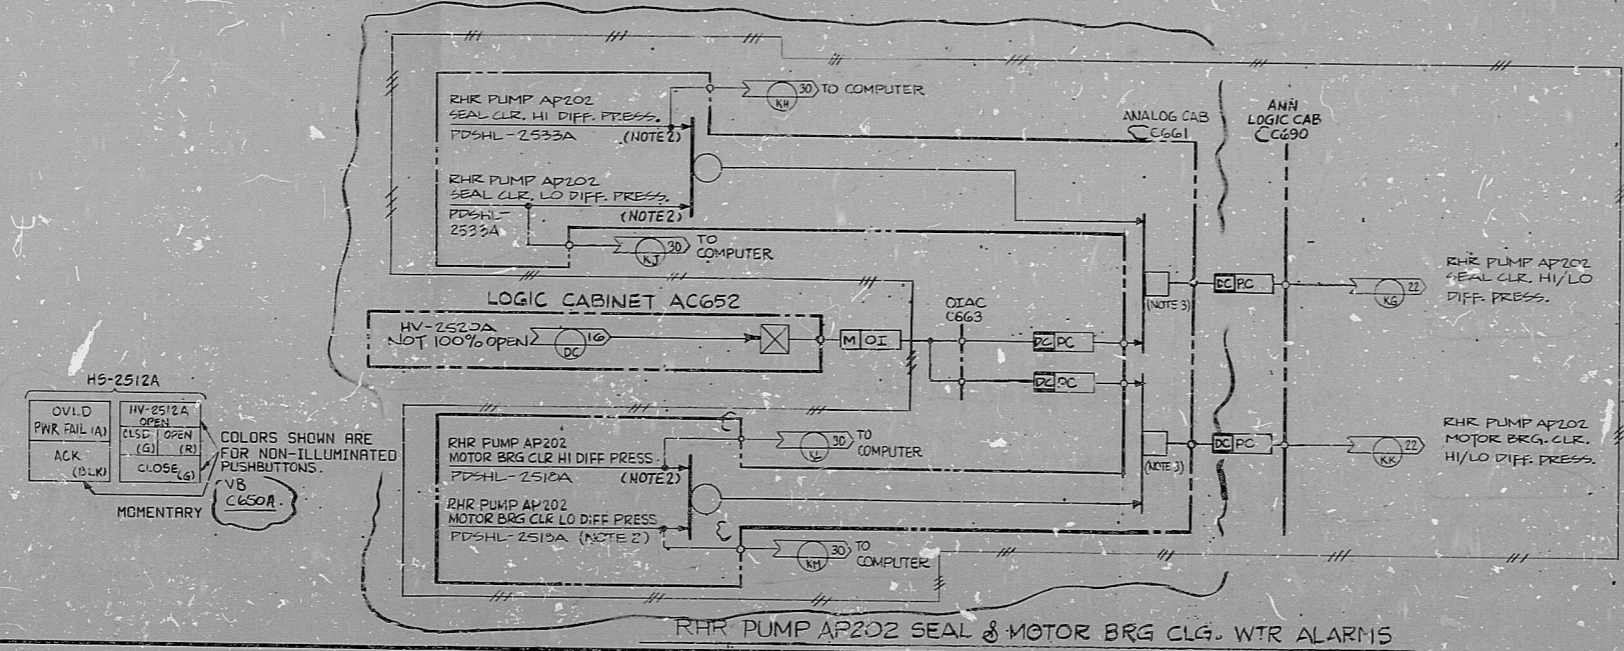

PRO APERTURE CARD

NO.	DATE	REVISIONS	BY	CHKD	DESIGN	ENGR	PROJ. APPR.
1	1/12	DESIGN FREEZE ISSUE					
2	7/24/71	REVISED BAILEY INTERFACE AND AS NOTED					
3	9/11/71	INC DCN #					
4	11/1/71	REVISED AS NOTED					
5	3/16/77	ISSUED FOR CONSTRUCTION					

BECHTEL
SAN FRANCISCO

PUBLIC SERVICE ELECTRIC AND GAS COMPANY
HOPE CREEK GENERATING STATION

LOGIC DIAGRAM
SAFETY AUXILIARIES COOLING
RHR HX AE205 OUTLET V. SEAL & BRG. CLG. WTR. ALARMS

JOB No.	DRAWING No.	REV.
10855	J-11-0 SHT 15	4 Q

S/U-EG

11776 MOD-1-NOV-70-203

RIDS

8307270379

